
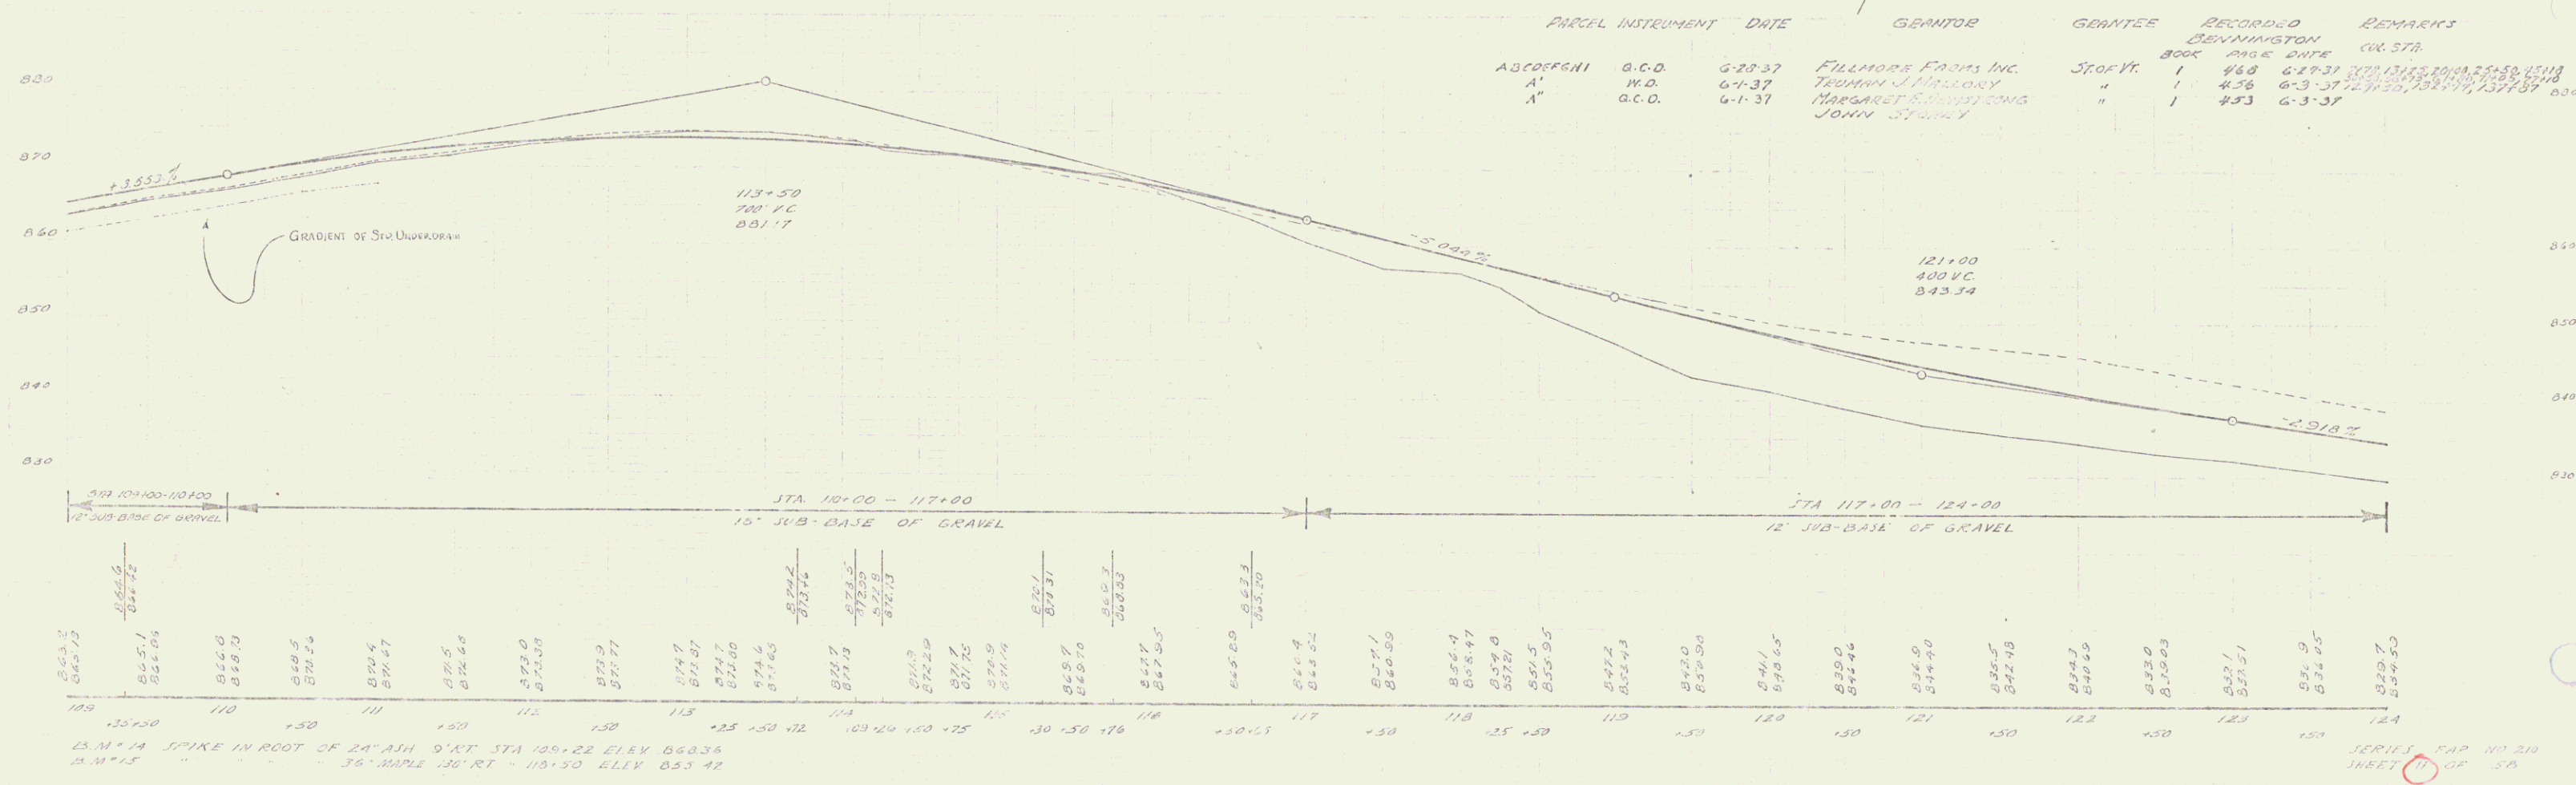


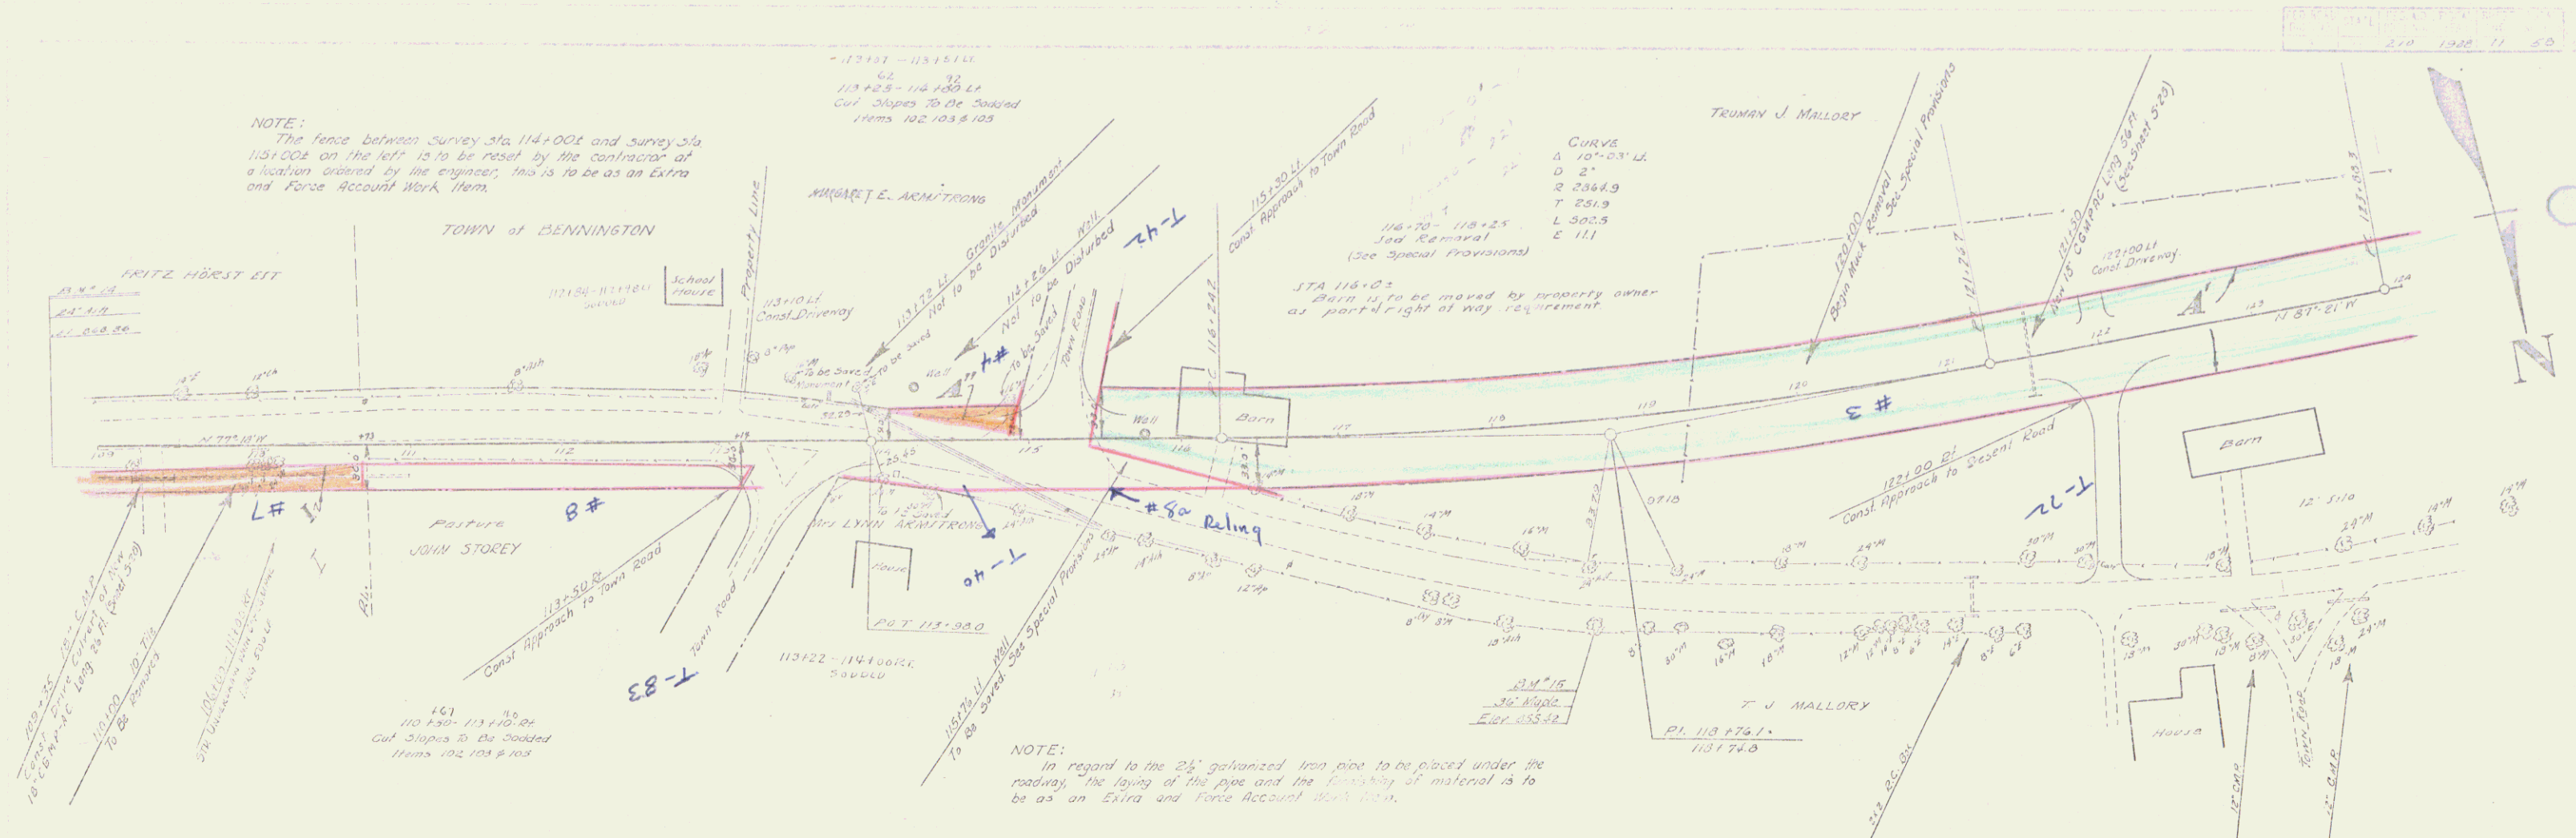

PARCEL	INSTRUMENT	DATE	GRANTOR	GRANTEE	RECORDED	REMARKS
ABCD EFGHI	O.C.O.	6-28-37	FILLMORE FARM, INC.	STOF. V.	468	6-28-37
A'	M.O.	6-1-37	TRUMAN J. MALLORY	"	456	6-1-37
A''	O.C.O.	6-1-37	MARGARET E. ARMITTAGE	"	453	6-1-37