



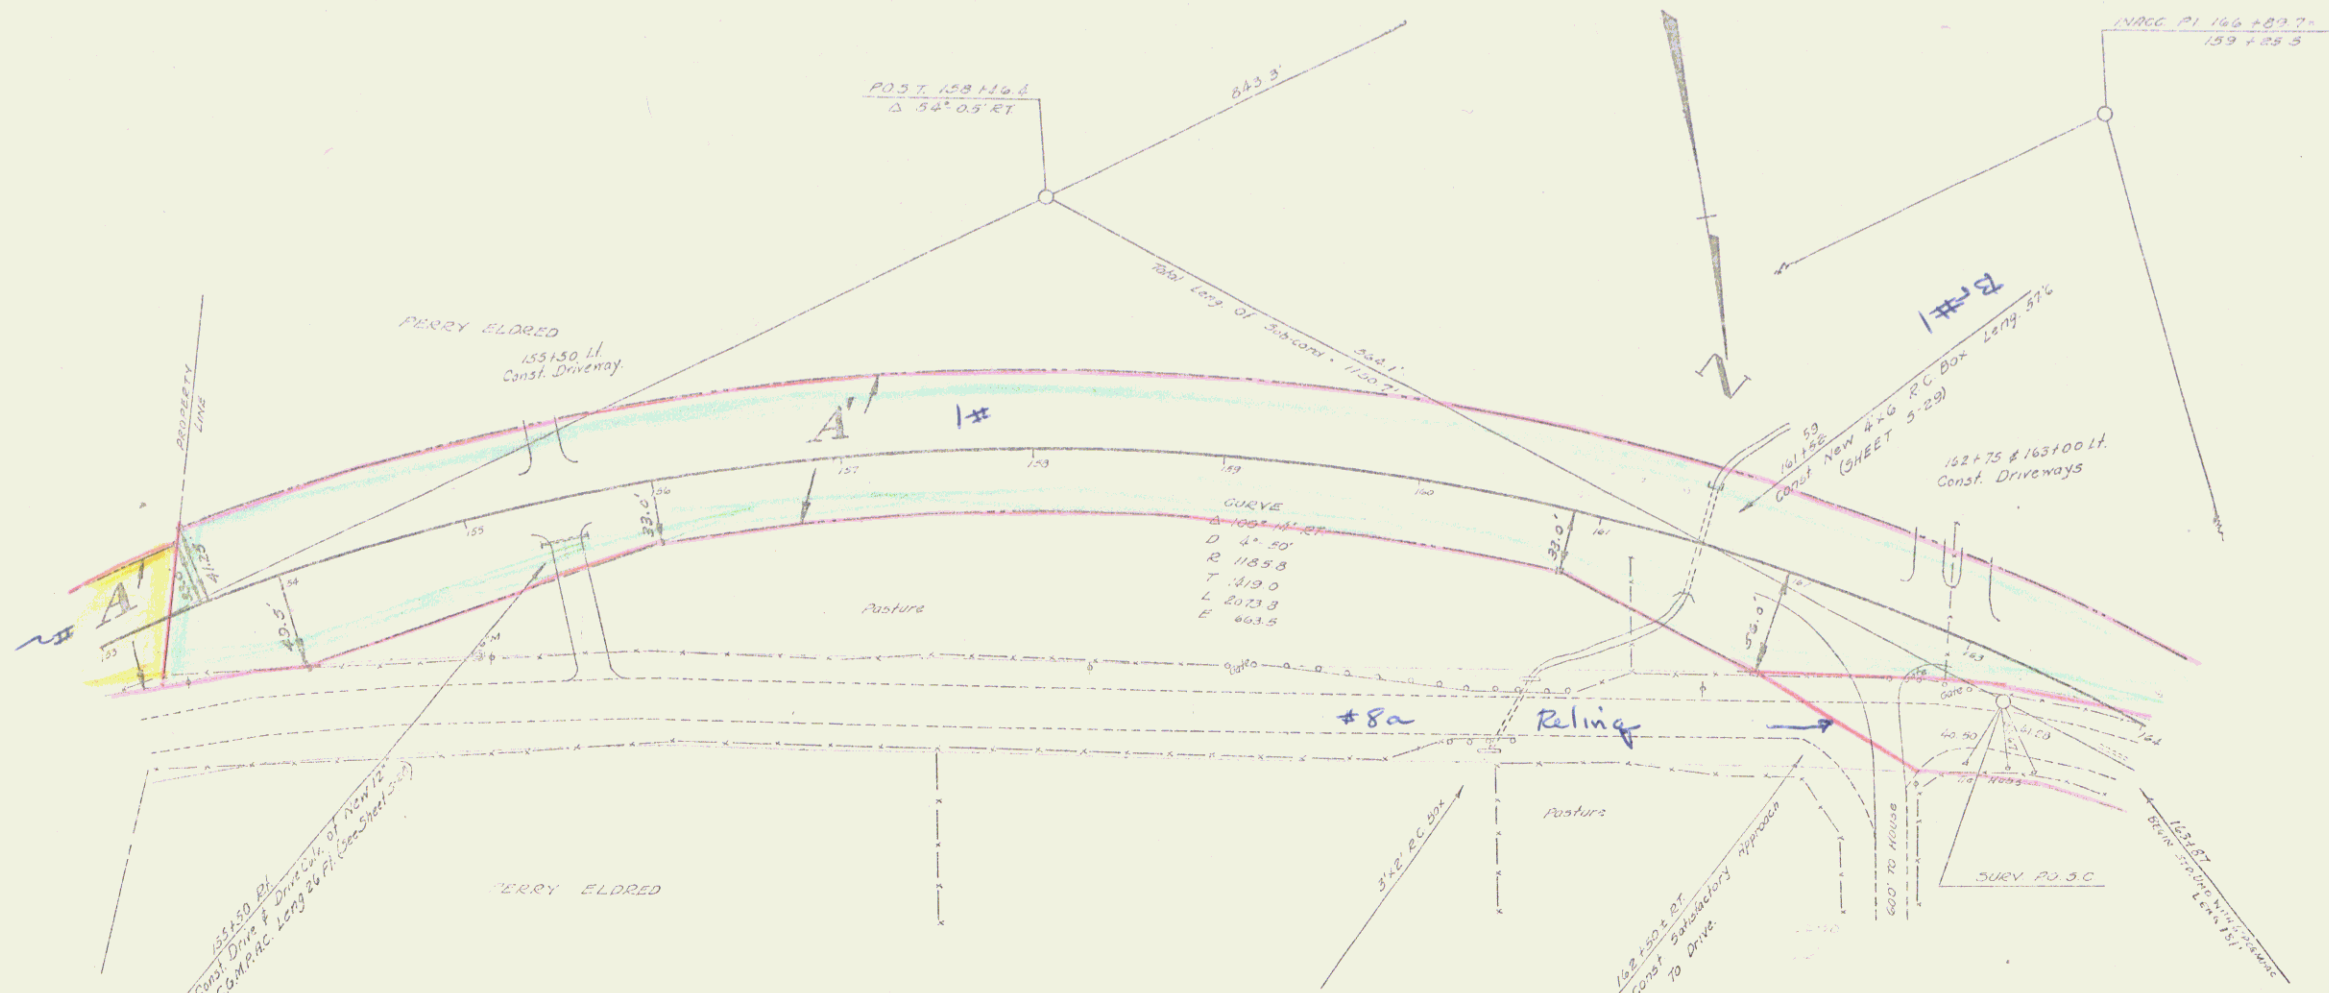

PARCEL	INSTRUMENT	DATE	GRANTOR	GRANTEE	RECORDED	REMARKS
A	W.D.	6-1-37	PHILLIP JACOBS	STONY	BOOK PAGE DATE	CU. STA.
A/B	W.D.	6-27-37	PERRY W. ELDERED	"	454 6-3-37	138+25, 144+50
A/D	PAR RELEASE	6-17-37	FED LAND BANK	"	486 6-27-37	141+52, 145+50
					0-61 10 6-26-37	

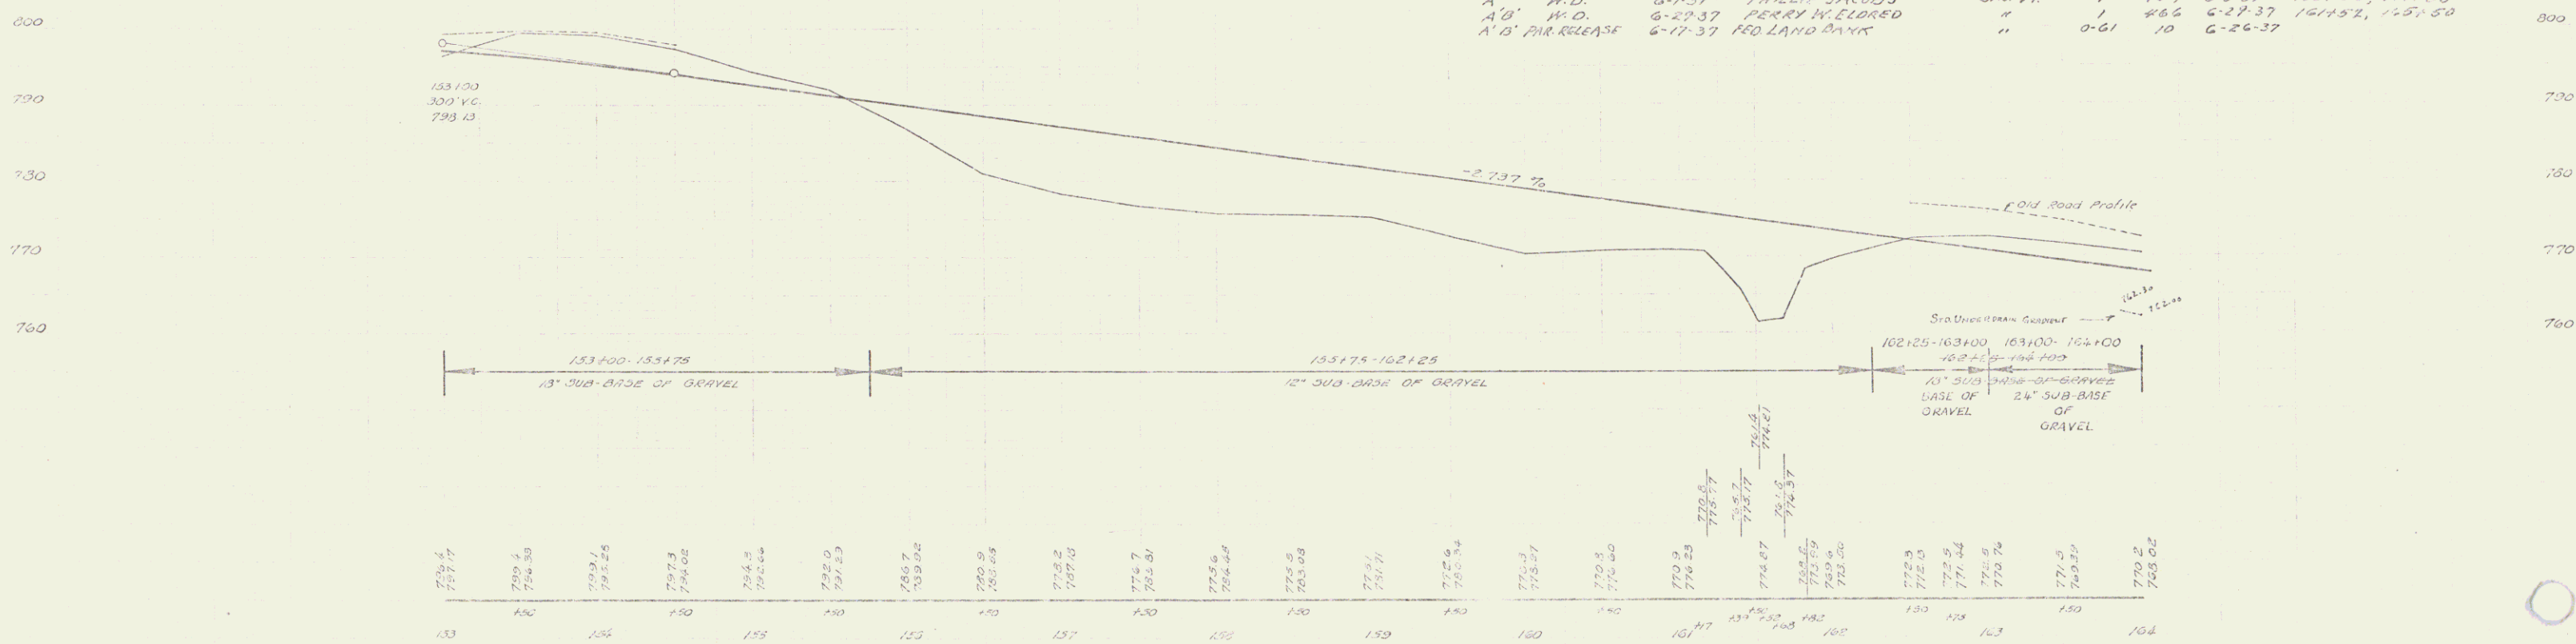

SERIES 500 NO. 219
SHEET 17 OF 18