

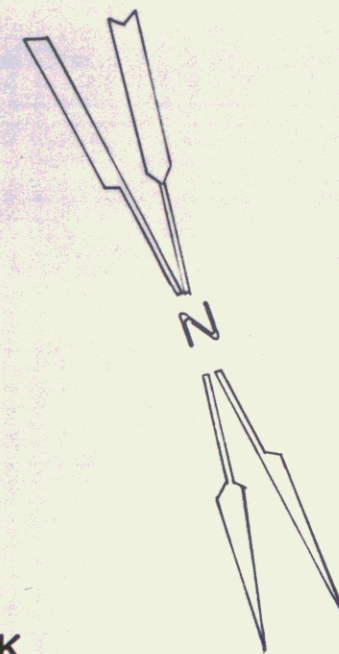


BEING PART OF THE SAME LAND AND PREMISES
 CONVEYED TO WILLIAM LUHRS WICKS BY EDWARD F & PHYLLIS
 ELDRED BY WD APRIL 22, 1969 AND RECORDED APRIL 29, 1969
 IN BK. 0-186, PG. 75 OF THE TOWN OF BENNINGTON LAND RECORDS

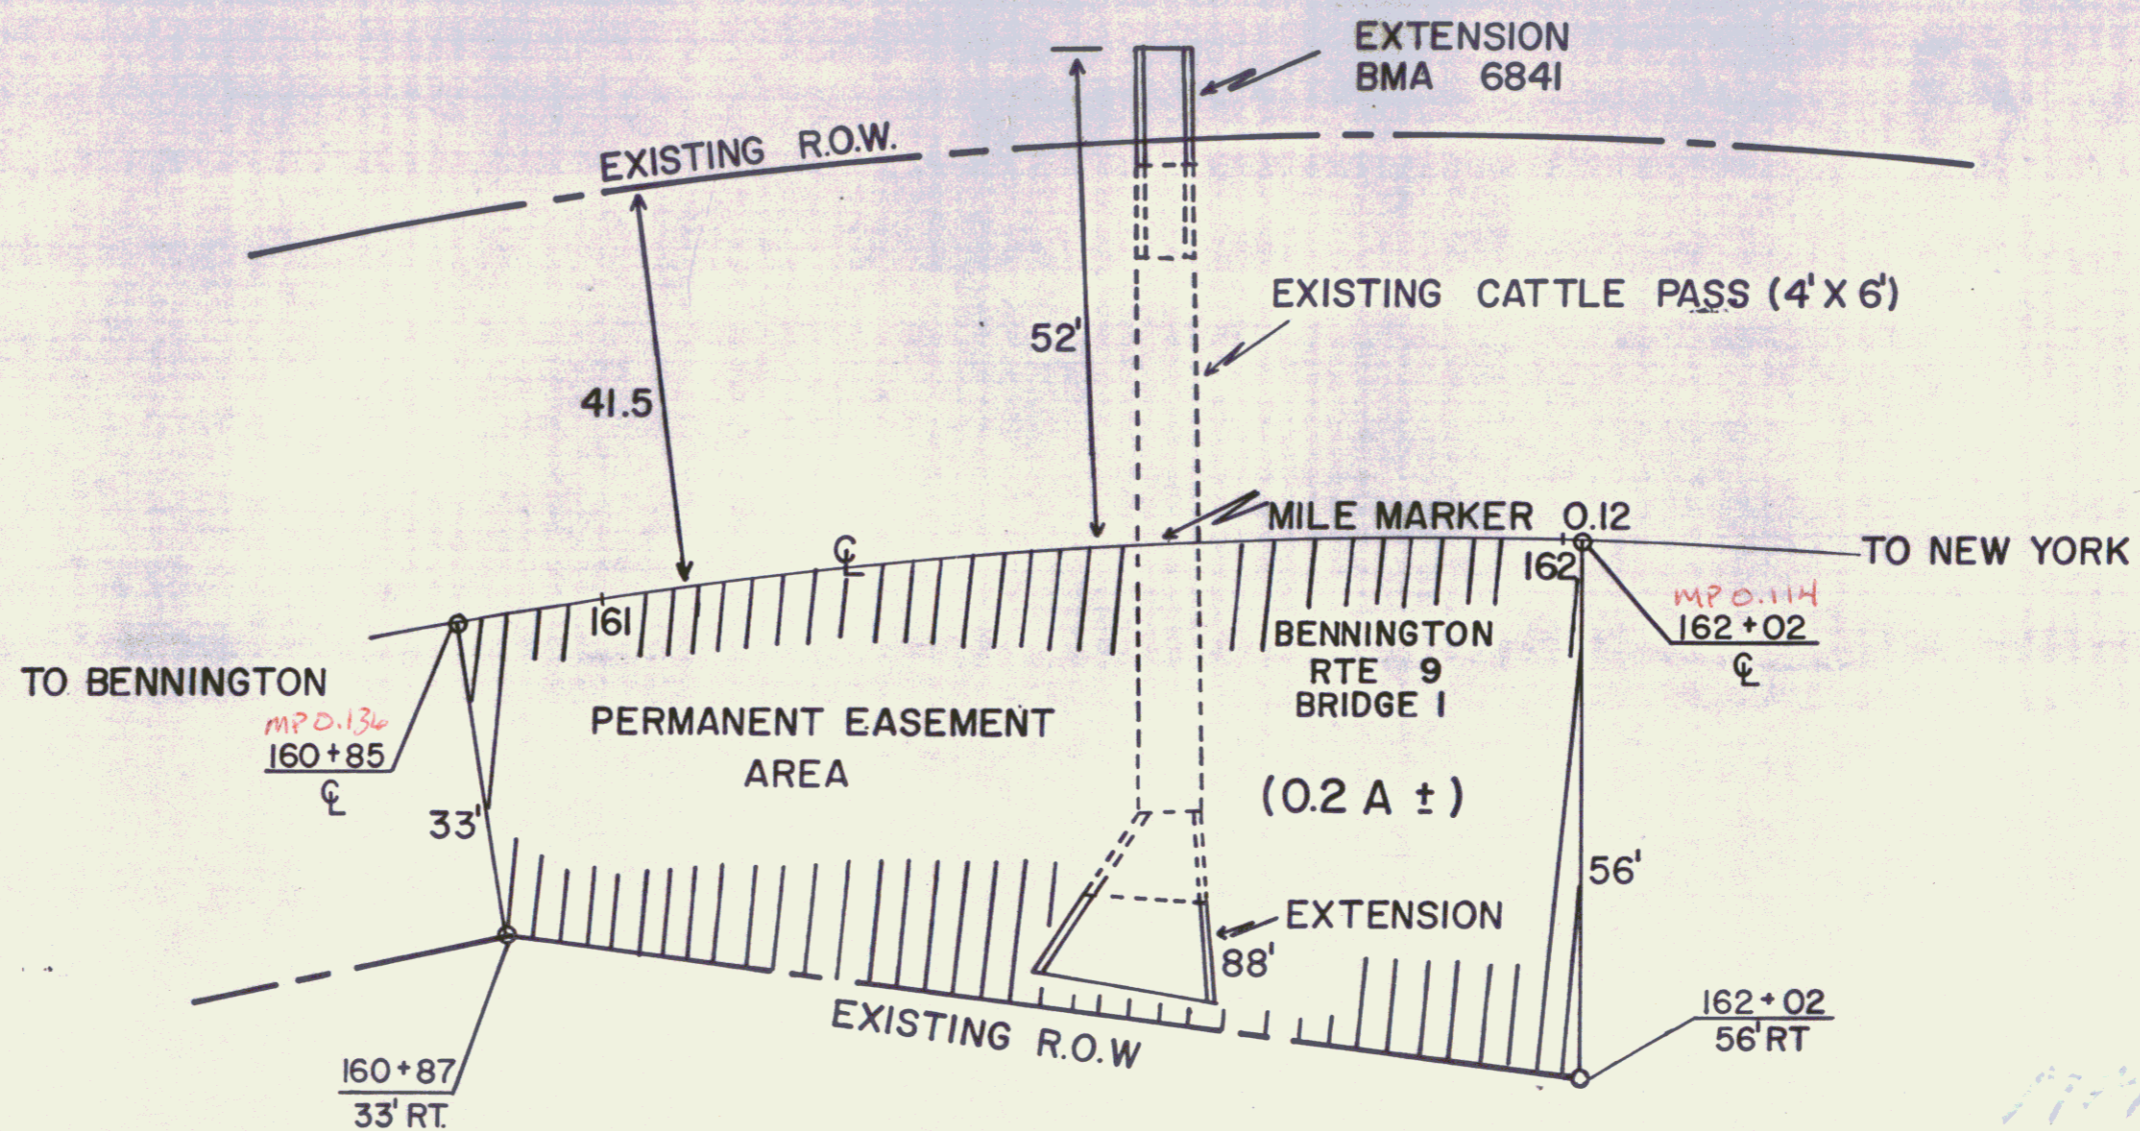

Pin# 99R808

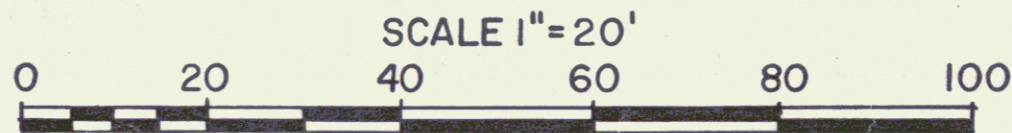

STATE OF VERMONT AGENCY OF TRANSPORTATION		
BENNINGTON BMA 6841		Sheet 1
Route VT9		1
APPROX SCALE 1" = 20'	DATE 10/02/87	DRAWN BY ASJ