
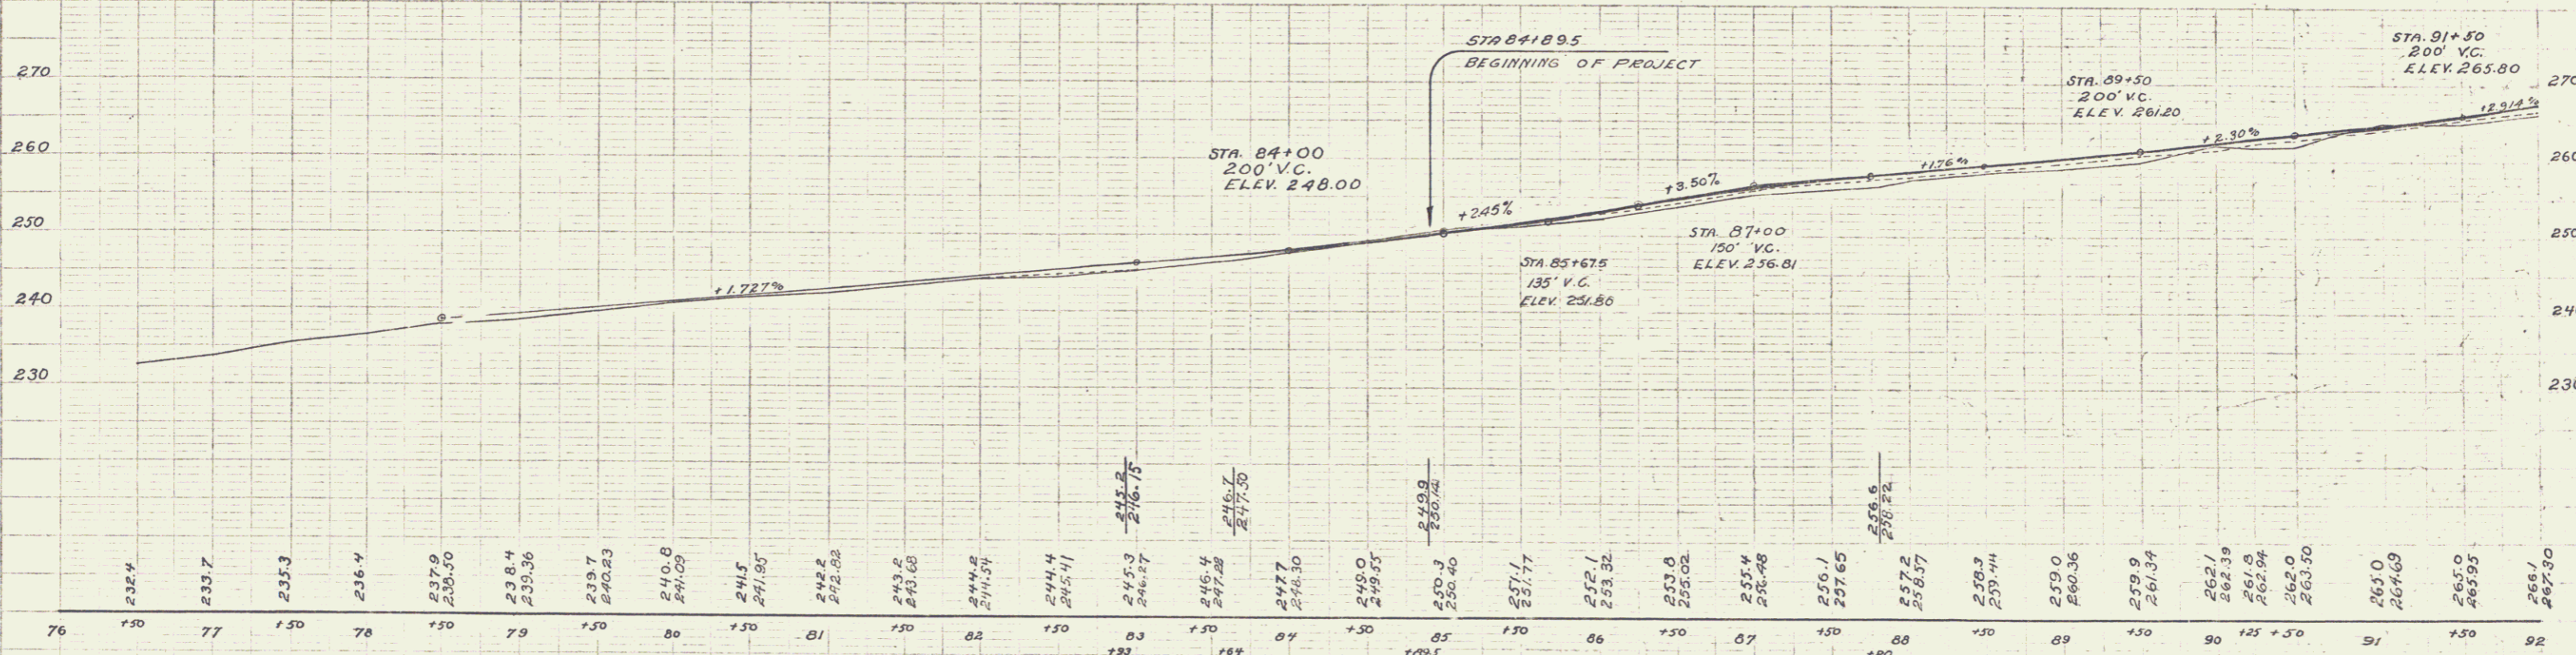


WOOD GUARD RAIL REQUIRED
 CURV. STR. LEFT RIGHT
 31+25 24' -

NEW RIMP CONC PIPE CULV WITH DI REQUIRED
 CURV. STR. DIAM. LEGS. CONC. B. CONC. C. RIMP STEEL GRATE
 31+25 15" 44' 14.5' 12.0' 15.45' 7'

FED. ROAD DIST. NO. STATE FISCAL YEAR SHEET NO. SHEETS
 105C 1930 3 13

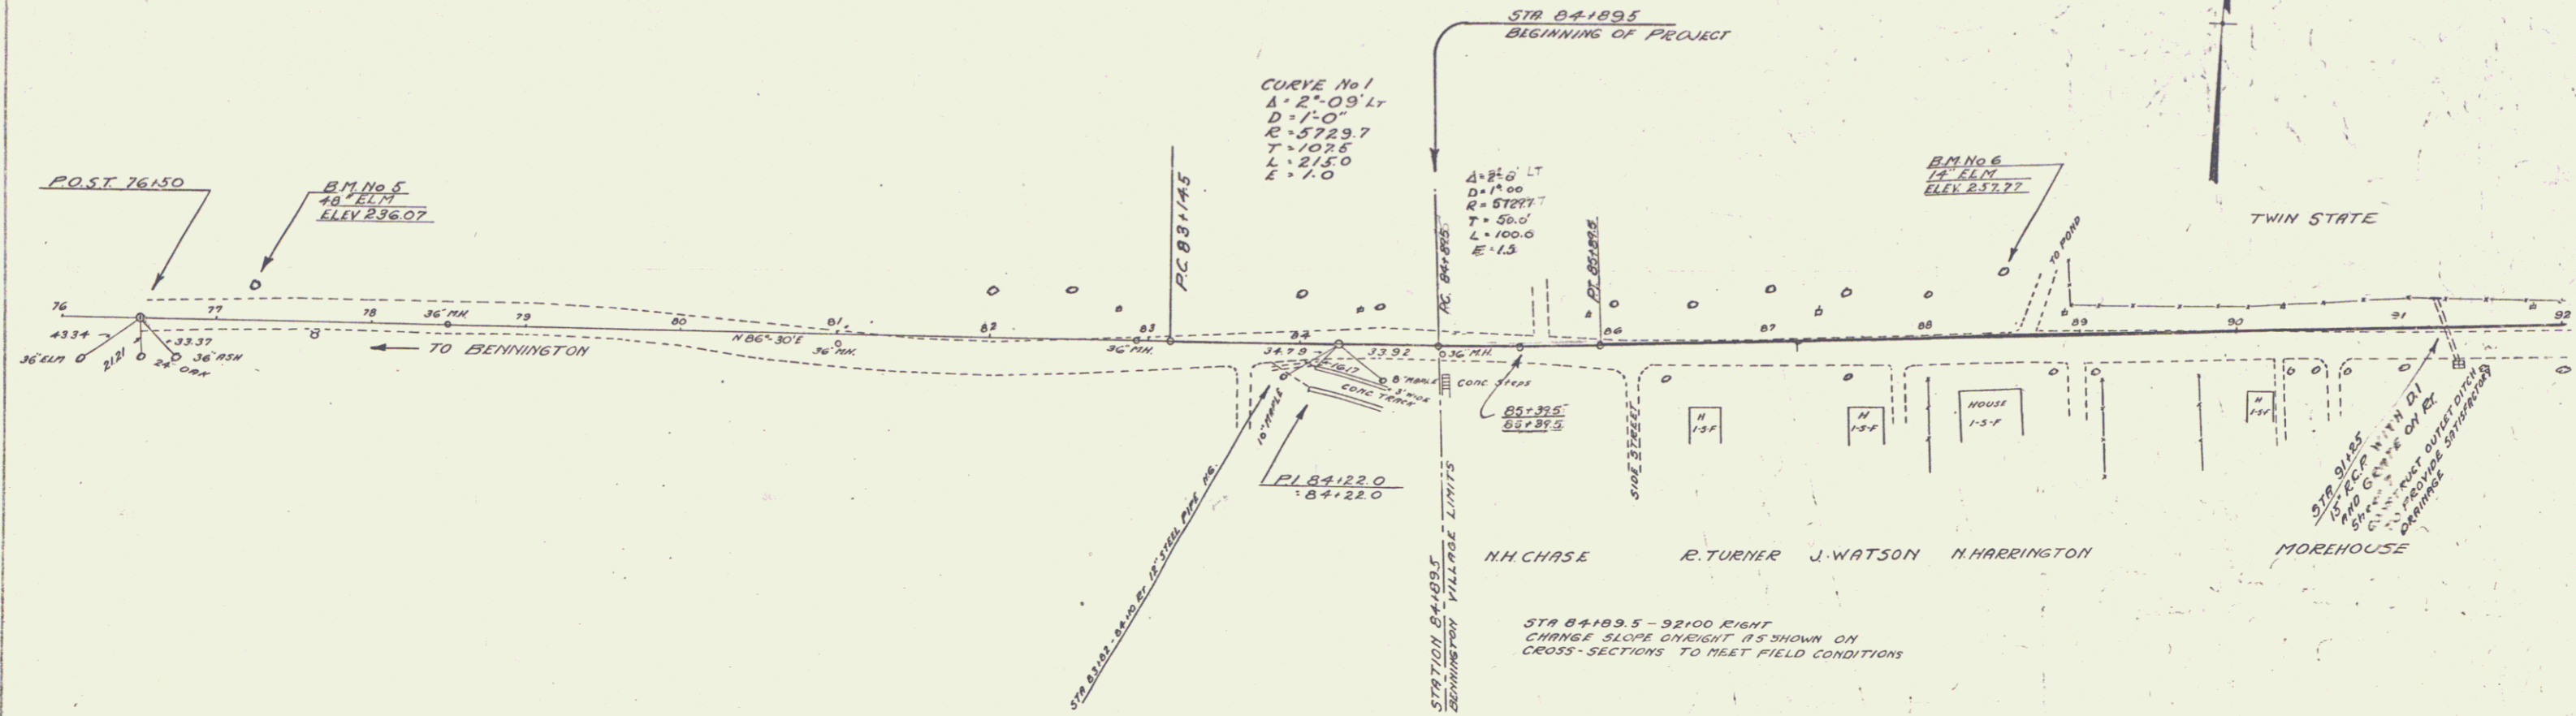

BM No 5 Spike in roof of 48" ELM 13' Lt of Sta 77+24 Elev 236.07
 BM No 6 Spike in roof of 14" ELM 36" Lt of Sta 88+52 Elev 257.77

SERIES No 105-c
 Sheet 3 of 15