



WOOD BRIDGE RAIL REQUIRED
 CULVERT STA 93+18 24' 24'

NEW REIN CONC PIPE CULVERT REQUIRED
 STA 94+52.2 12' 36' 23' 33' 33'

FED. ROAD DIST. NO. 105-C DATE 1930 YEAR 4 SHEET 15

PLAN SHEETS PLOTTED AND CHECKED BY H. SHIELDS
 NOTE: WORK IS TO BE CHECKED BY THE ENGINEER

PLAN SHEETS PLOTTED AND CHECKED BY H. SHIELDS
 NOTE: WORK IS TO BE CHECKED BY THE ENGINEER

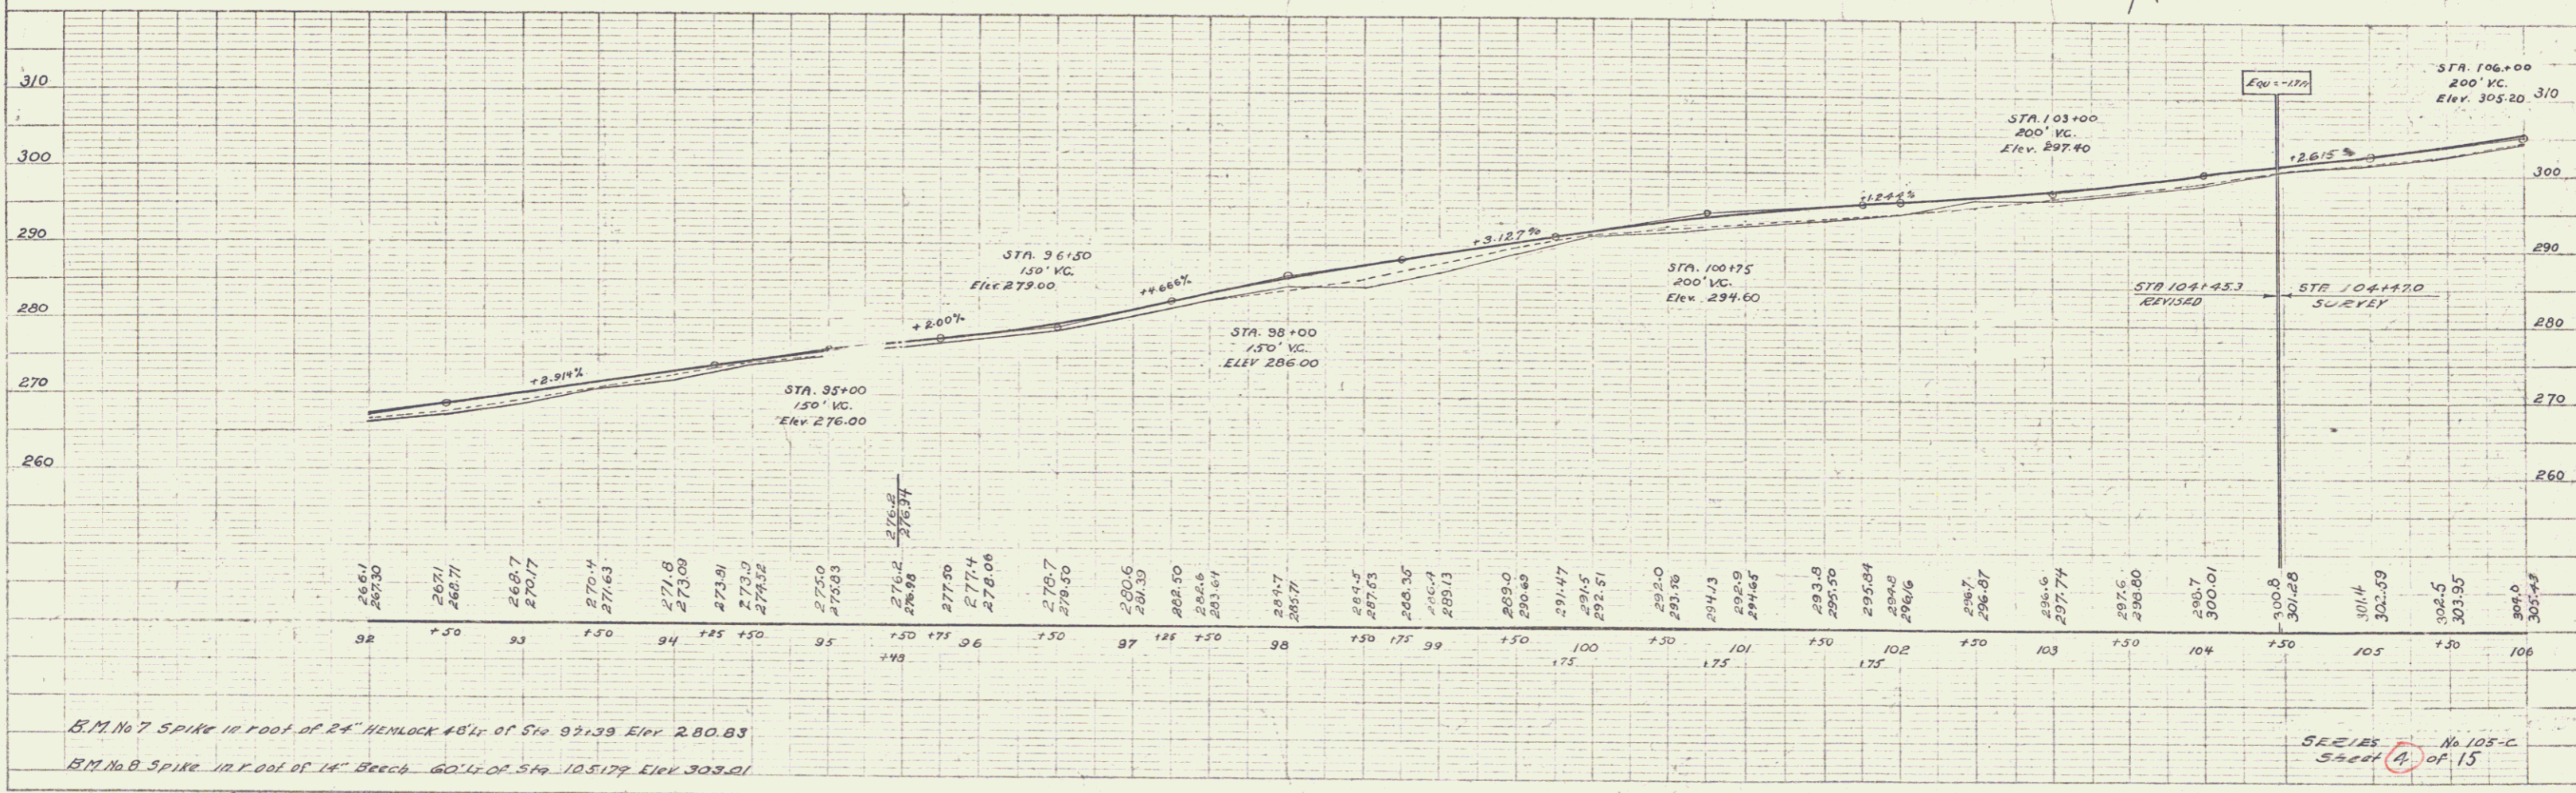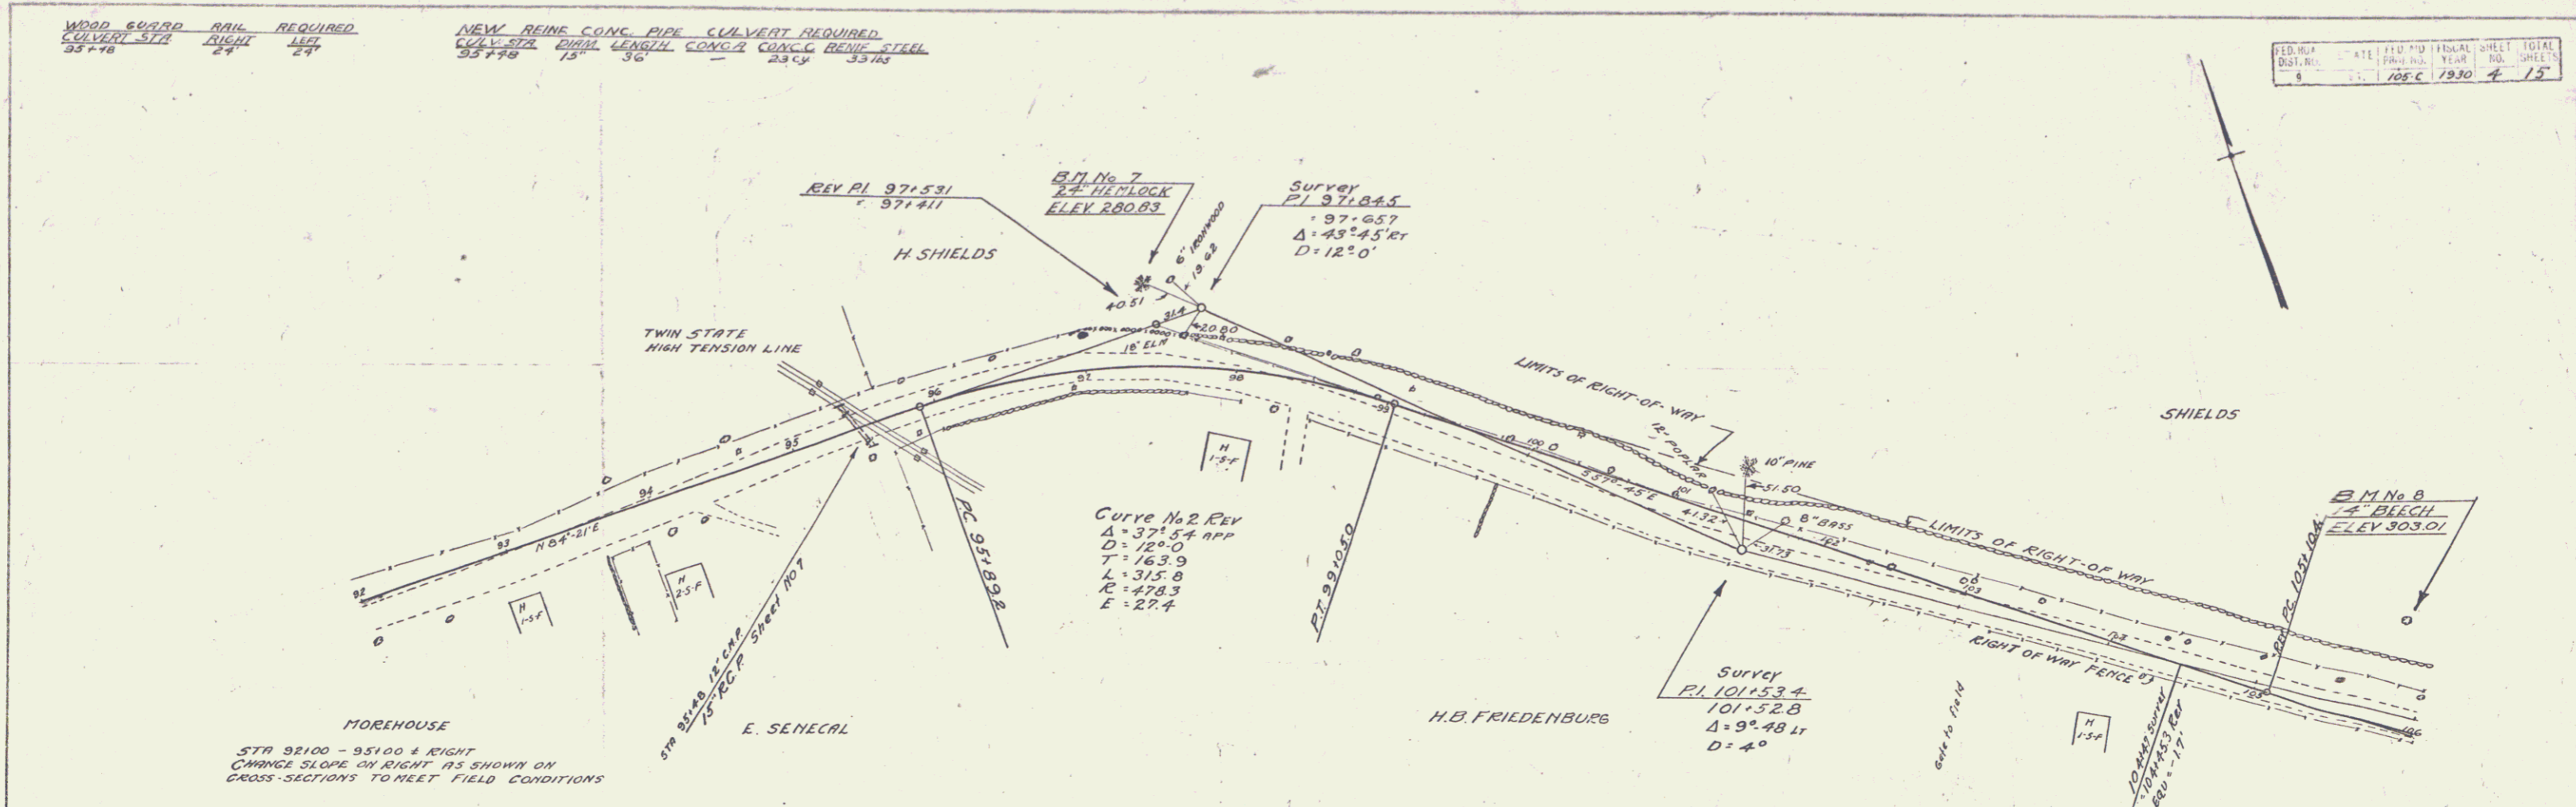

B.M. No. 7 SPIKE IN FOOT OF 2" HEMLOCK 48" OF STA 97+39 Elev 280.83
 B.M. No. 8 SPIKE IN FOOT OF 14" BEECH 60" OF STA 105+17 Elev 303.01

SEE 125 No. 105-C Sheet 14 of 15