
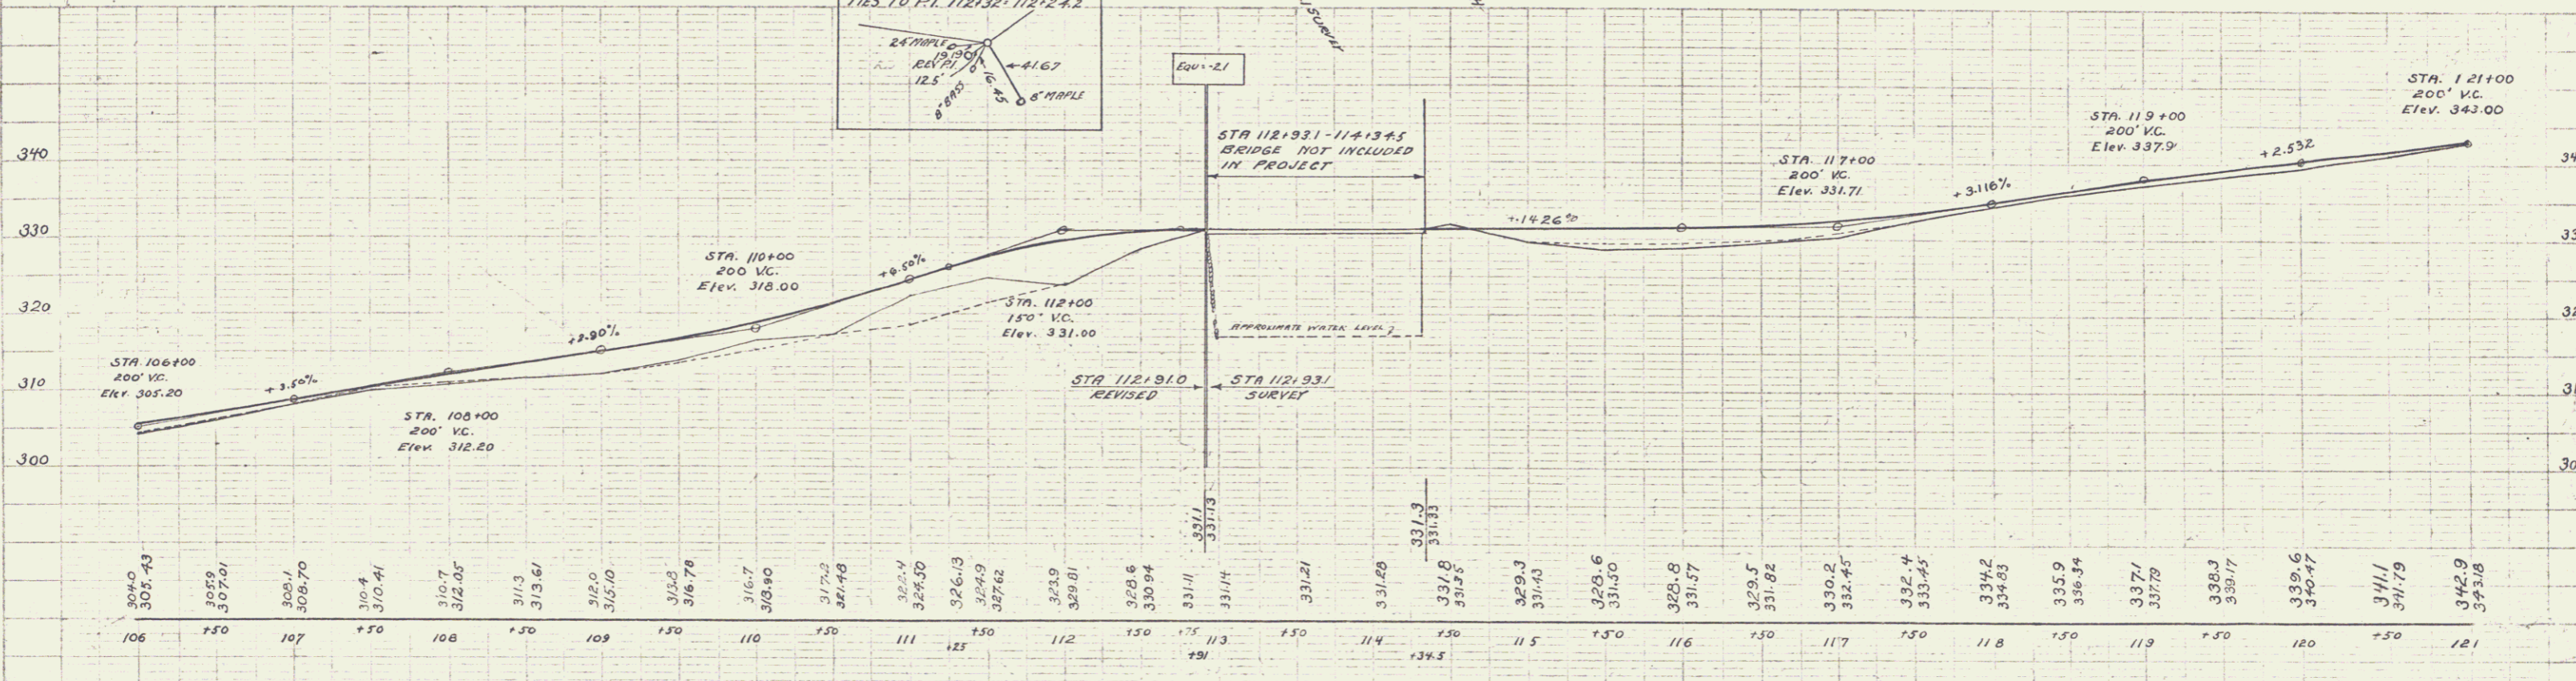


WOOD GUARD RAIL REQUIRED	CABLE GUARD RAIL REQUIRED	
COV. STA	LEFT	RIGHT
106+50	24'	24'
110+00-112+02	200'	
112+58-112+02		24'
114+34-116+34	200'	24'
114+34-115+30		96'

NEW 18" CONC. PIPE CULVERT REQUIRED	NEW 18" CONC. PIPE DRIVEWAY CULVERT REQUIRED		
COV. STA	PIECE LENO	CONC. CORR.	STEEL
106+50	18"	36"	33 lbs
106+50	12"	56"	23 cy

NEW 18" CONC. PIPE DRIVEWAY CULVERT REQUIRED	NEW 18" CONC. PIPE DRIVEWAY CULVERT REQUIRED		
COV. STA	PIECE LENO	CONC. CORR.	STEEL
106+50	12"	56"	23 cy

DATE	10/15/50	SHEET	5	OF	15
PROJECT	SHIELDS				
DESIGNED BY	J. W. BROWN				
CHECKED BY	J. W. BROWN				
APPROVED BY	J. W. BROWN				

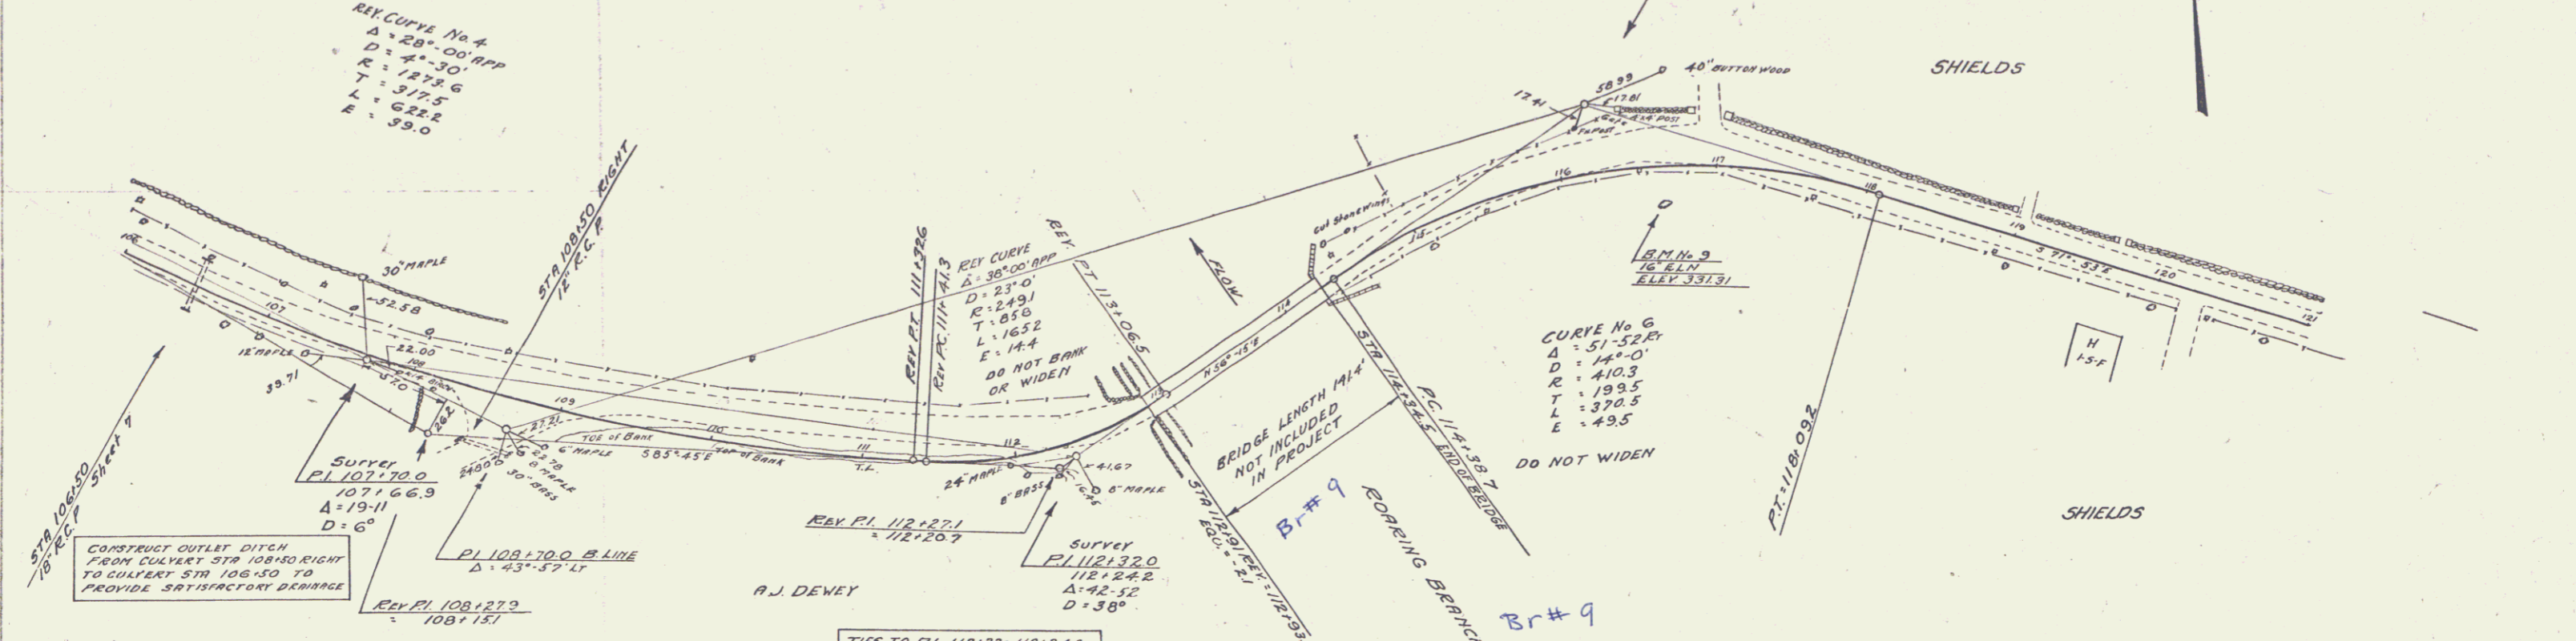

BM No 9 spike in root of 16" Elm 22' E. of Sta 116+66 opp. Gate Elev. 331.31

SERIES N. 1050
Sheet 5 of 15

MADE IN PENNSYLVANIA

4