
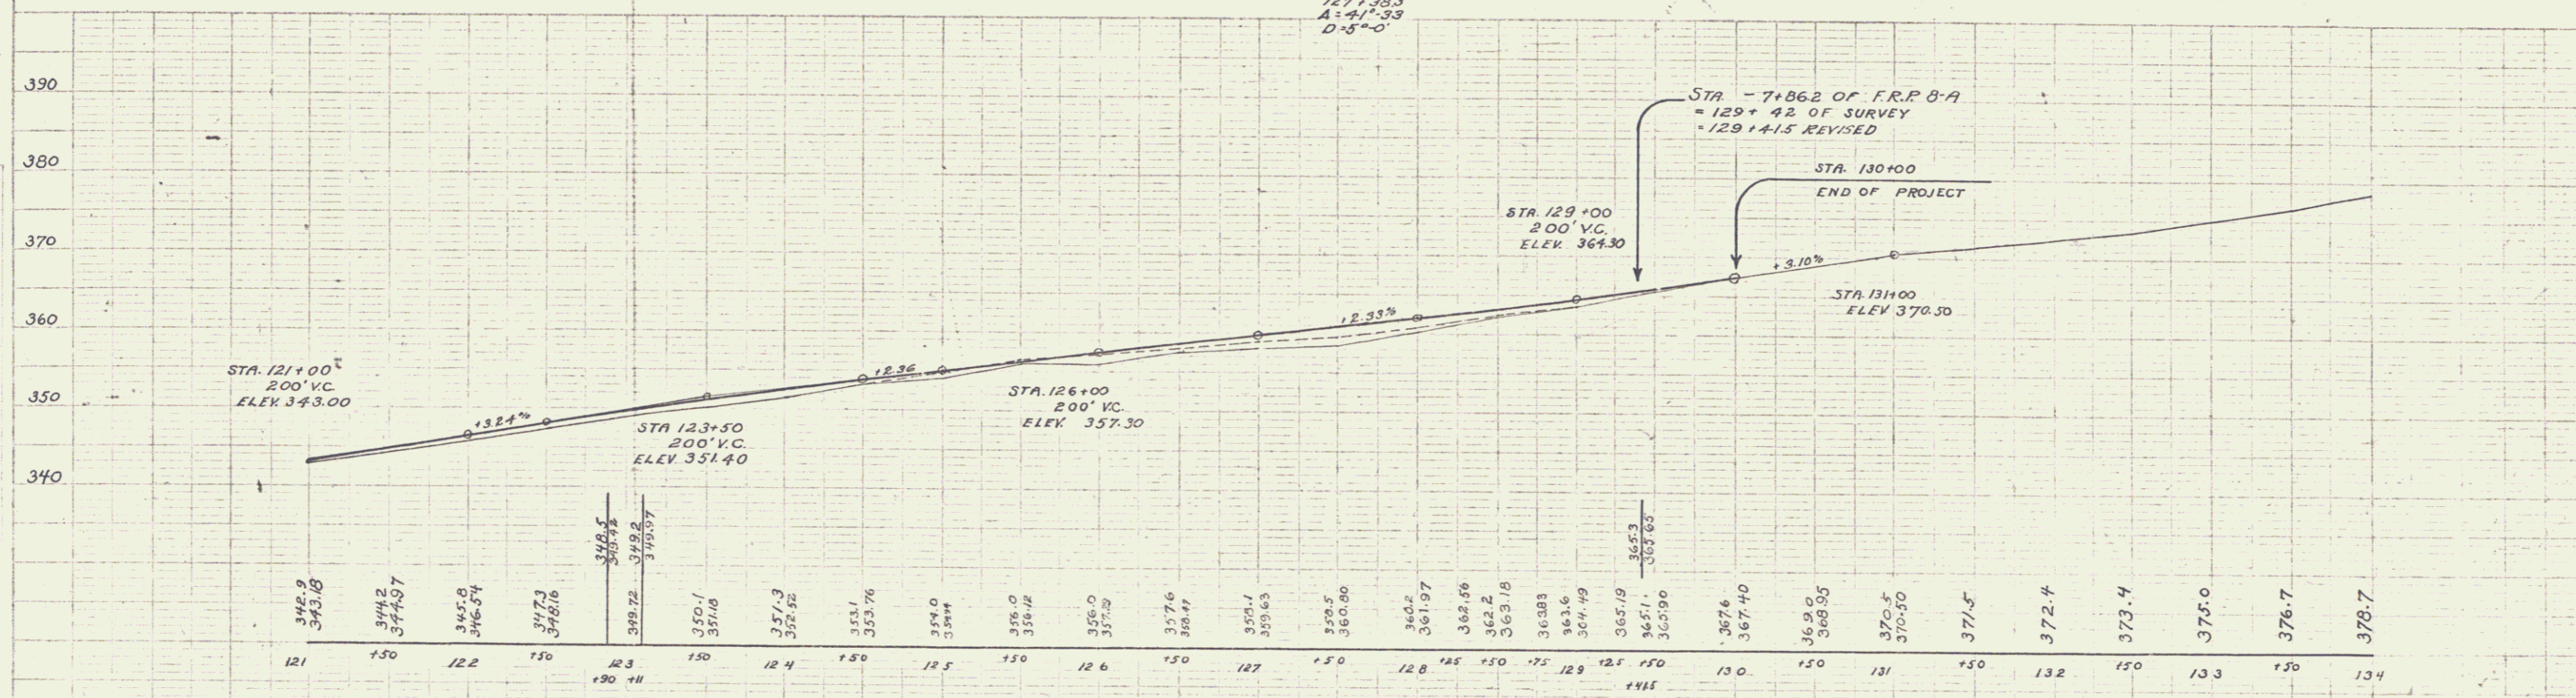


CABLE GUARD RAIL REQUIRED
STATIONS LEFT
125475-126171 36

PROJECT NO.	STATE	FED. AID	FISCAL YEAR	SHEET NO.	TOTAL SHEETS
105C	1930	6	15		

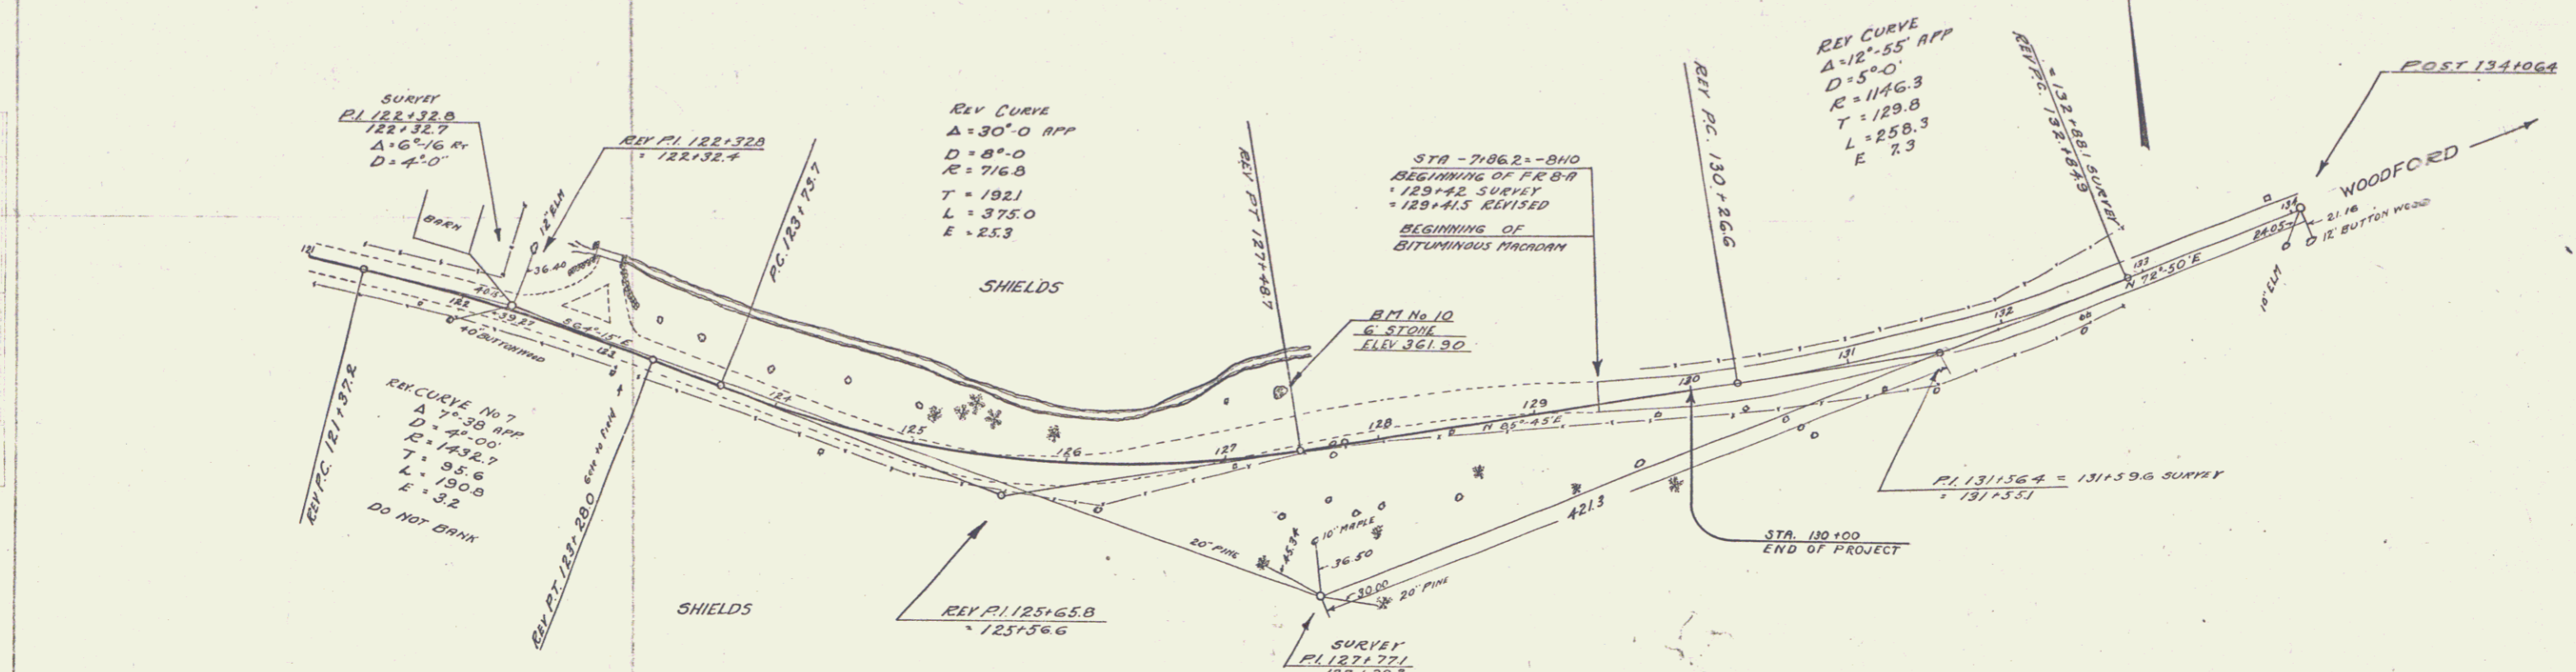

B.M. No 10 Top of 6' boulder in bank 48' W of Sta 127135 Elev 361.90

SERIES No 105C
Sheet 6 of 15