
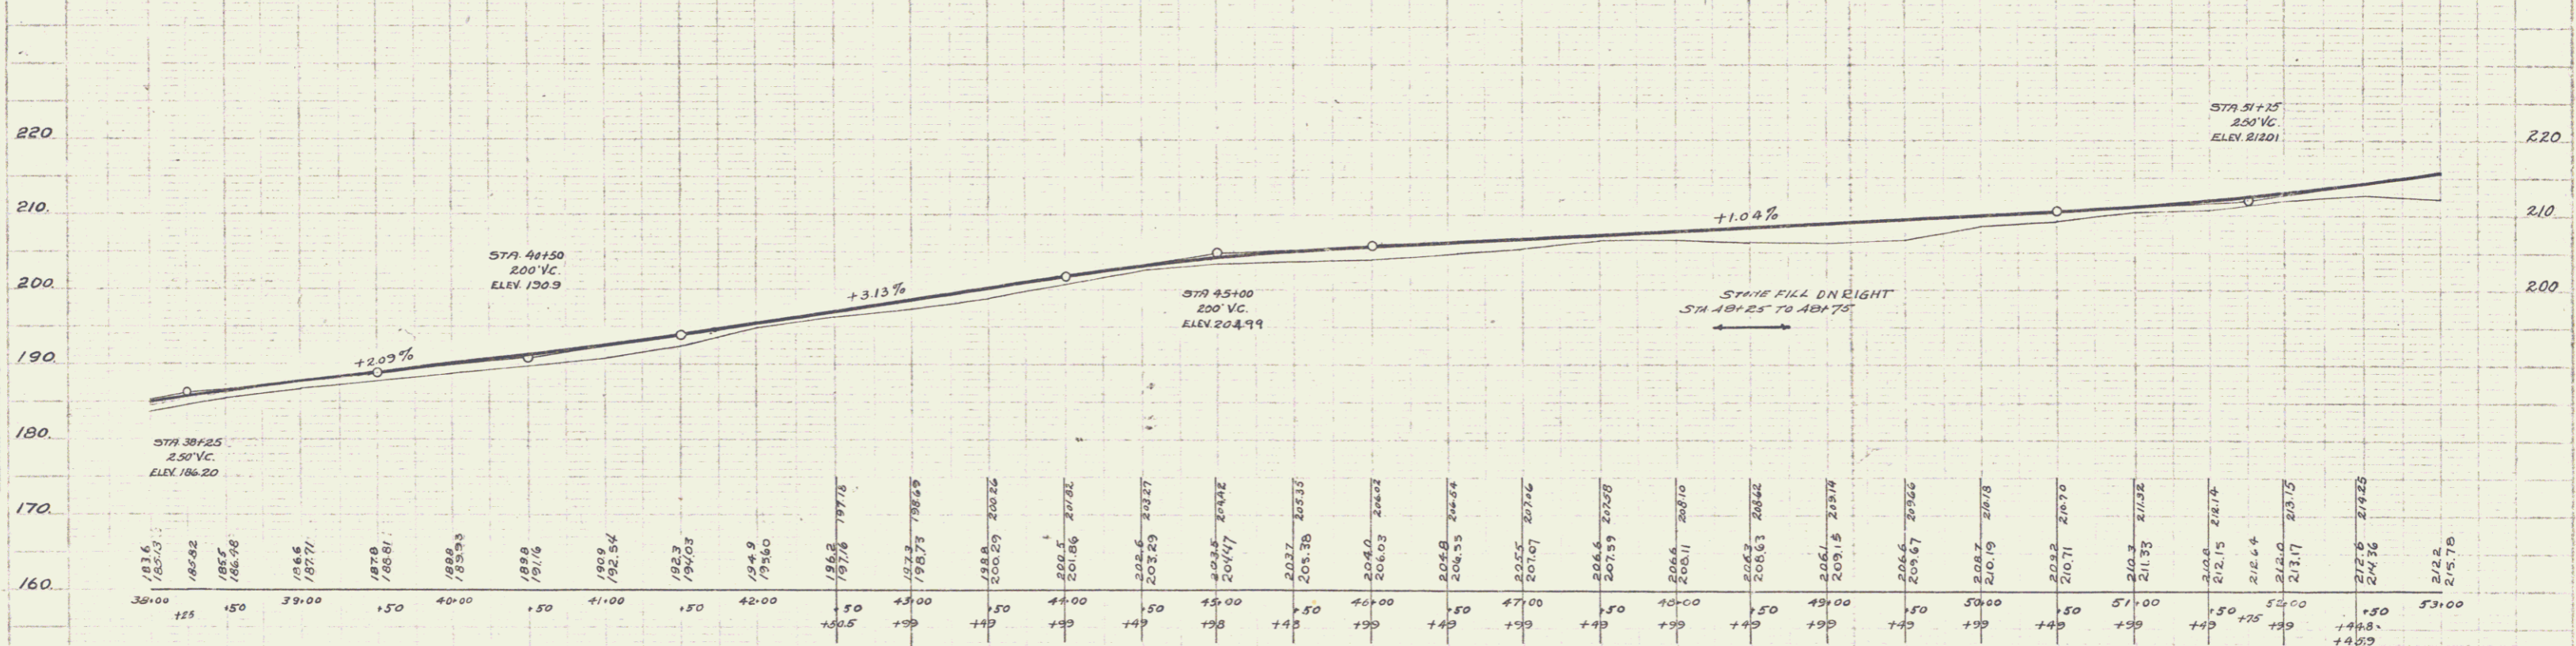


WOOD GUARD RAIL REQUIRED
 0M LEFT
 STA 41+28 TO STA 41+52 LENGTH 24 FT
 " 48+28 " " 48+52 " 24 FT
 0M RIGHT
 STA 41+28 TO STA 41+52 LENGTH 24 FT
 " 48+28 " " 48+52 " 24 FT

NEW CULVERTS REQUIRED
 STA 41+40 16' CIRC CORR PIPE 20' LONG
 CONC. CLASS B (12K-5) 27 cu yd
 REIN. STEEL 33 lbs
 STA 48+50 18' CORR CORR PIPE 20' LONG
 CONC. CLASS B (12K-5) 31 cu yd
 REIN. STEEL 33 lbs

FIELD ROAD DIST. NO.	STATE	FED. AID PROJ. NO.	FISCAL YEAR	SHEET NO.
5	VT	FE87	1988	7

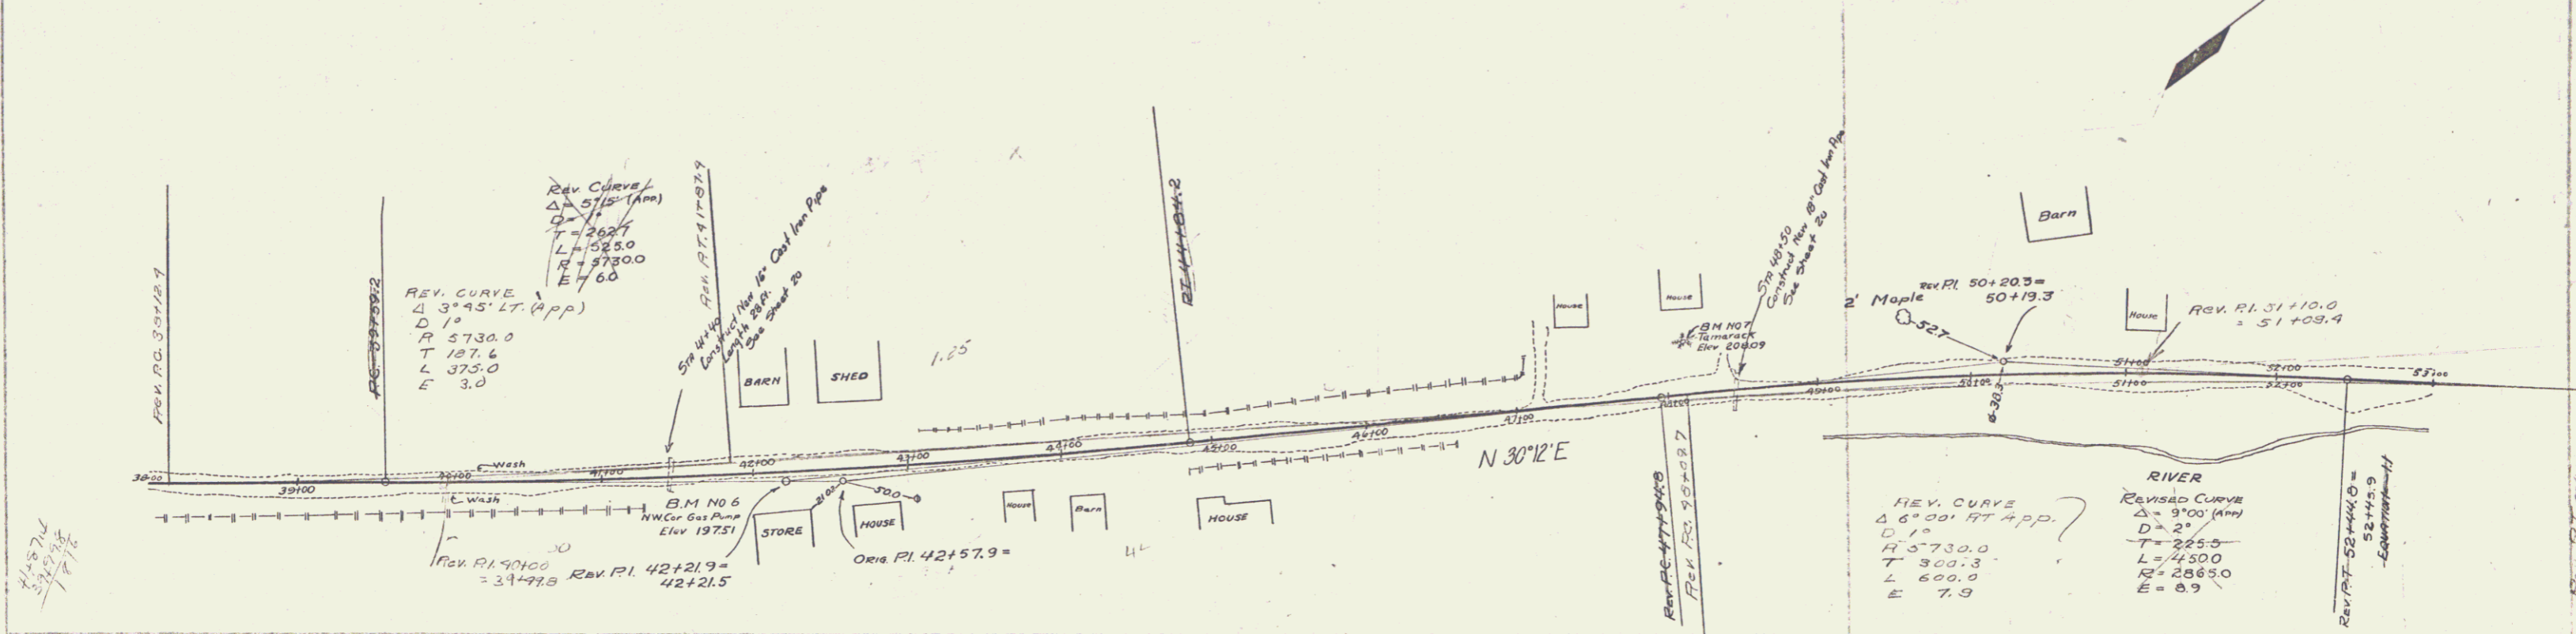

B.M. NO 6 N.W. Cor Concrete Gas Pump Base, Caron's Store Elev 197.51
 B.M. NO 7 Nail in 12" Tamarack Left of Sta 28+12 Elev 209.09

SERIES 1216.50
 SHEET 7 OF 48