
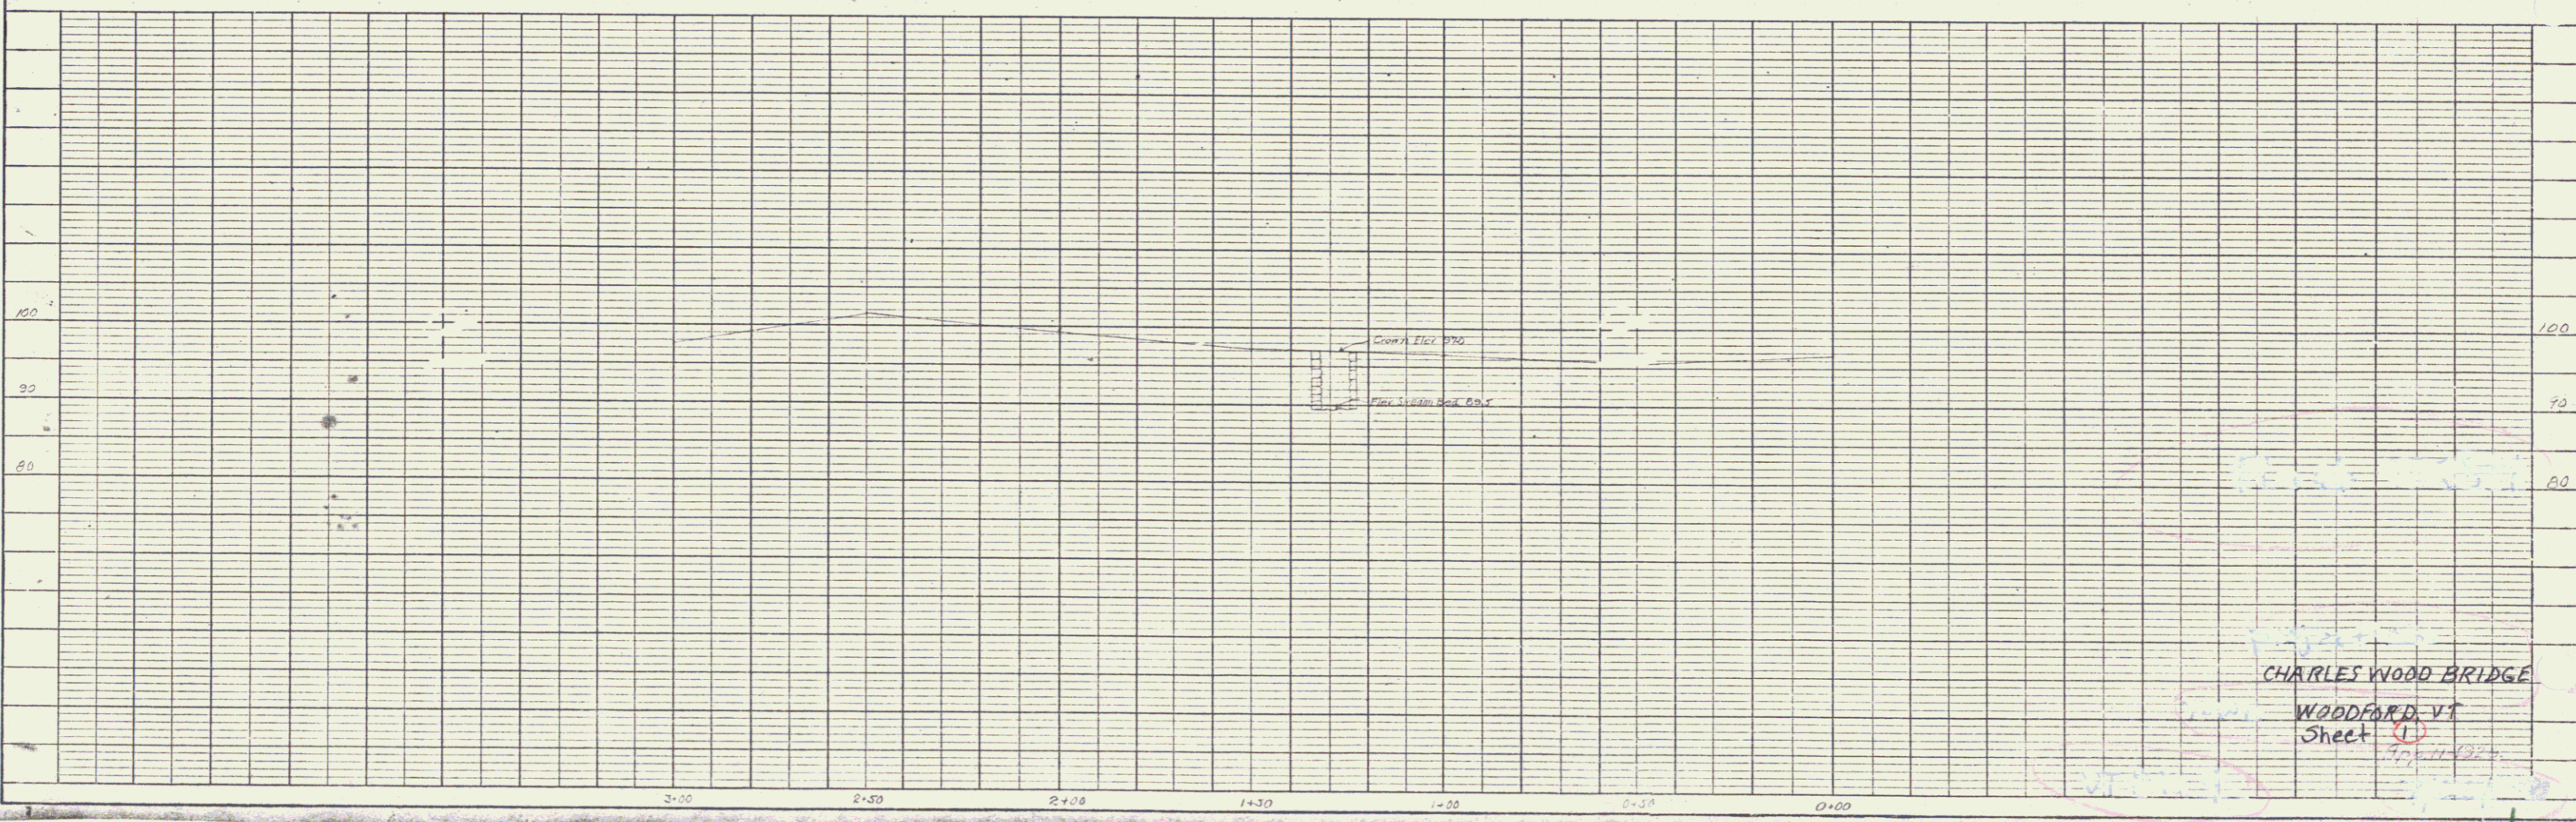


Woodford  
Possibly Bridge #10  
Approx. H.M. 1.11

TOWN OF WOODFORD  
Project Charles Wood Bridge  
Pin # 99R814  
Route VT 9  
Date 7/20/1926

PLAN  
PROJECT: CHARLES WOOD BRIDGE  
SHEET BOOK NO. 10  
DATE: 7/20/26

PROFILE  
PROJECT: CHARLES WOOD BRIDGE  
SHEET BOOK NO. 10  
DATE: 7/20/26

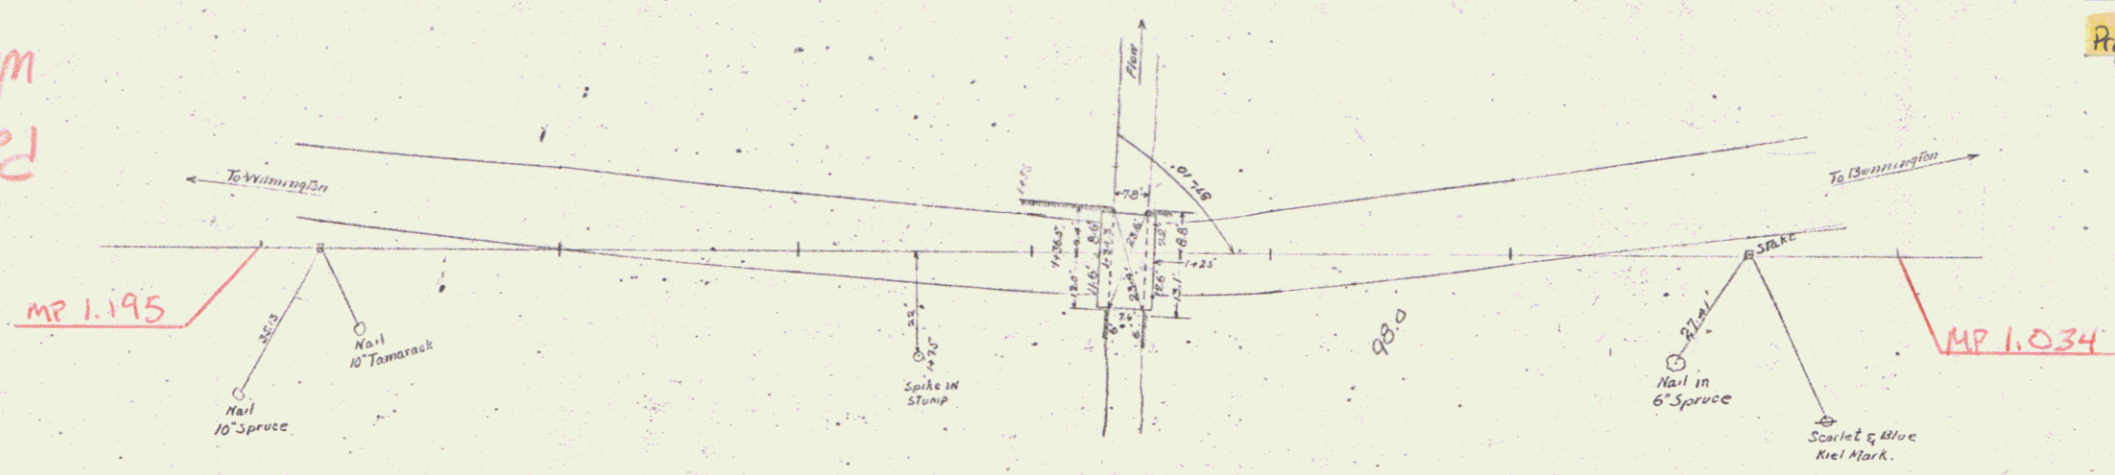

CHARLES WOOD BRIDGE  
WOODFORD, VT  
Sheet 1

DIST. # 1 PLANS