
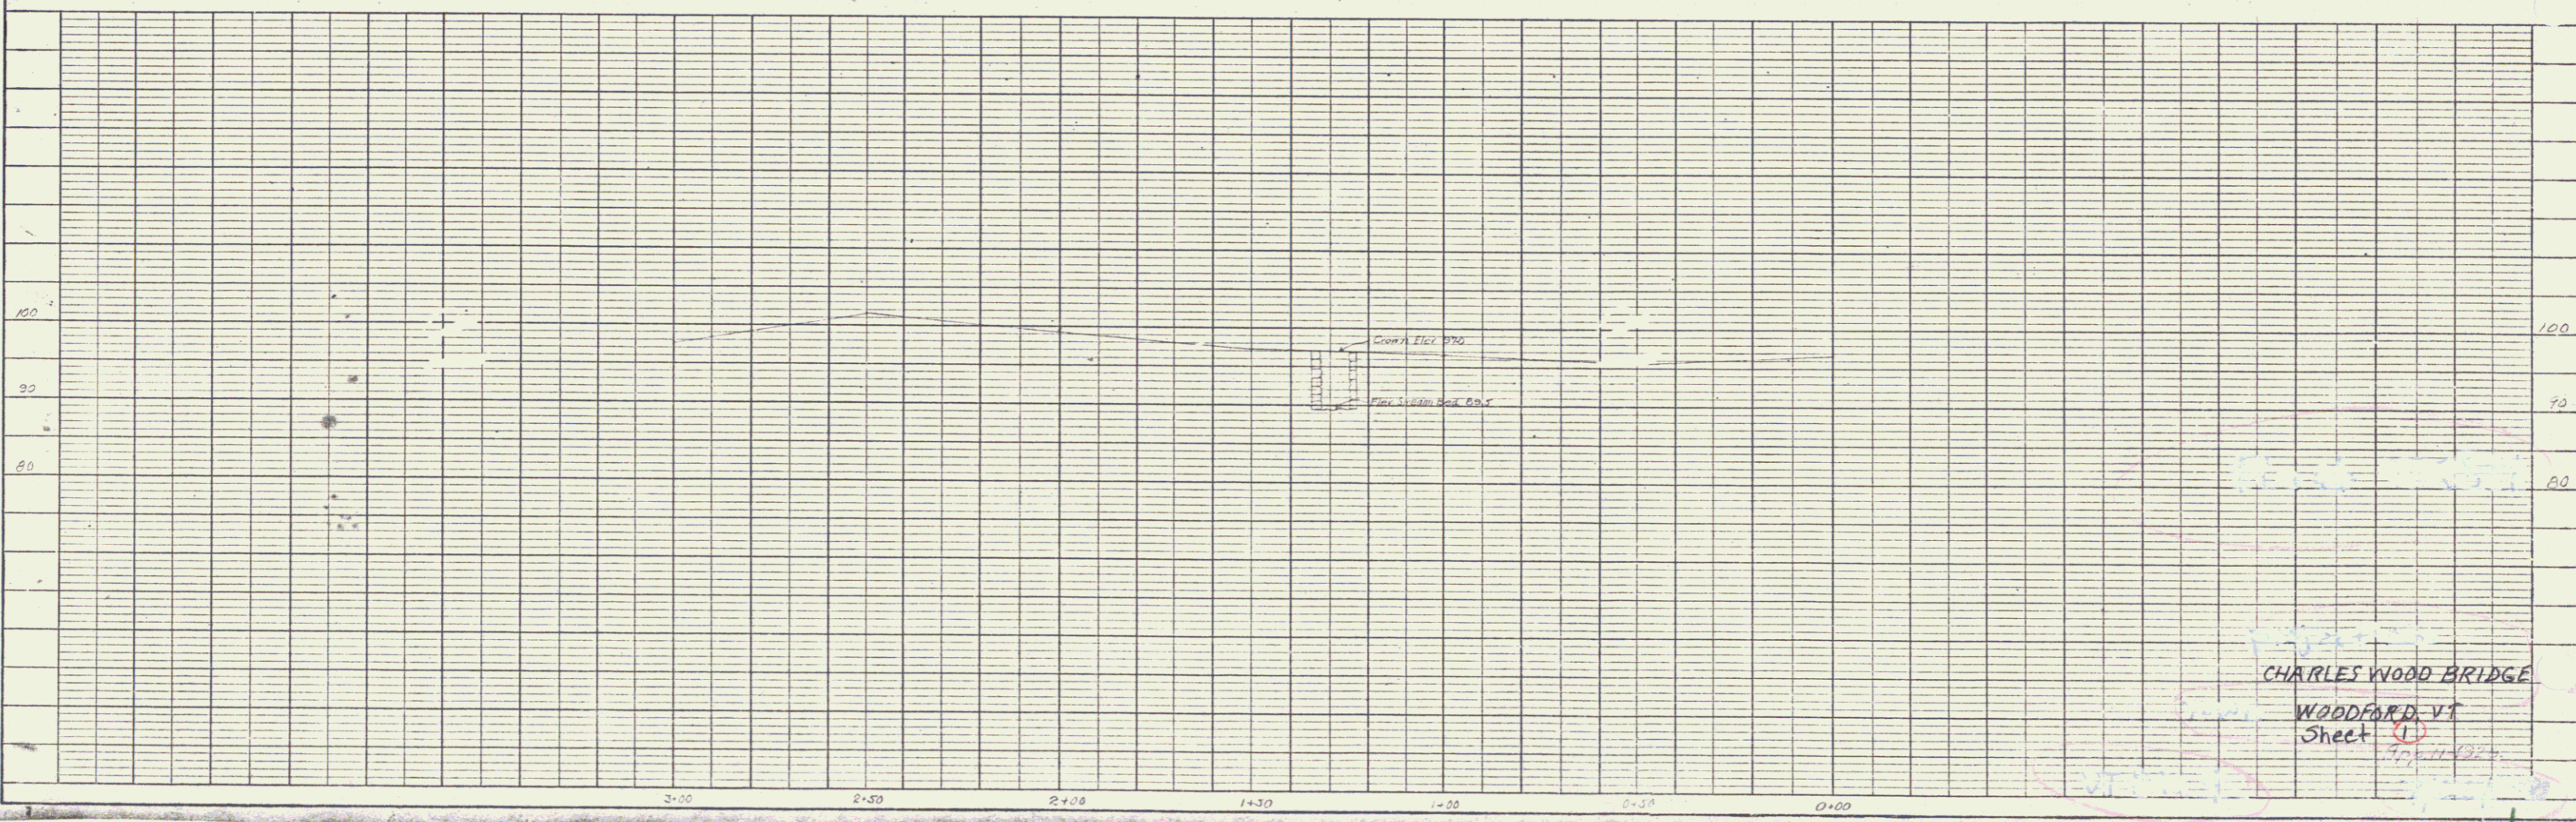


Possibly Bridge #10
Woodford
Approx. H.M. 1.11

TOWN OF WOODFORD
Project Charles Wood Bridge
Pin # 99R814
Route VT 9
Date 7/20/1926

PLAN
PROJECT: WOODFORD BRIDGE
SHEET BOOK NO. 10
DATE: 7/20/26

PROFILE
PROJECT: WOODFORD BRIDGE
SHEET BOOK NO. 10
DATE: 7/20/26

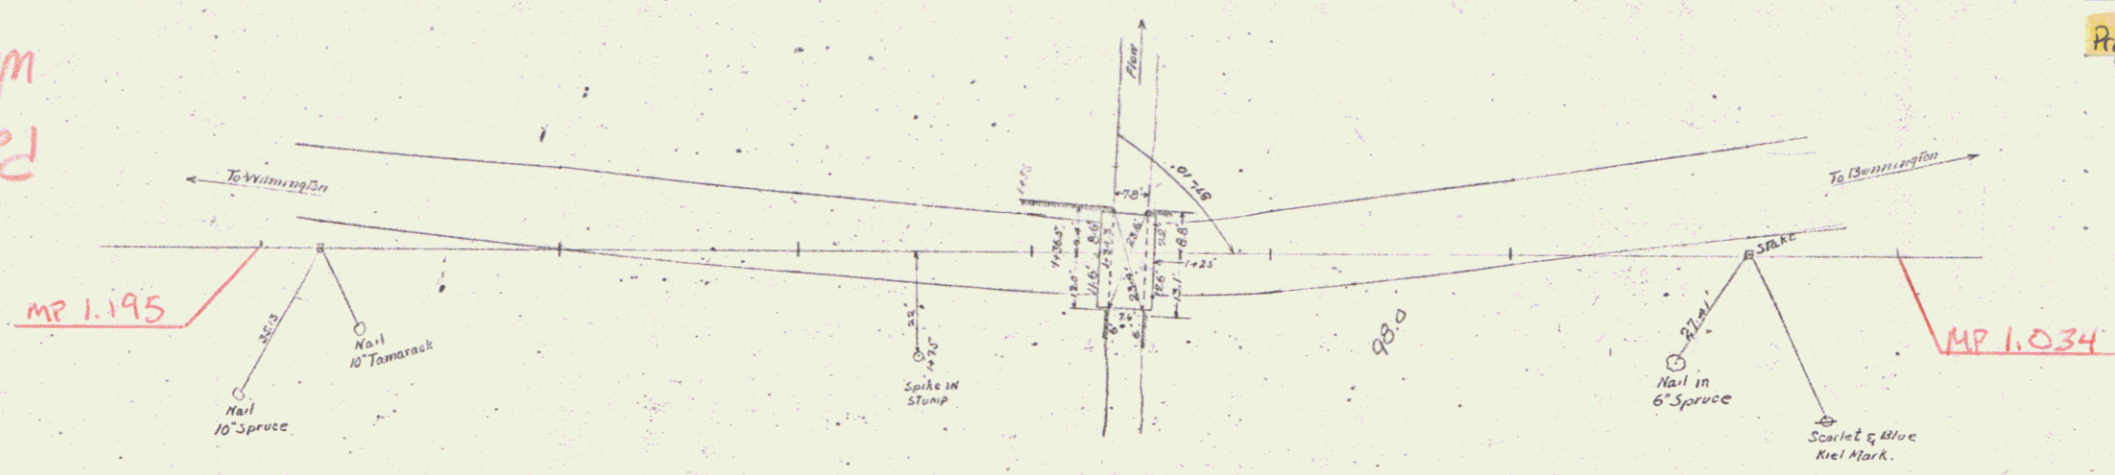

CHARLES WOOD BRIDGE
WOODFORD, VT
Sheet 1

DIST. # 1 PLANS