

Vt. Route 9 Molly Stark Trail

BENNINGTON WOODFORD

FELH 105(14)

EXISTING STRUCTURE 3 @ 450' at Sta. 42+0

1. 1539.0 @ 1538

2. 1539.0 @ 1539

3. 1539.0 @ 1540

515. 1539.0 @ 2052


516. 1539.0 @ 2053

517. 1539.0 @ 2054

518. 1539.0 @ 2055

519. 1539.0 @ 2056

520. 1539.0 @ 2

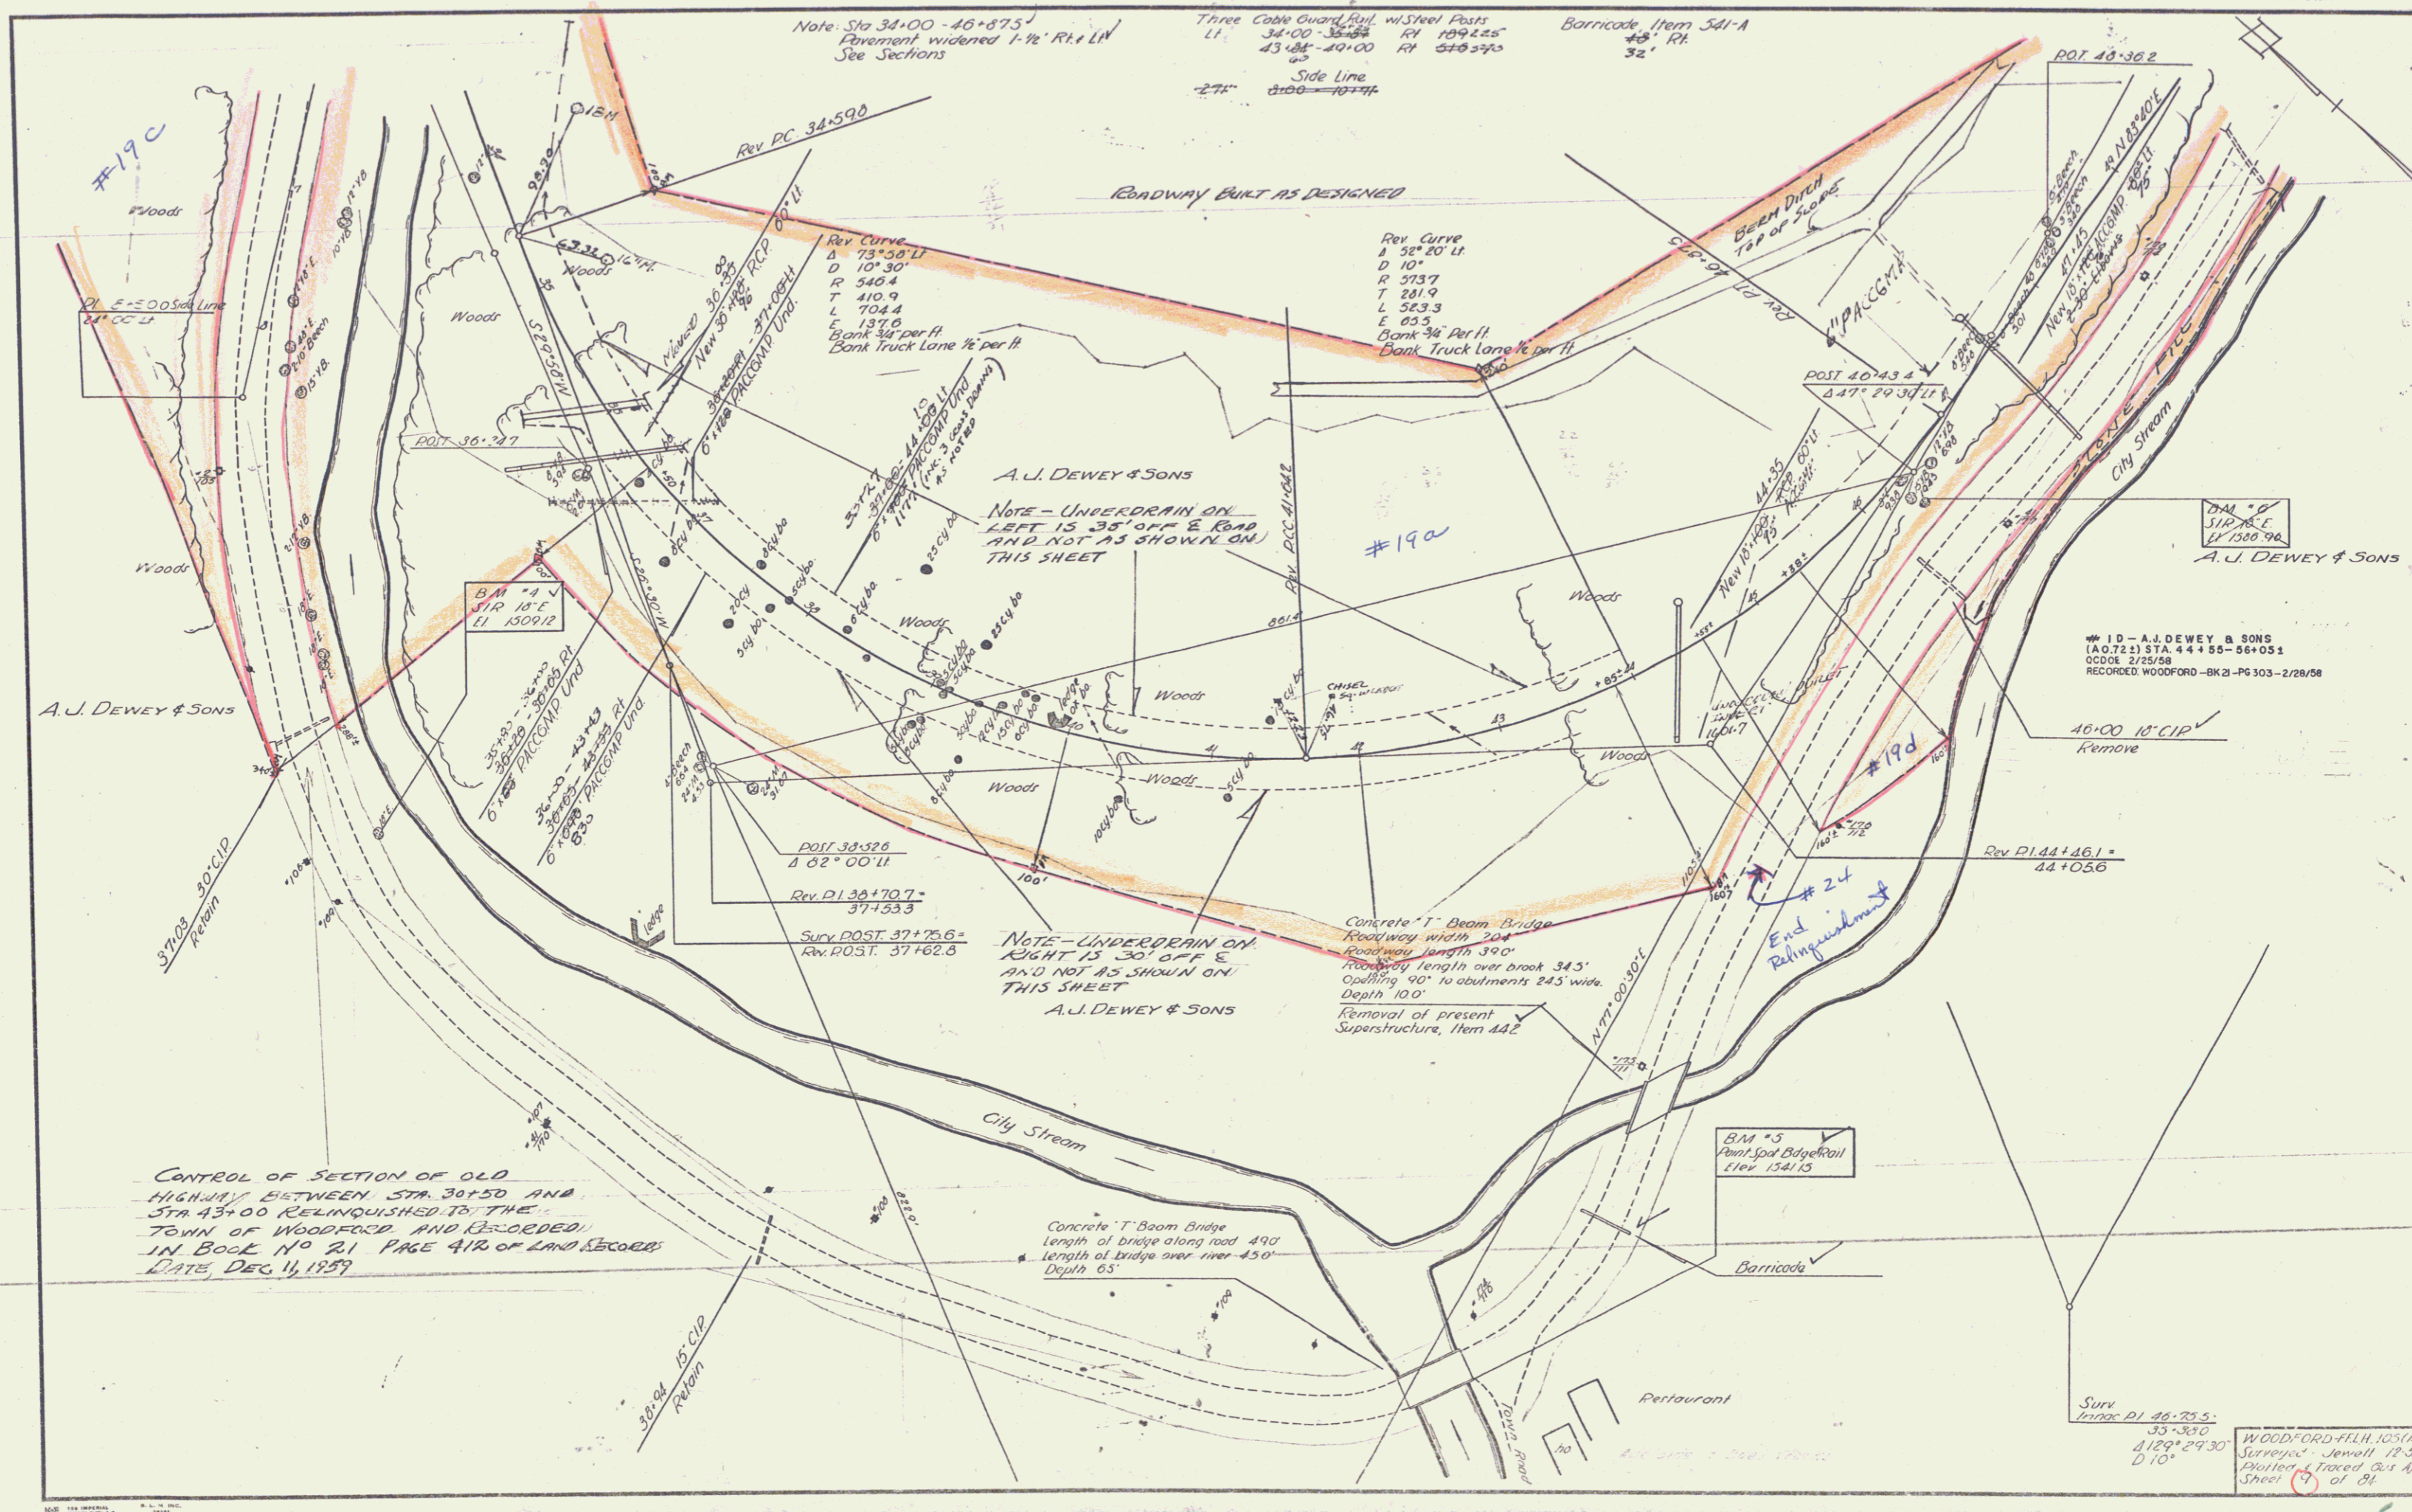

Note: Sta 34+00 - 46+875
 Pavement widened 1-1/2' R/L/LIN
 See Sections

Three Cable Guard Rail w/ Steel Posts
 LI 34+00 - 38+50 R/L 1094.25'
 43+00 - 40+00 R/L 510.575'

Barricade Item 541-A
 45' R/L
 32'

Side Line
 -27' 0+00 - 10+74'

ROADWAY BUILT AS DESIGNED

A.J. DEWEY & SONS
 NOTE - UNDERDRAIN ON
 LEFT IS 35' OFF E. ROAD
 AND NOT AS SHOWN ON
 THIS SHEET

A.J. DEWEY & SONS
 NOTE - UNDERDRAIN ON
 RIGHT IS 30' OFF E.
 AND NOT AS SHOWN ON
 THIS SHEET

CONTROL OF SECTION OF OLD
 HIGHWAY BETWEEN STA. 30+50 AND
 STA. 43+00 RELINQUISHED TO THE
 TOWN OF WOODFORD AND RECORDED
 IN BOOK NO 21 PAGE 41R OF LAND RECORDS
 DATE, DEC 11, 1957

Concrete T-Beam Bridge
 Roadway width 204'
 Roadway length 390'
 Roadway length over brook 34.5'
 Spacing 90' to abutments 24.5' wide
 Depth 10.0'
 Removal of present
 Superstructure, Item 442

Concrete T-Beam Bridge
 Length of bridge along road 490'
 Length of bridge over river 450'
 Depth 65'

Surv
 Horiz DI 46+75.5
 35-3650
 4129' 29' 30"
 D 10'

WOODFORD-FELH, 105(141)
 Surveyed - Jenell 12-56
 Plotted & Traced Oct 50
 Sheet 17 of 24

