



POTNAM  
 D. MACCHI  
 5/10/34

POTNAM  
 D. MACCHI  
 5/10/34

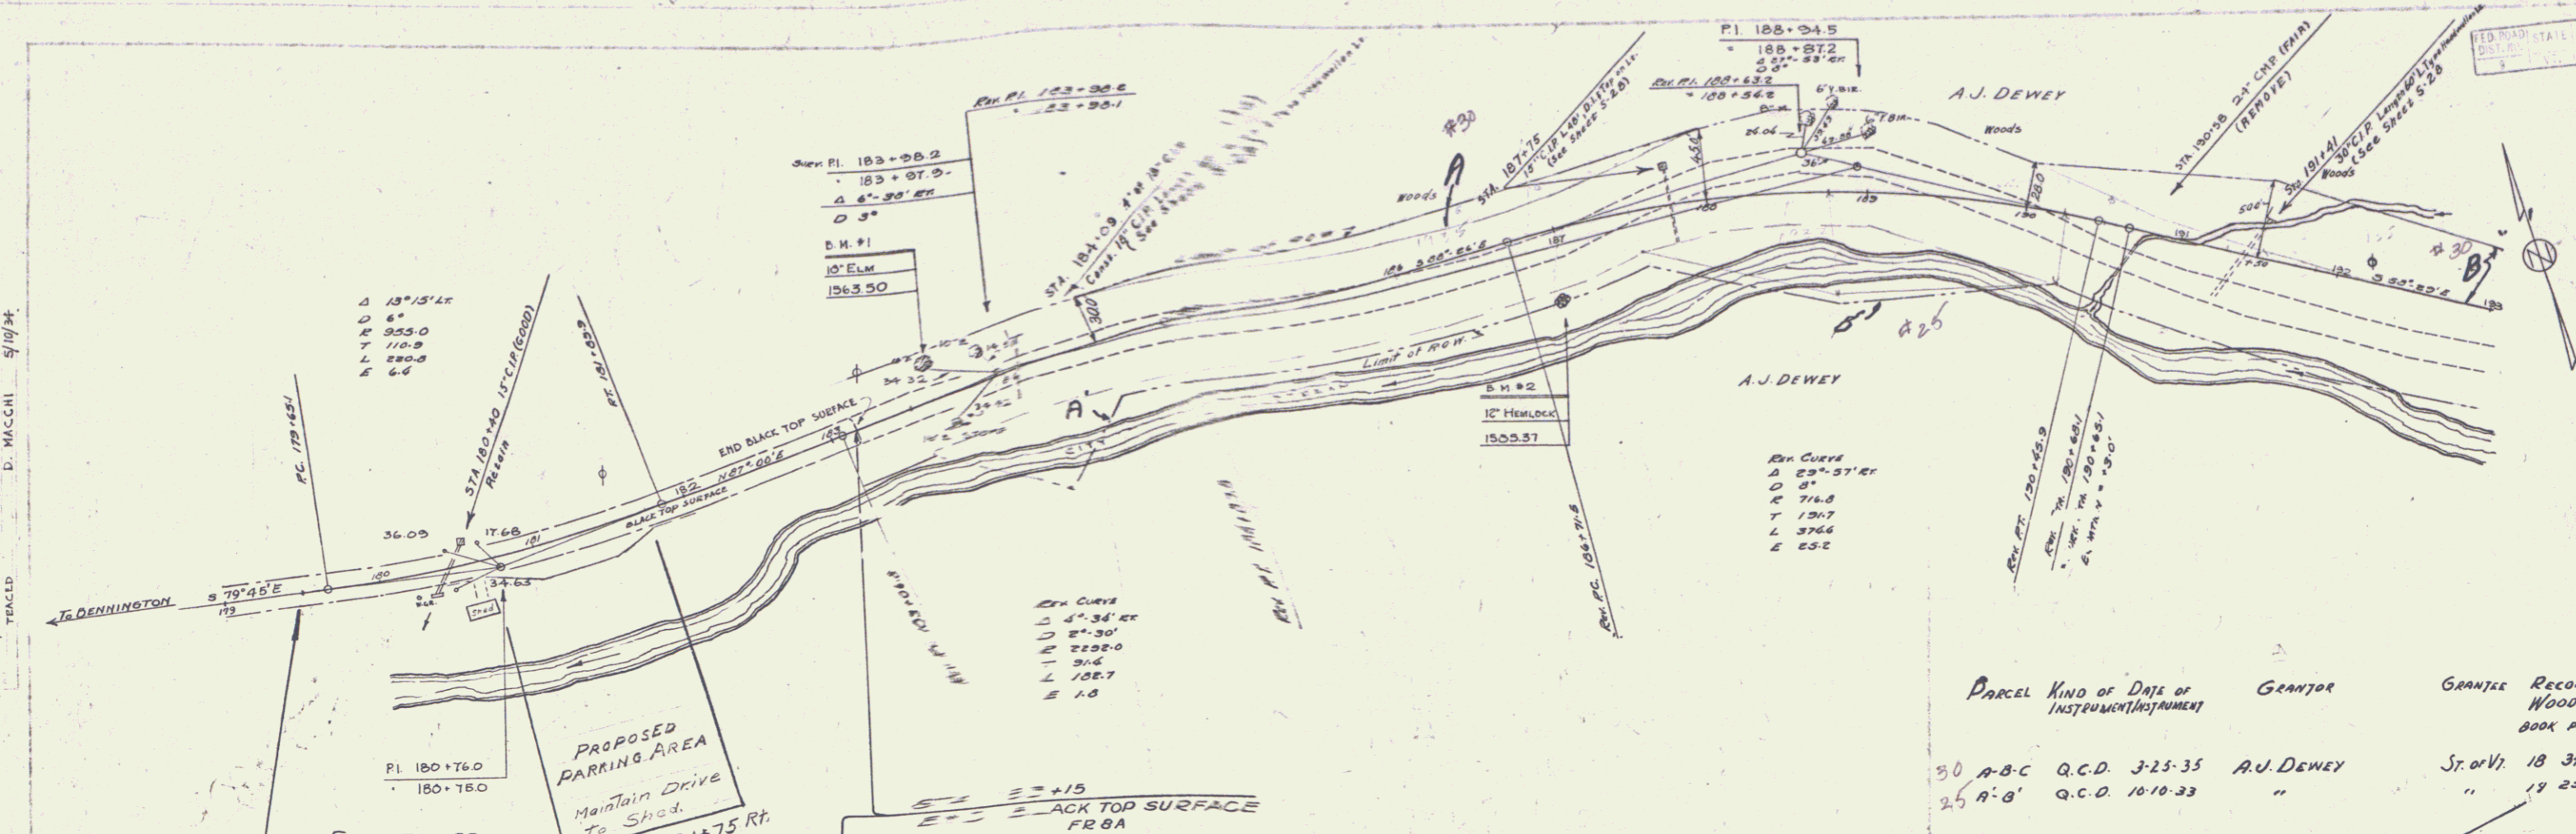

Parcel	Kind of Instrument	Date of Instrument	Grantor	Grantee	Recorded Woodford Book Page	Date	Remarks
30 A-B-C	Q.C.D.	3-23-35	A.J. DEWEY		18 346	3-27-35	
25 A-B	Q.C.D.	10-10-33	"		19 254	12-7-33	

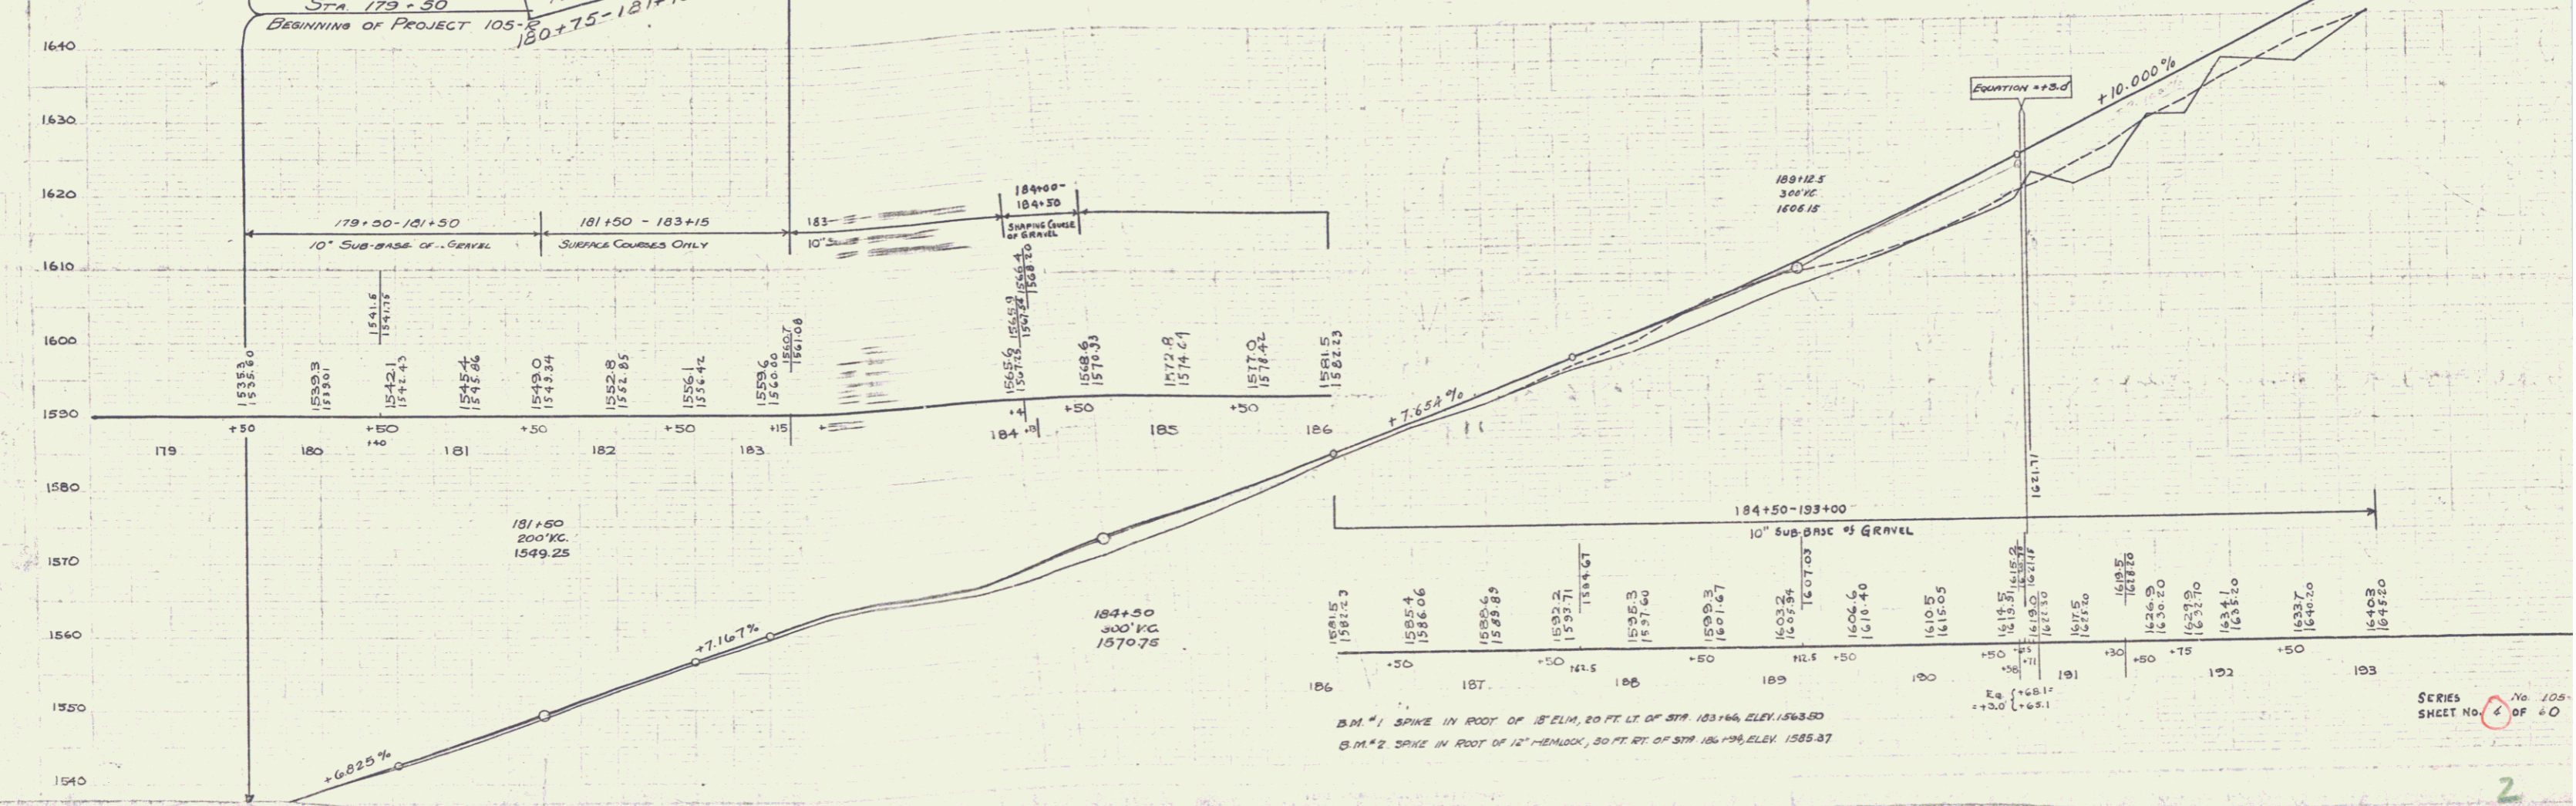

B.M. #1 SPIKE IN FOOT OF 18' ELM, 20 FT. LT. OF STA. 183+46, ELEV. 1563.83  
 B.M. #2 SPIKE IN FOOT OF 12' HEMLOCK, 30 FT. RT. OF STA. 186+96, ELEV. 1585.37