
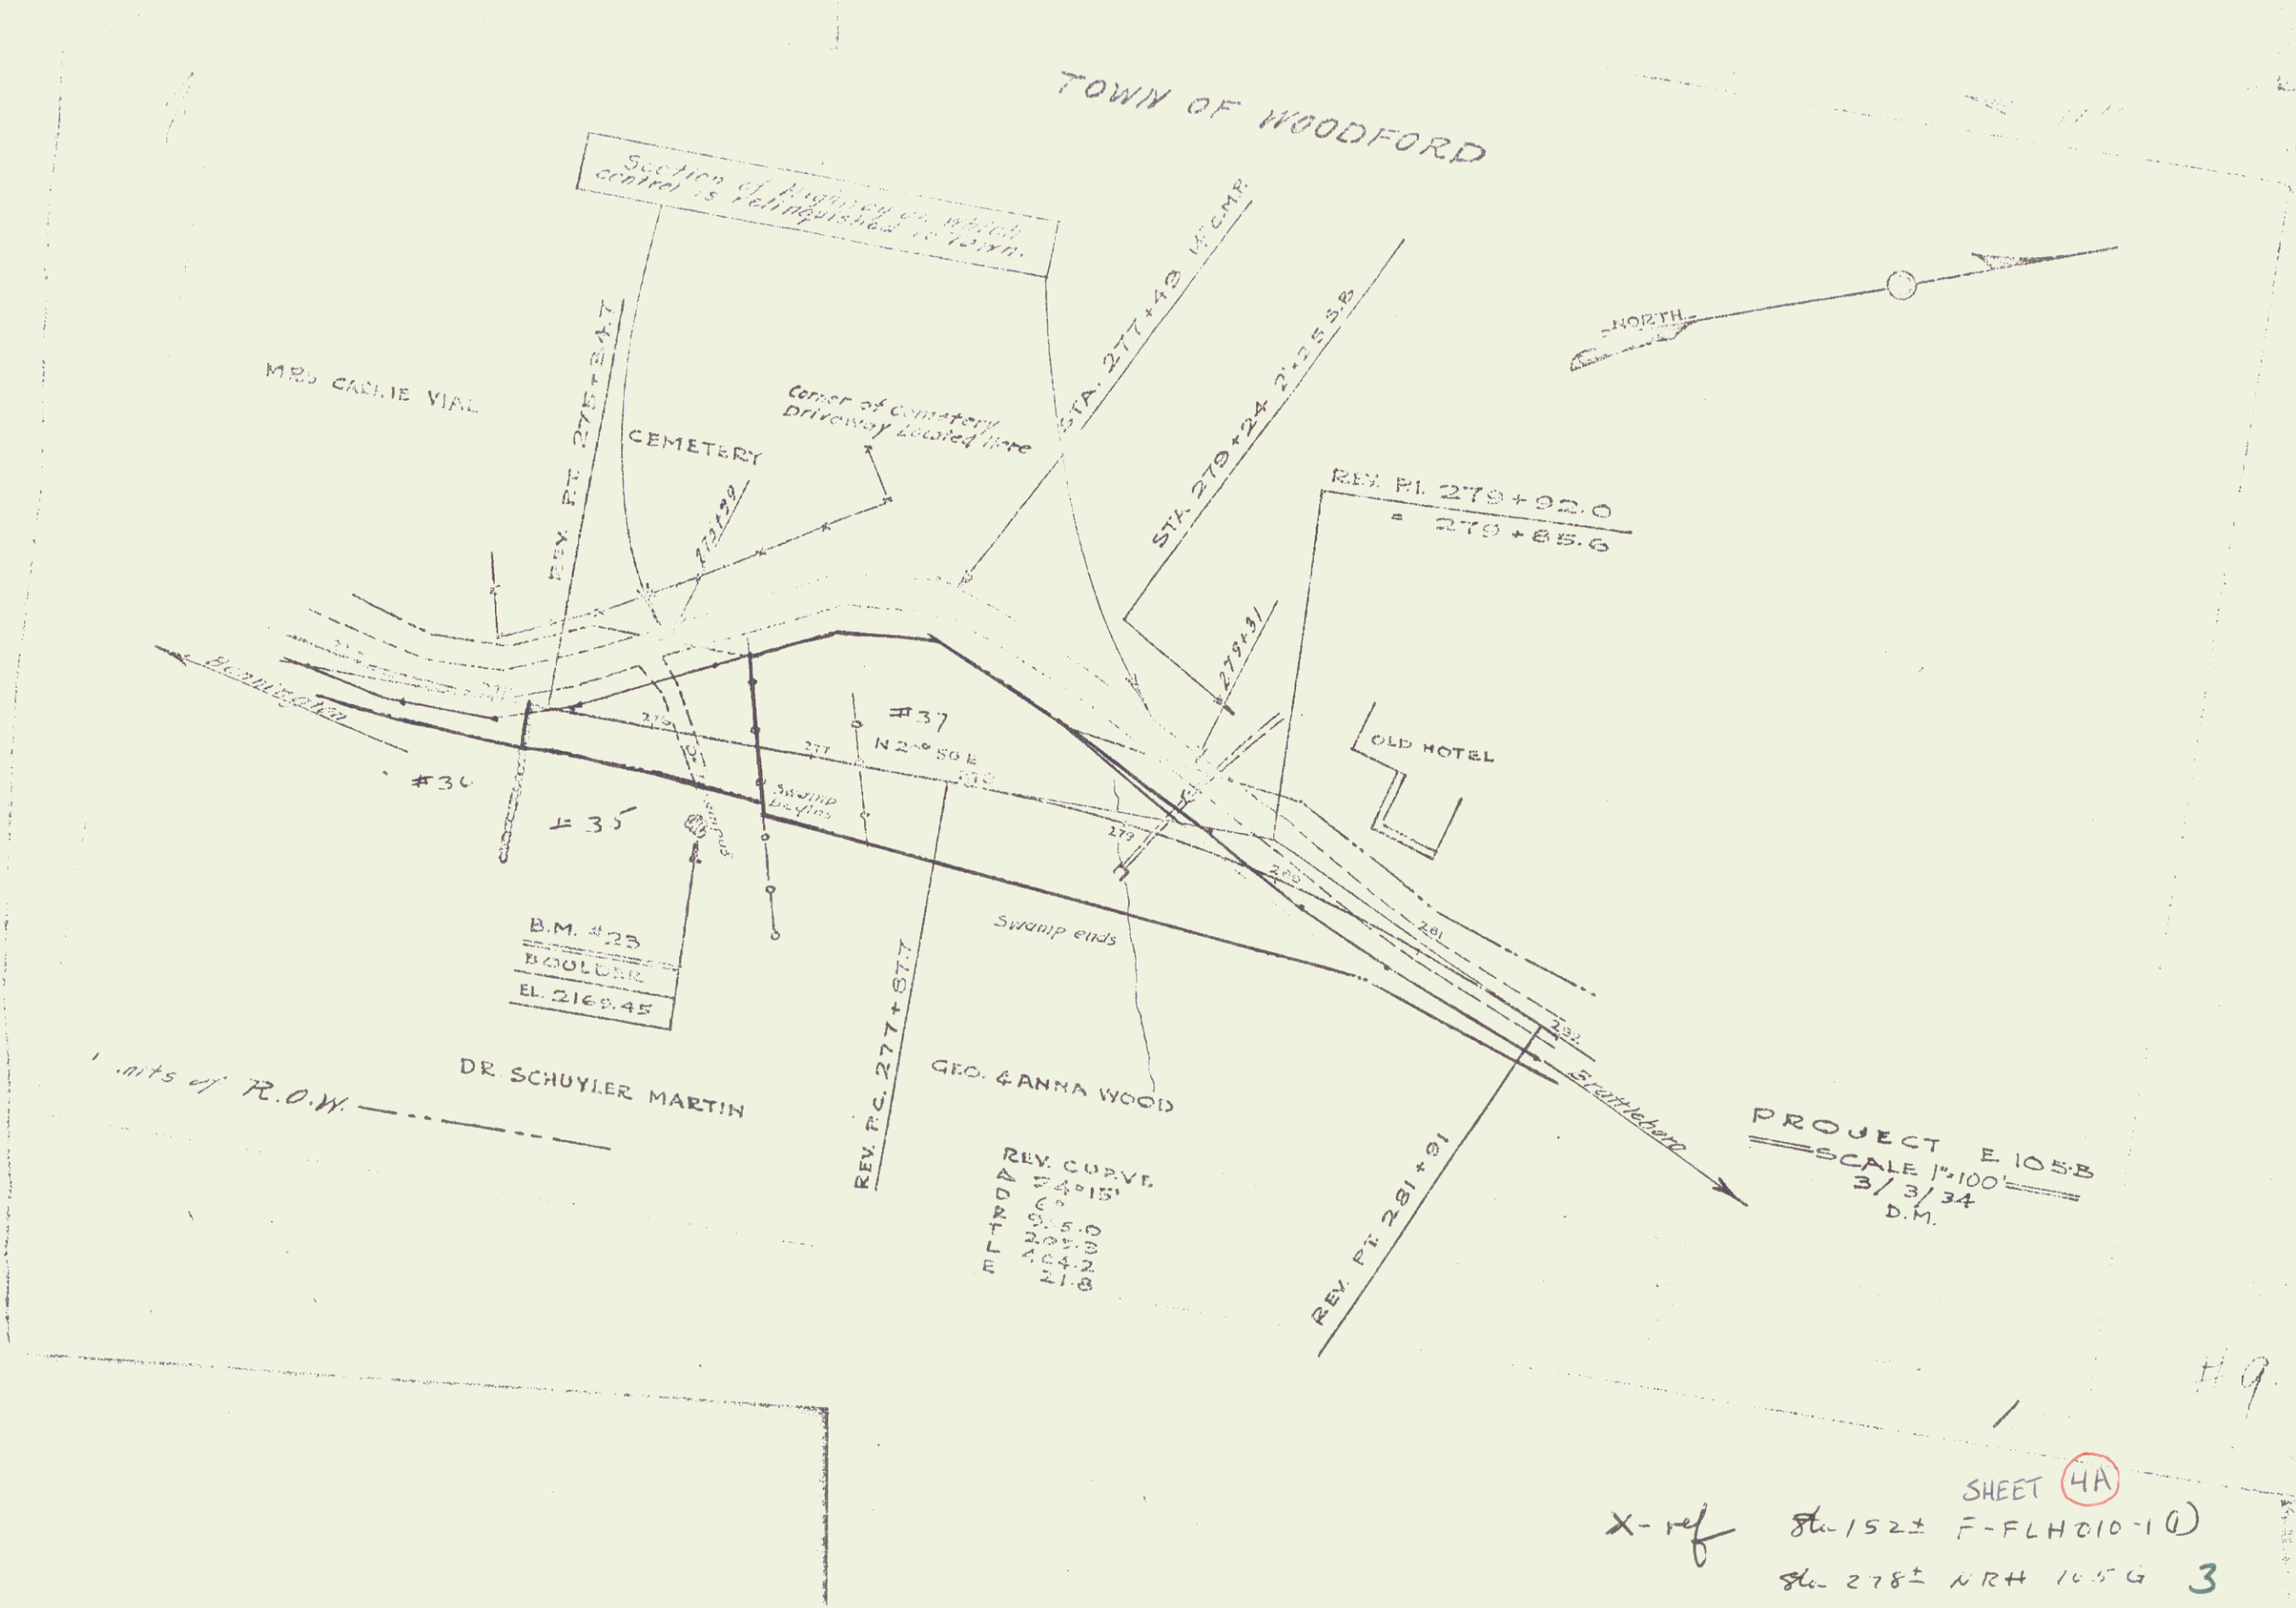


TOWN OF WOODFORD

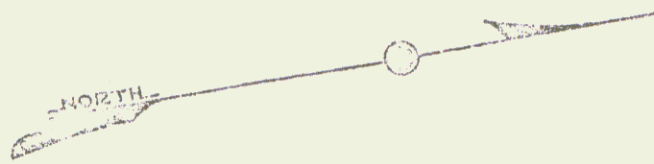

B.M. #23  
BOULDER  
EL. 2168.45

REV. CURVE  
RADIUS 54.15'  
CHORD 100.00  
ARC 104.2  
PI-B

PROJECT E 105B  
SCALE 1"=100'  
3/3/34  
D.M.

X-ref Sta 152± F-FLH010-10  
Sta 278± NR+ 1054 3

H9

SHEET 4A