
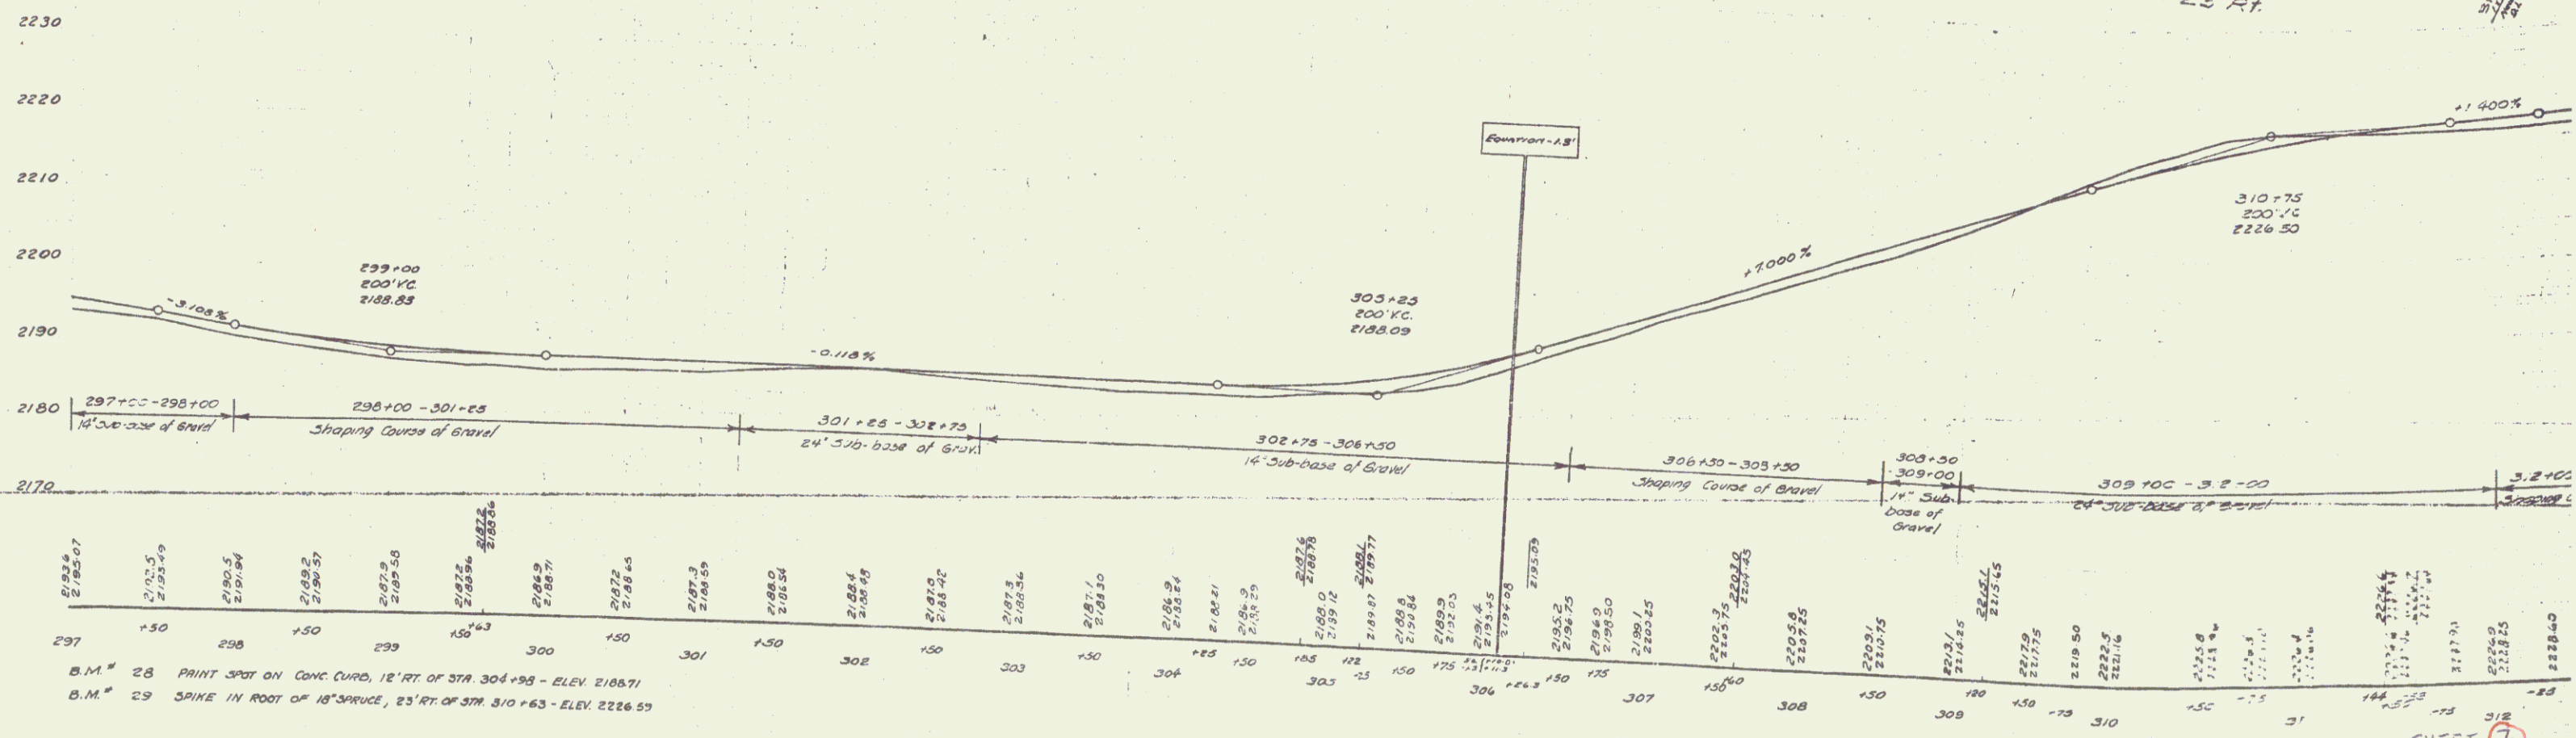


POTINAK
D. MACCHI
5/17/74
D. MACCHI

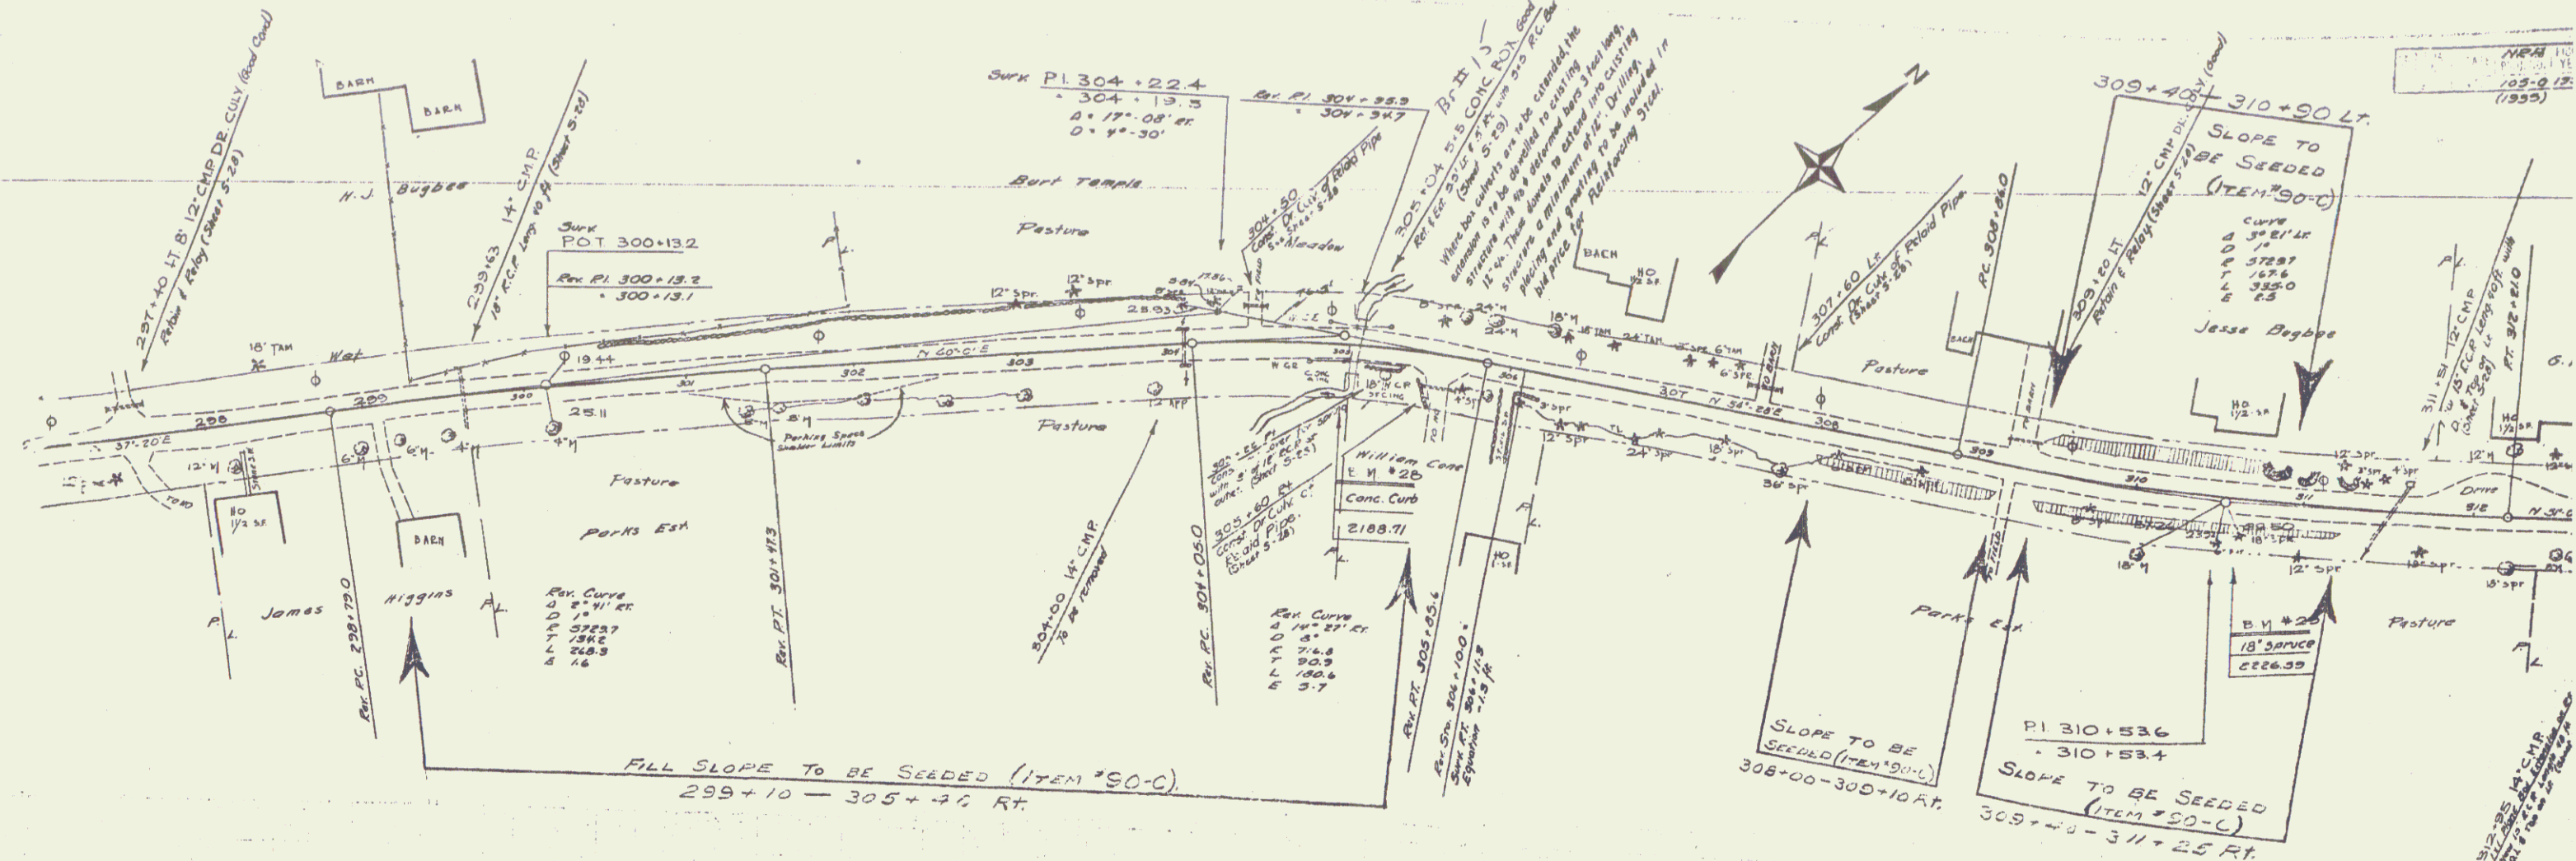

B.M. # 28 PRINT SPOT ON CONC. CURB, 12' RT. OF STA. 304+98 - ELEV. 2186.71
 B.M. # 29 SNAKE IN ROOT OF 18" BRIDGE, 25' RT. OF STA. 310+63 - ELEV. 2226.59