



POTNAM  
D. MACCHI  
5/9/74

POTNAM  
D. MACCHI

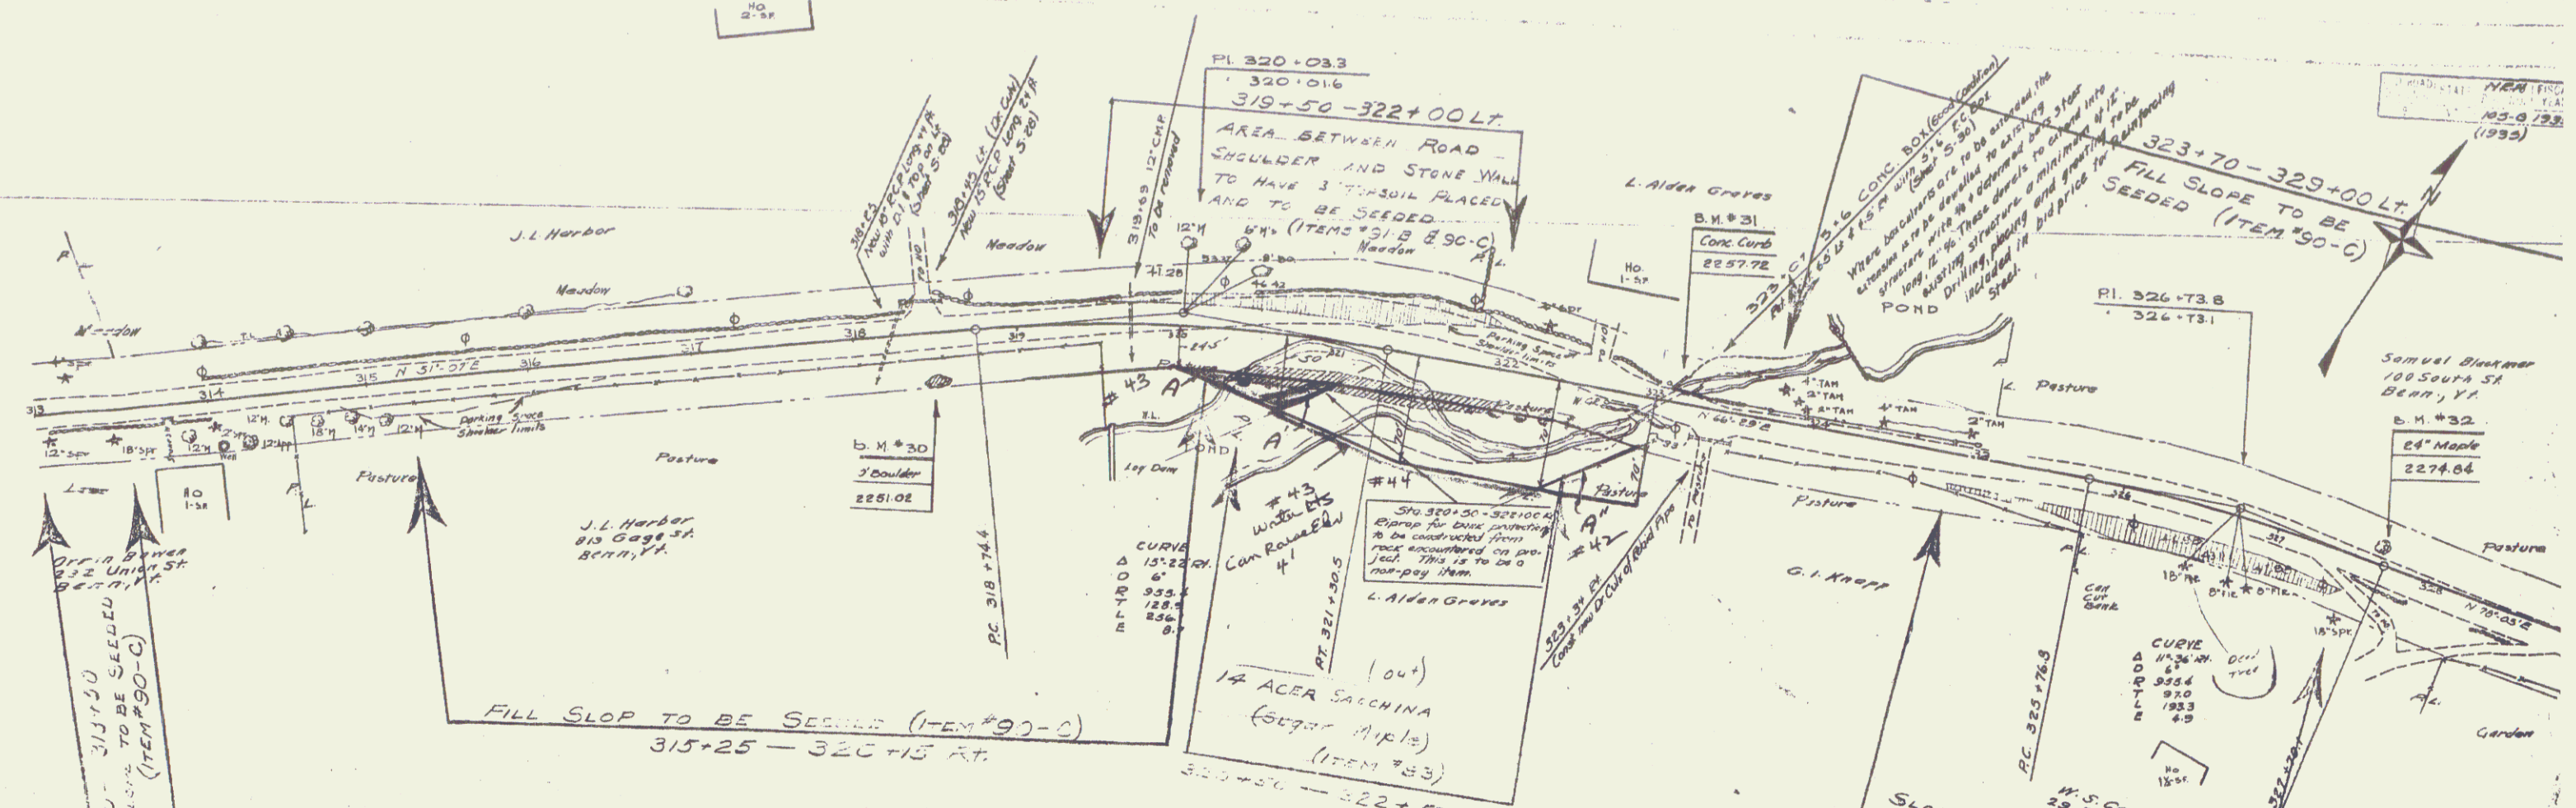

Parcel	Kind of Instrument	Date of Instrument	Grantor	Grantee	Recorded	Remarks
43 A	W.D.	12-26-34	J. L. Harbour	J. of W.	10 324 12-26-34	
44 A	O.C.D.	2-23-35	J. L. Harbour	"	10 324 2-23-35	
45 A	O.C.D.	12-31-34	Geo. I. Knapp	"	10 324 12-31-34	

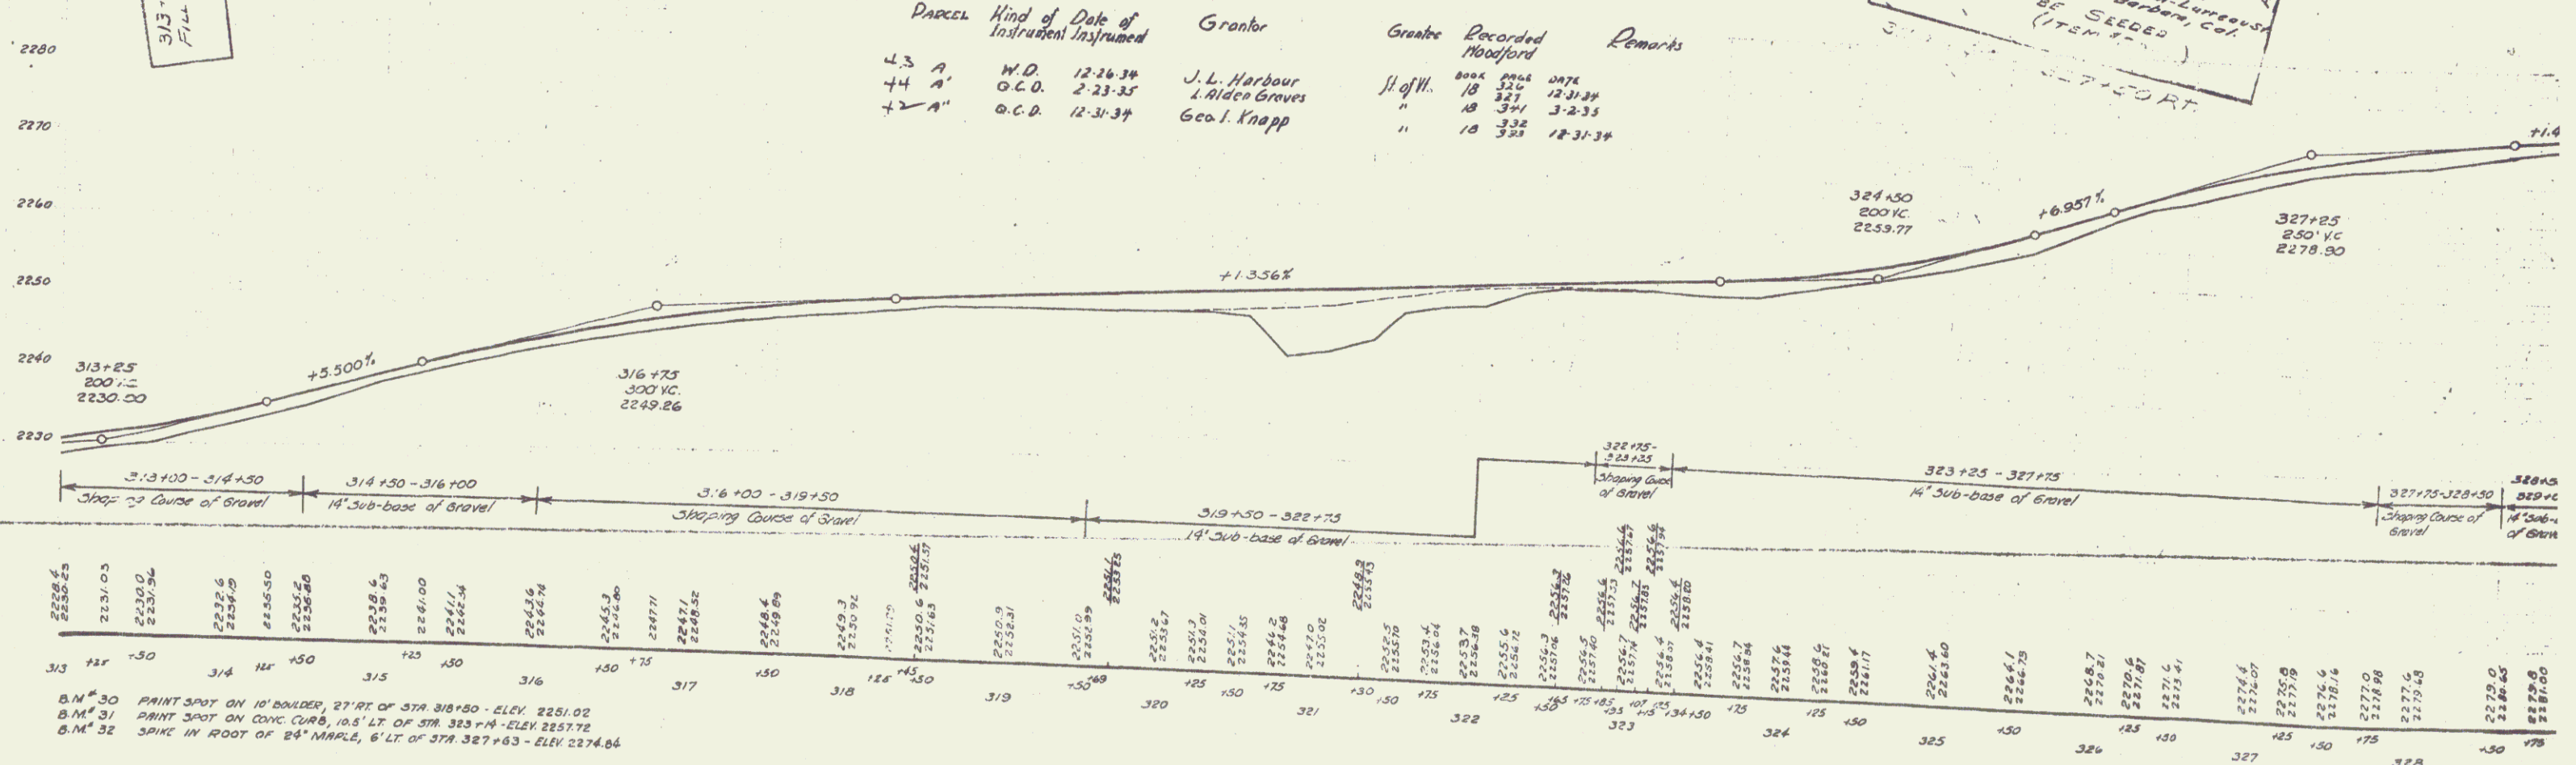

Station	Elevation	Station	Elevation	Station	Elevation	Station	Elevation
313	2230.00	314	2235.00	315	2240.00	316	2245.00
317	2250.00	318	2255.00	319	2260.00	320	2265.00
321	2270.00	322	2275.00	323	2280.00	324	2285.00
325	2290.00	326	2295.00	327	2300.00	328	2305.00

B.M. #30 PRINT SPOT ON 10' BOULDER, 27' RT. OF STA 318+50 - ELEV. 2251.02  
 B.M. #31 PRINT SPOT ON CONC CURB, 10.5' LT. OF STA 323+00 - ELEV. 2257.72  
 B.M. #32 SPIKE IN ROOT OF 24" MAPLE, 6' LT. OF STA 327+63 - ELEV. 2274.04