


Parcel	Kind of	Date of	Grantor	Grantee	Recorded	Remarks
45	CUA	N.D.	12-27-34 S.H. BLANCHARD & F.A. MERRICK	St. J. H.	800X PAGE DATE 12-31-34	CUL STA 329+05

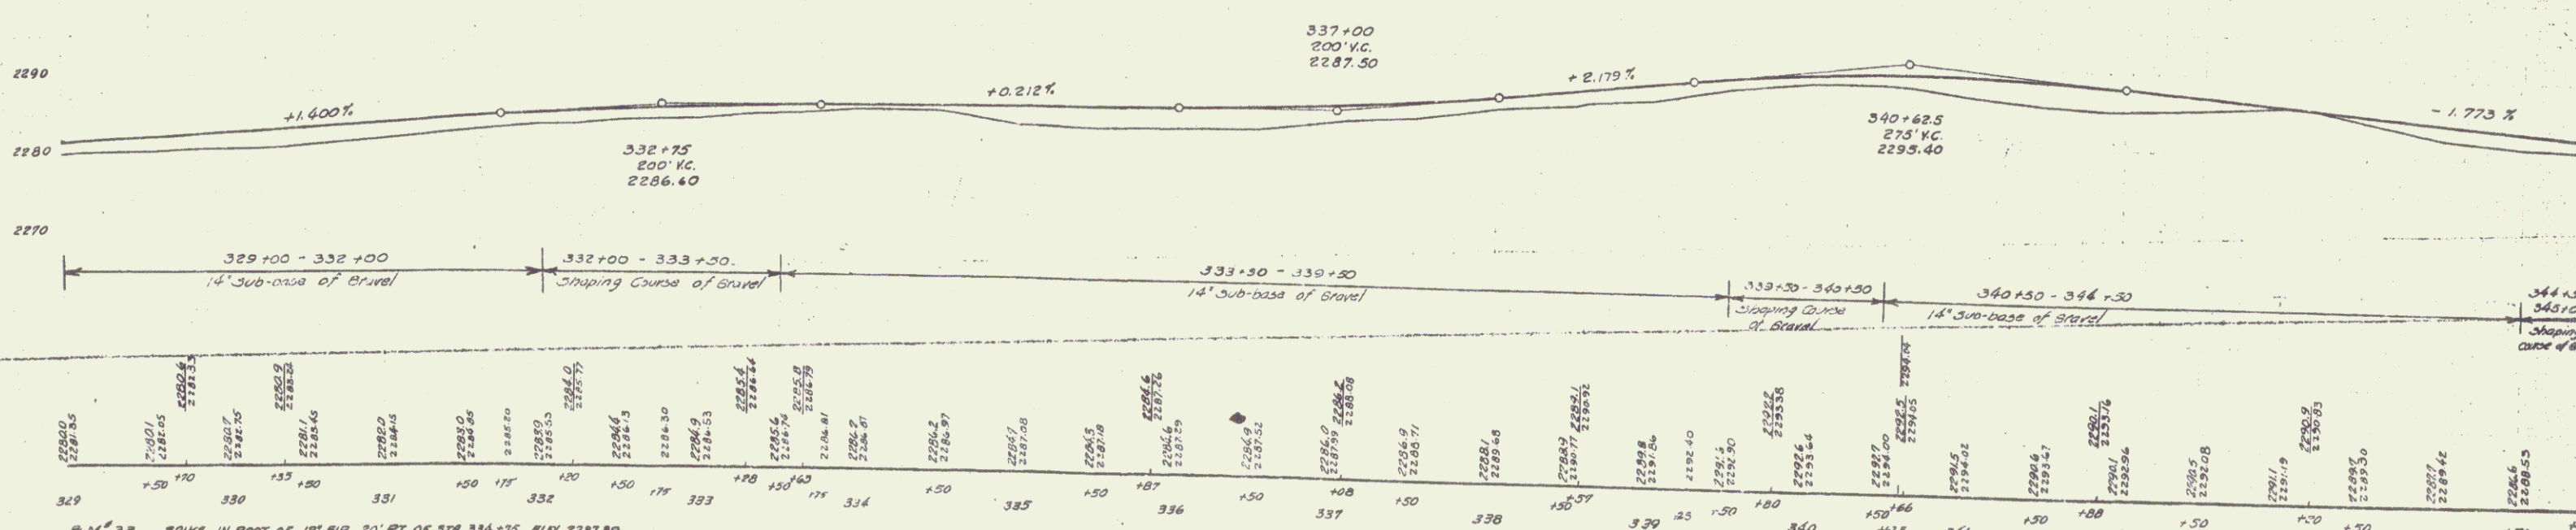

B.M. 33 SPIKE IN ROOT OF 12" FIR, 20' RT. OF STA 334+75, ELEV. 2287.89  
 B.M. 34 SPIKE IN ROOT OF 12" FIR STUMP, 20' RT. OF STA 341+71, ELEV. 2295.81