
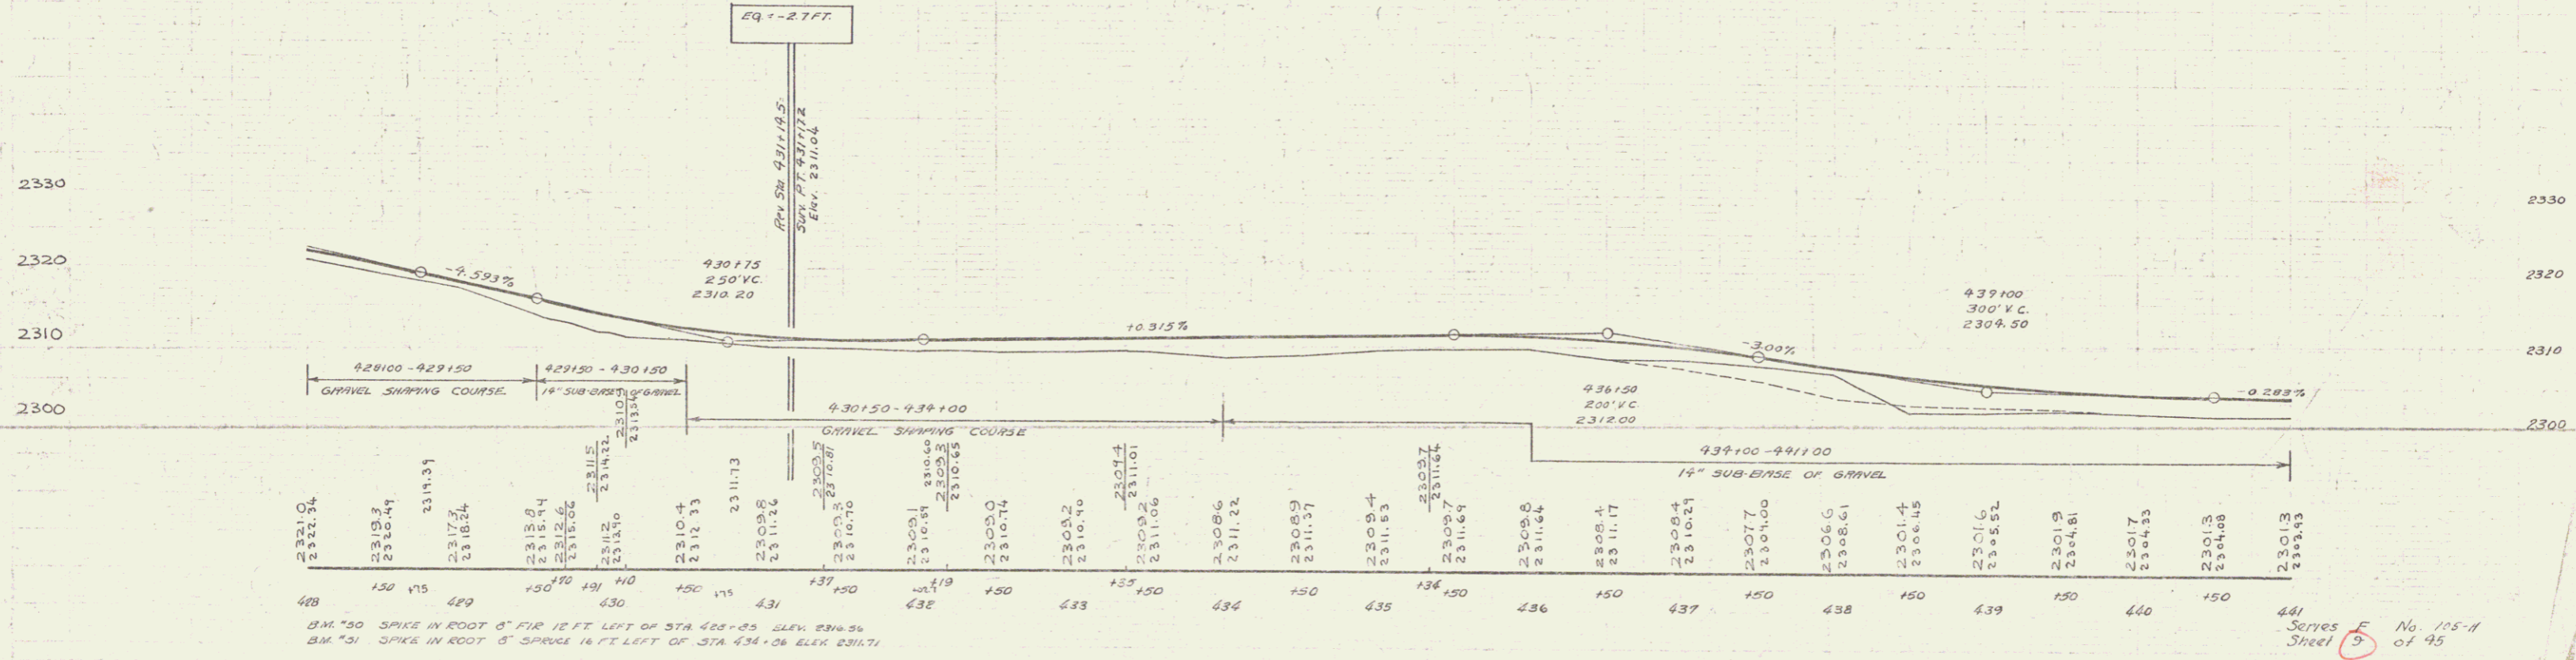


ESTABLISHED
D. MACCHI
4/1/34
D. MACCHI

FED. ROAD DIST. NO.	STATE	FED. AID PROJ. NO.	FISCAL YEAR	SHEET NO.	TOTAL SHEETS
9	VT	105-A	1936	9	95

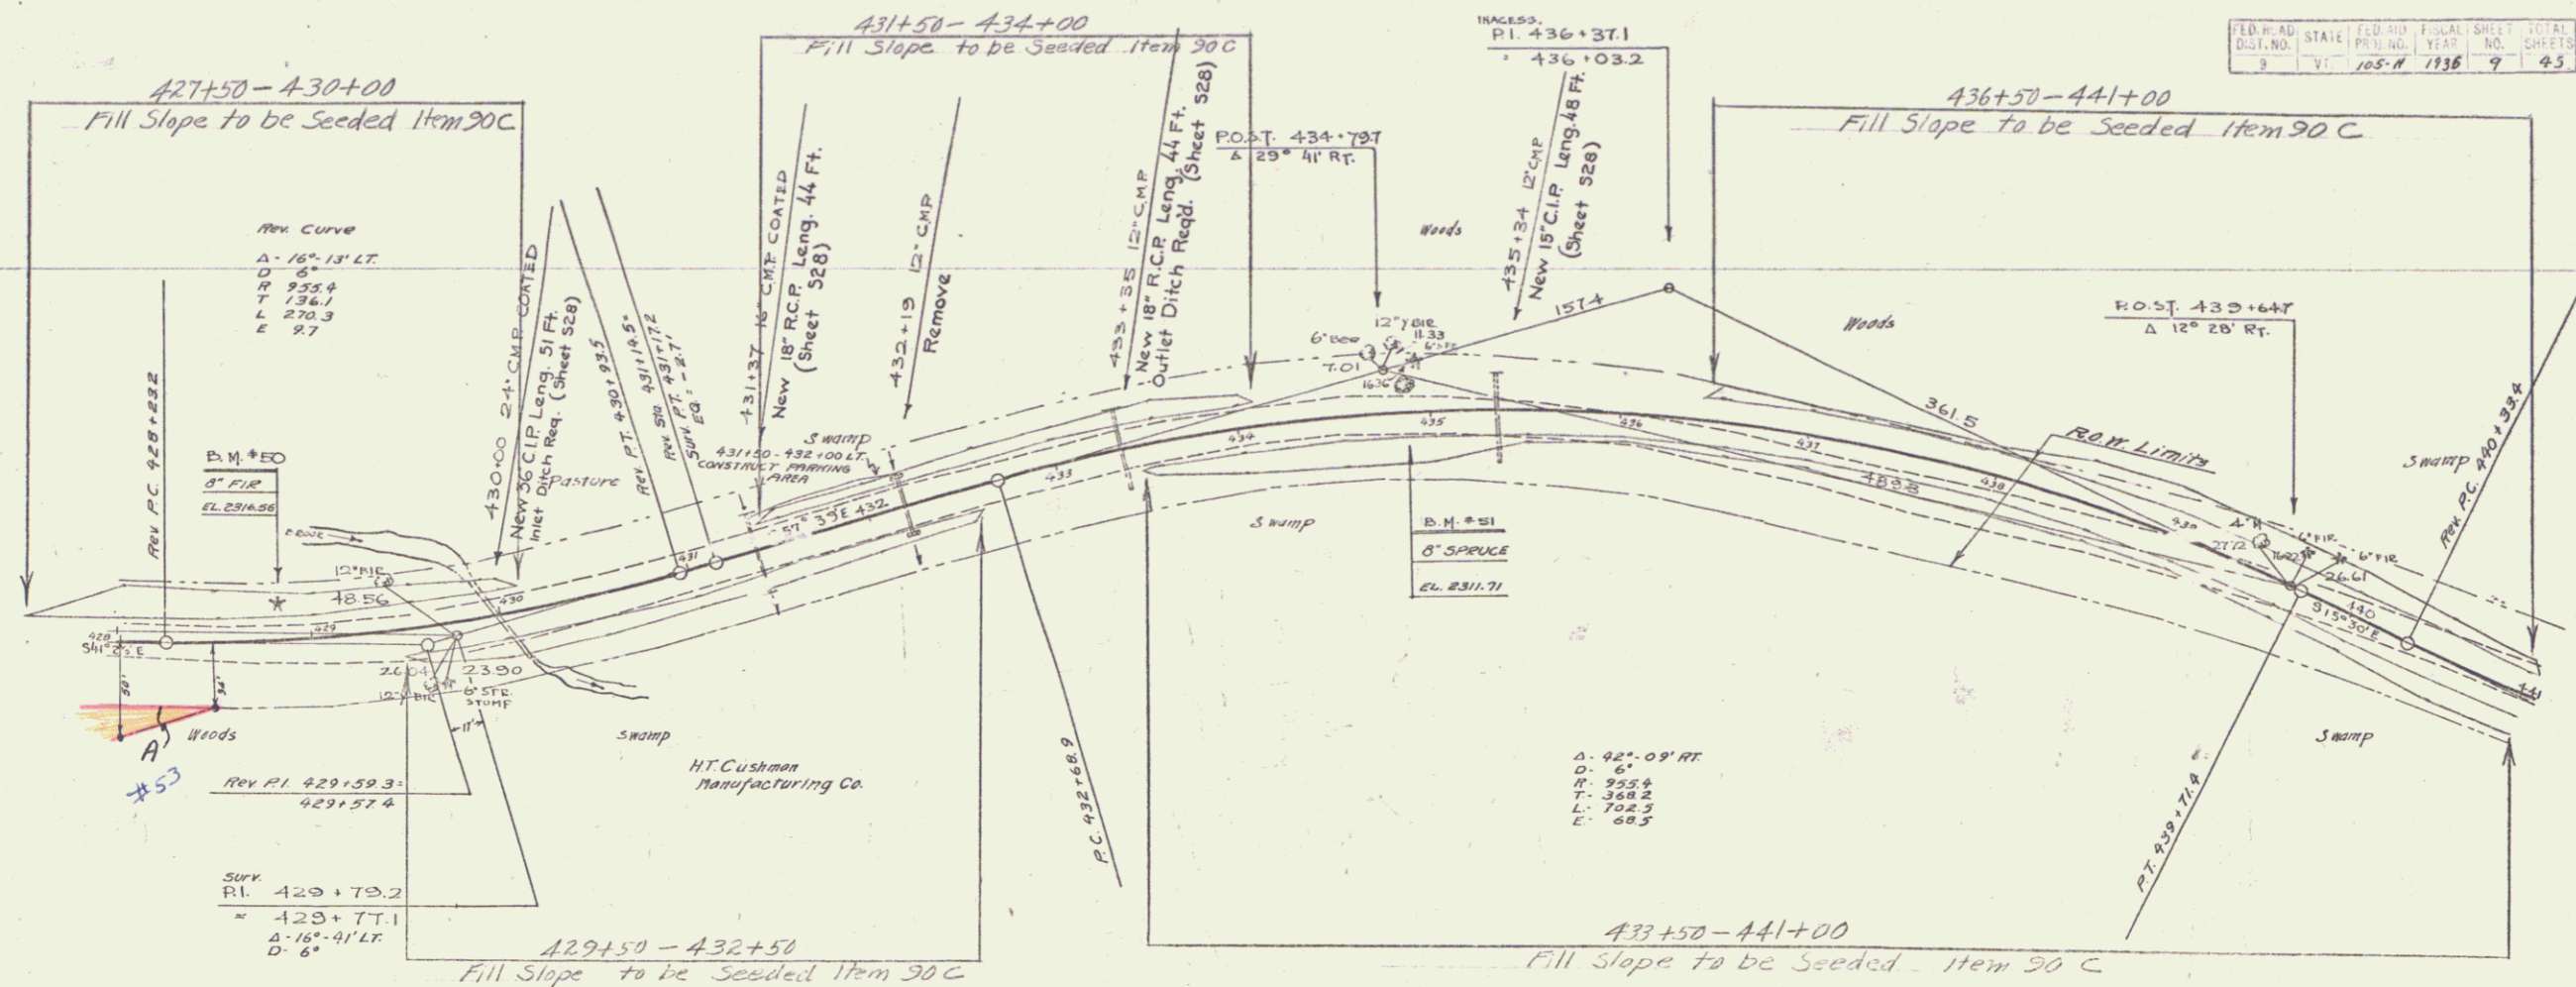

441 Serves E No. 105-A
 Sheet 9 of 95