



PUTNAM
D. MACCHI 6/1/54

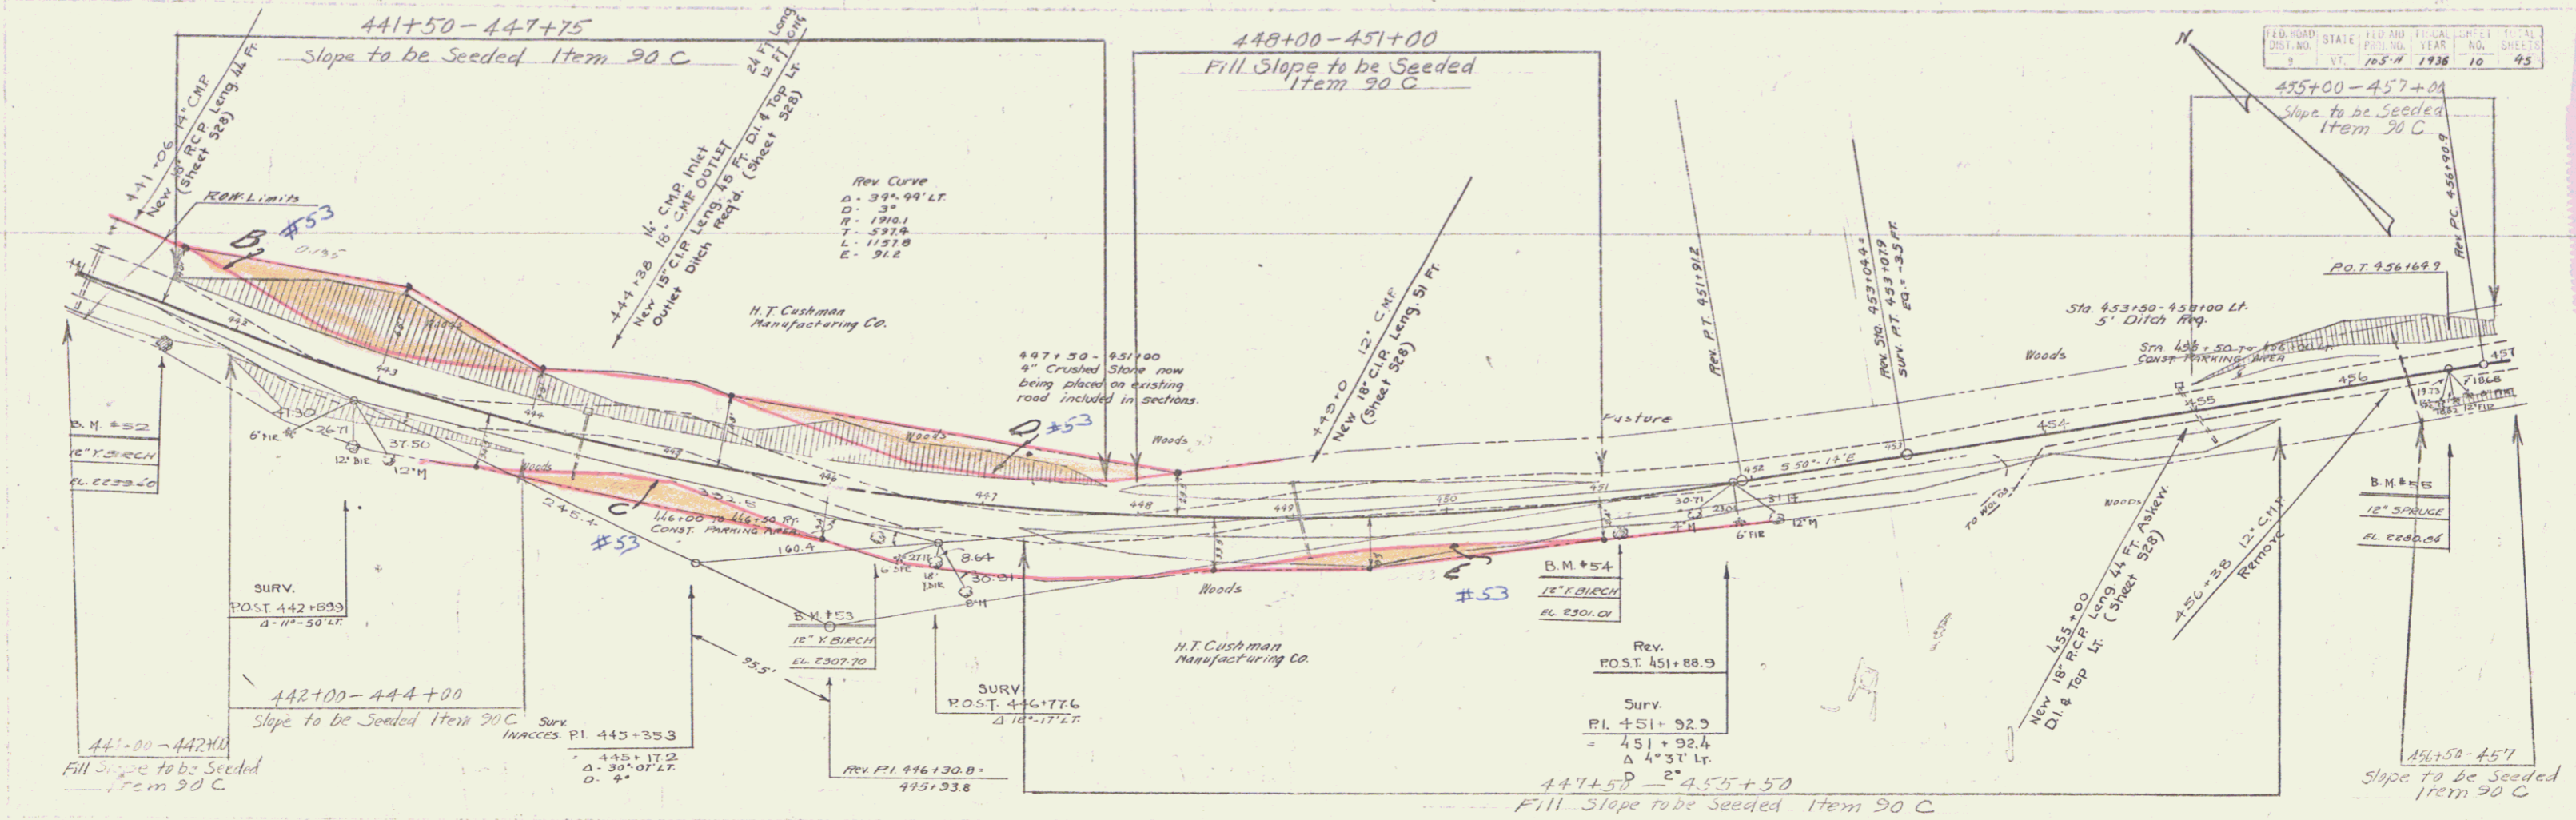

PARCEL	KIND OF INSTRUMENT	DATE OF INSTRUMENT	OWNER	GENETIC RECORD	RECORDS	REMARKS
1800E	O.C.D.	6-29-25	H.T. Cushman Manufacturing Co.	Spur V.	18 363 6-27-35	

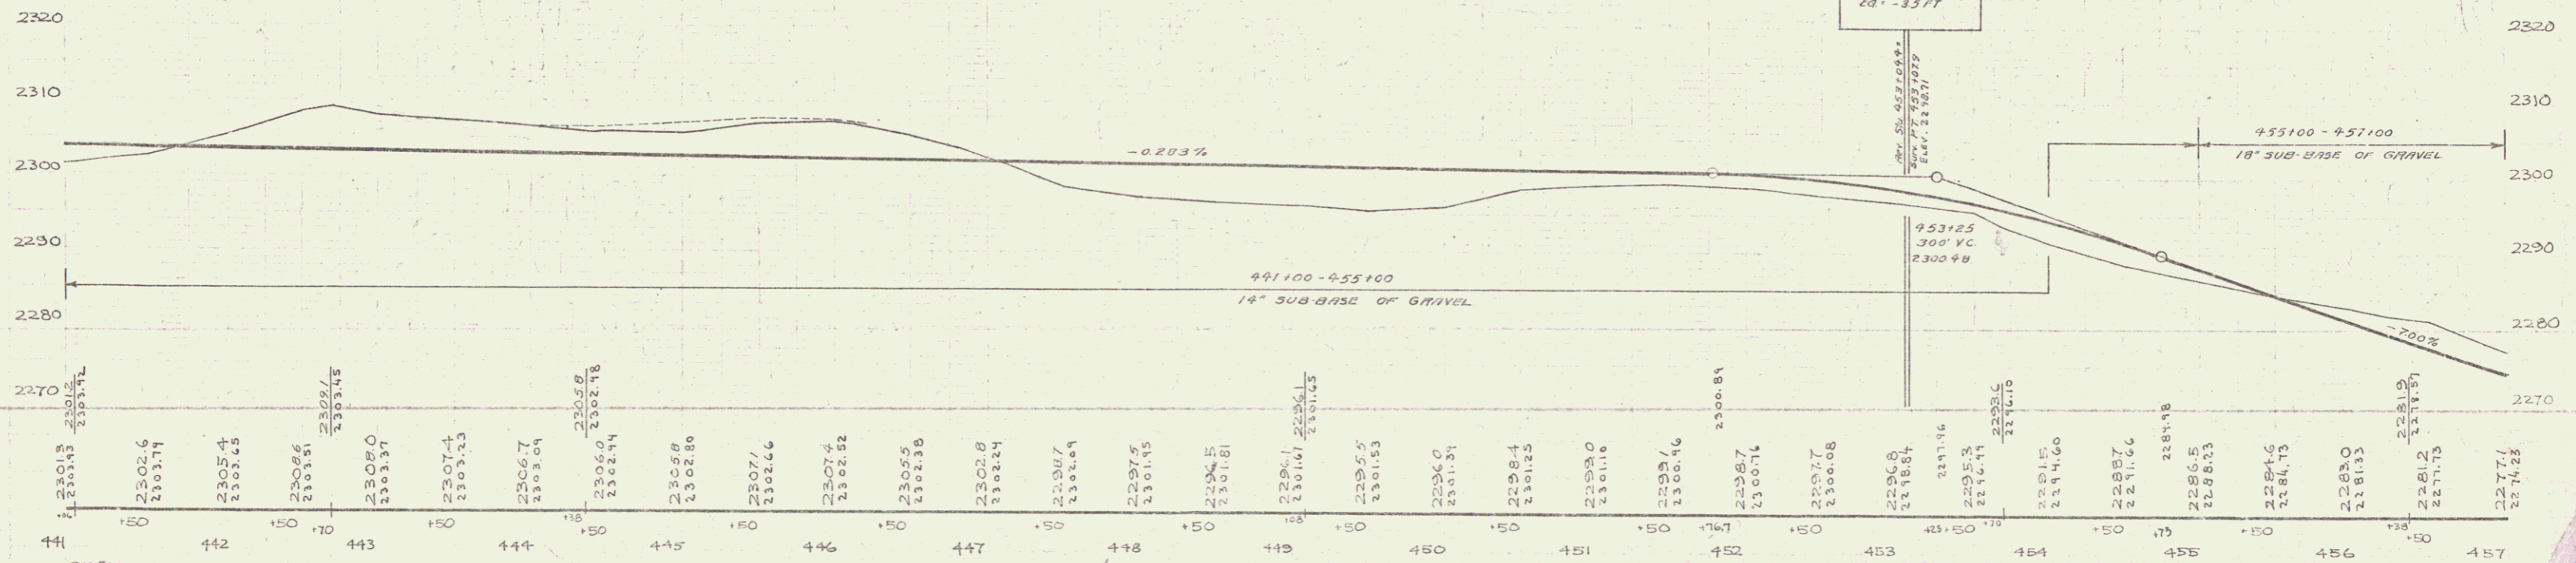

B.M. #52 SPIKE IN ROOT 12" YELLOW BIRCH 15 FT. RT. OF STA. 441+62 ELEV. 2295.60
 B.M. #53 SPIKE IN ROOT 12" YELLOW BIRCH 15 FT. RT. OF STA. 446+26 ELEV. 2302.70
 B.M. #54 SPIKE IN ROOT 12" YELLOW BIRCH 23 FT. RT. OF STA. 451+17 ELEV. 2301.01
 B.M. #55 SPIKE IN ROOT 12" SPRUCE 13 FT. RT. OF STA. 456+53 ELEV. 2290.84

Series E No. 105-4
 Sheet 10 of 45

8