
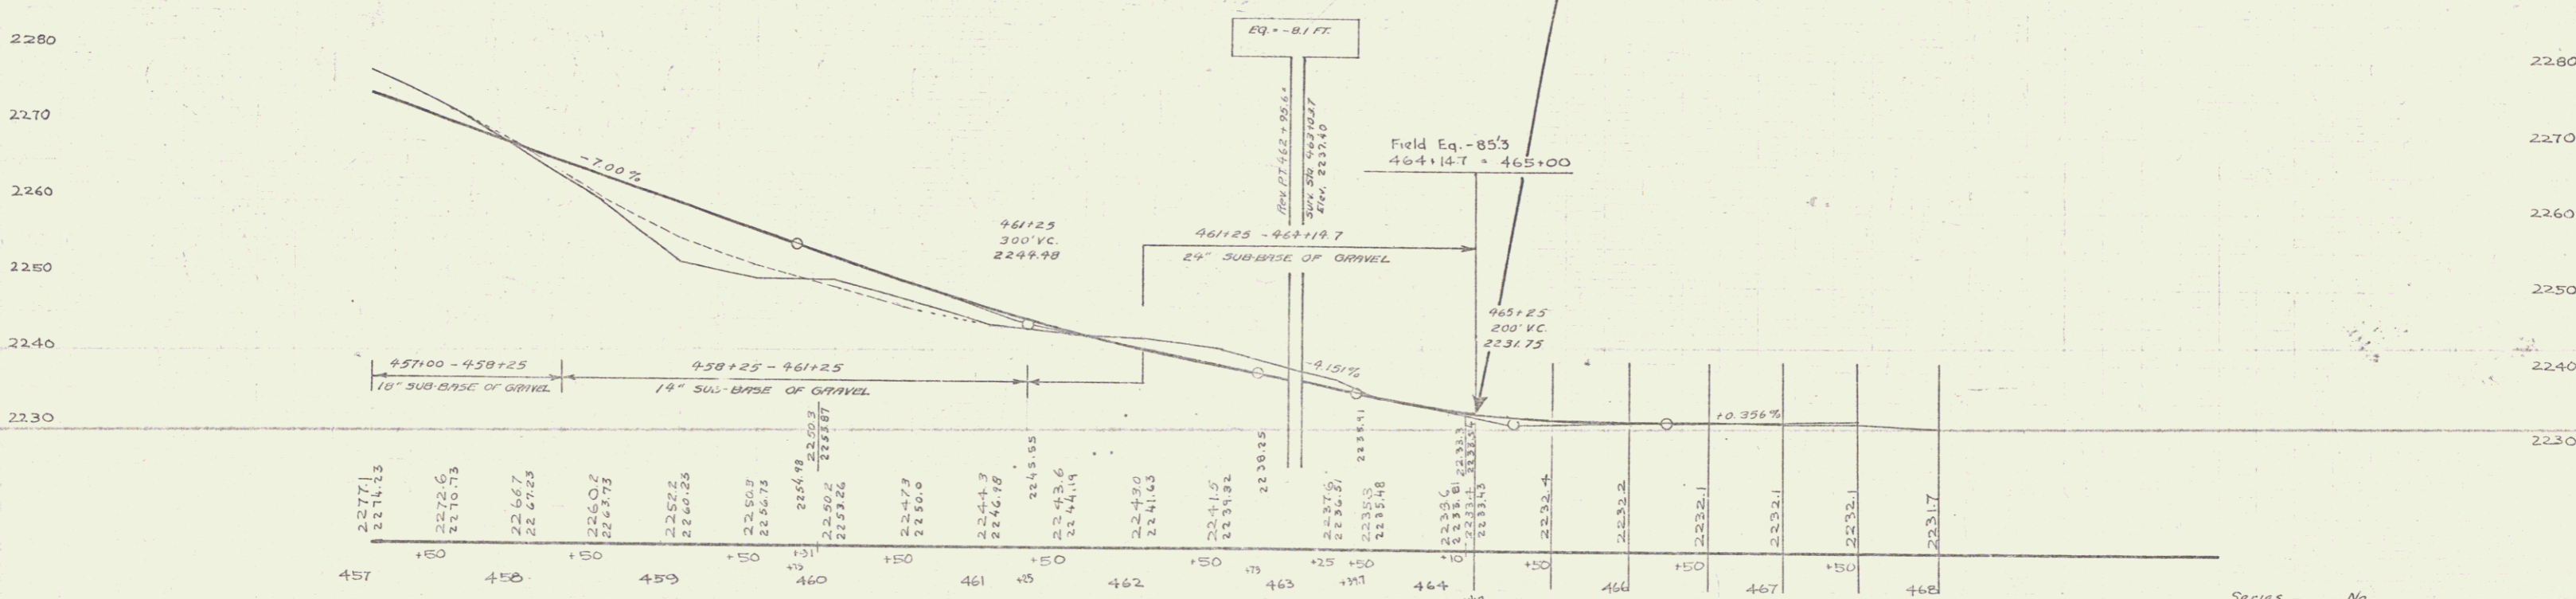


B. MACCHI
 D. MACCHI

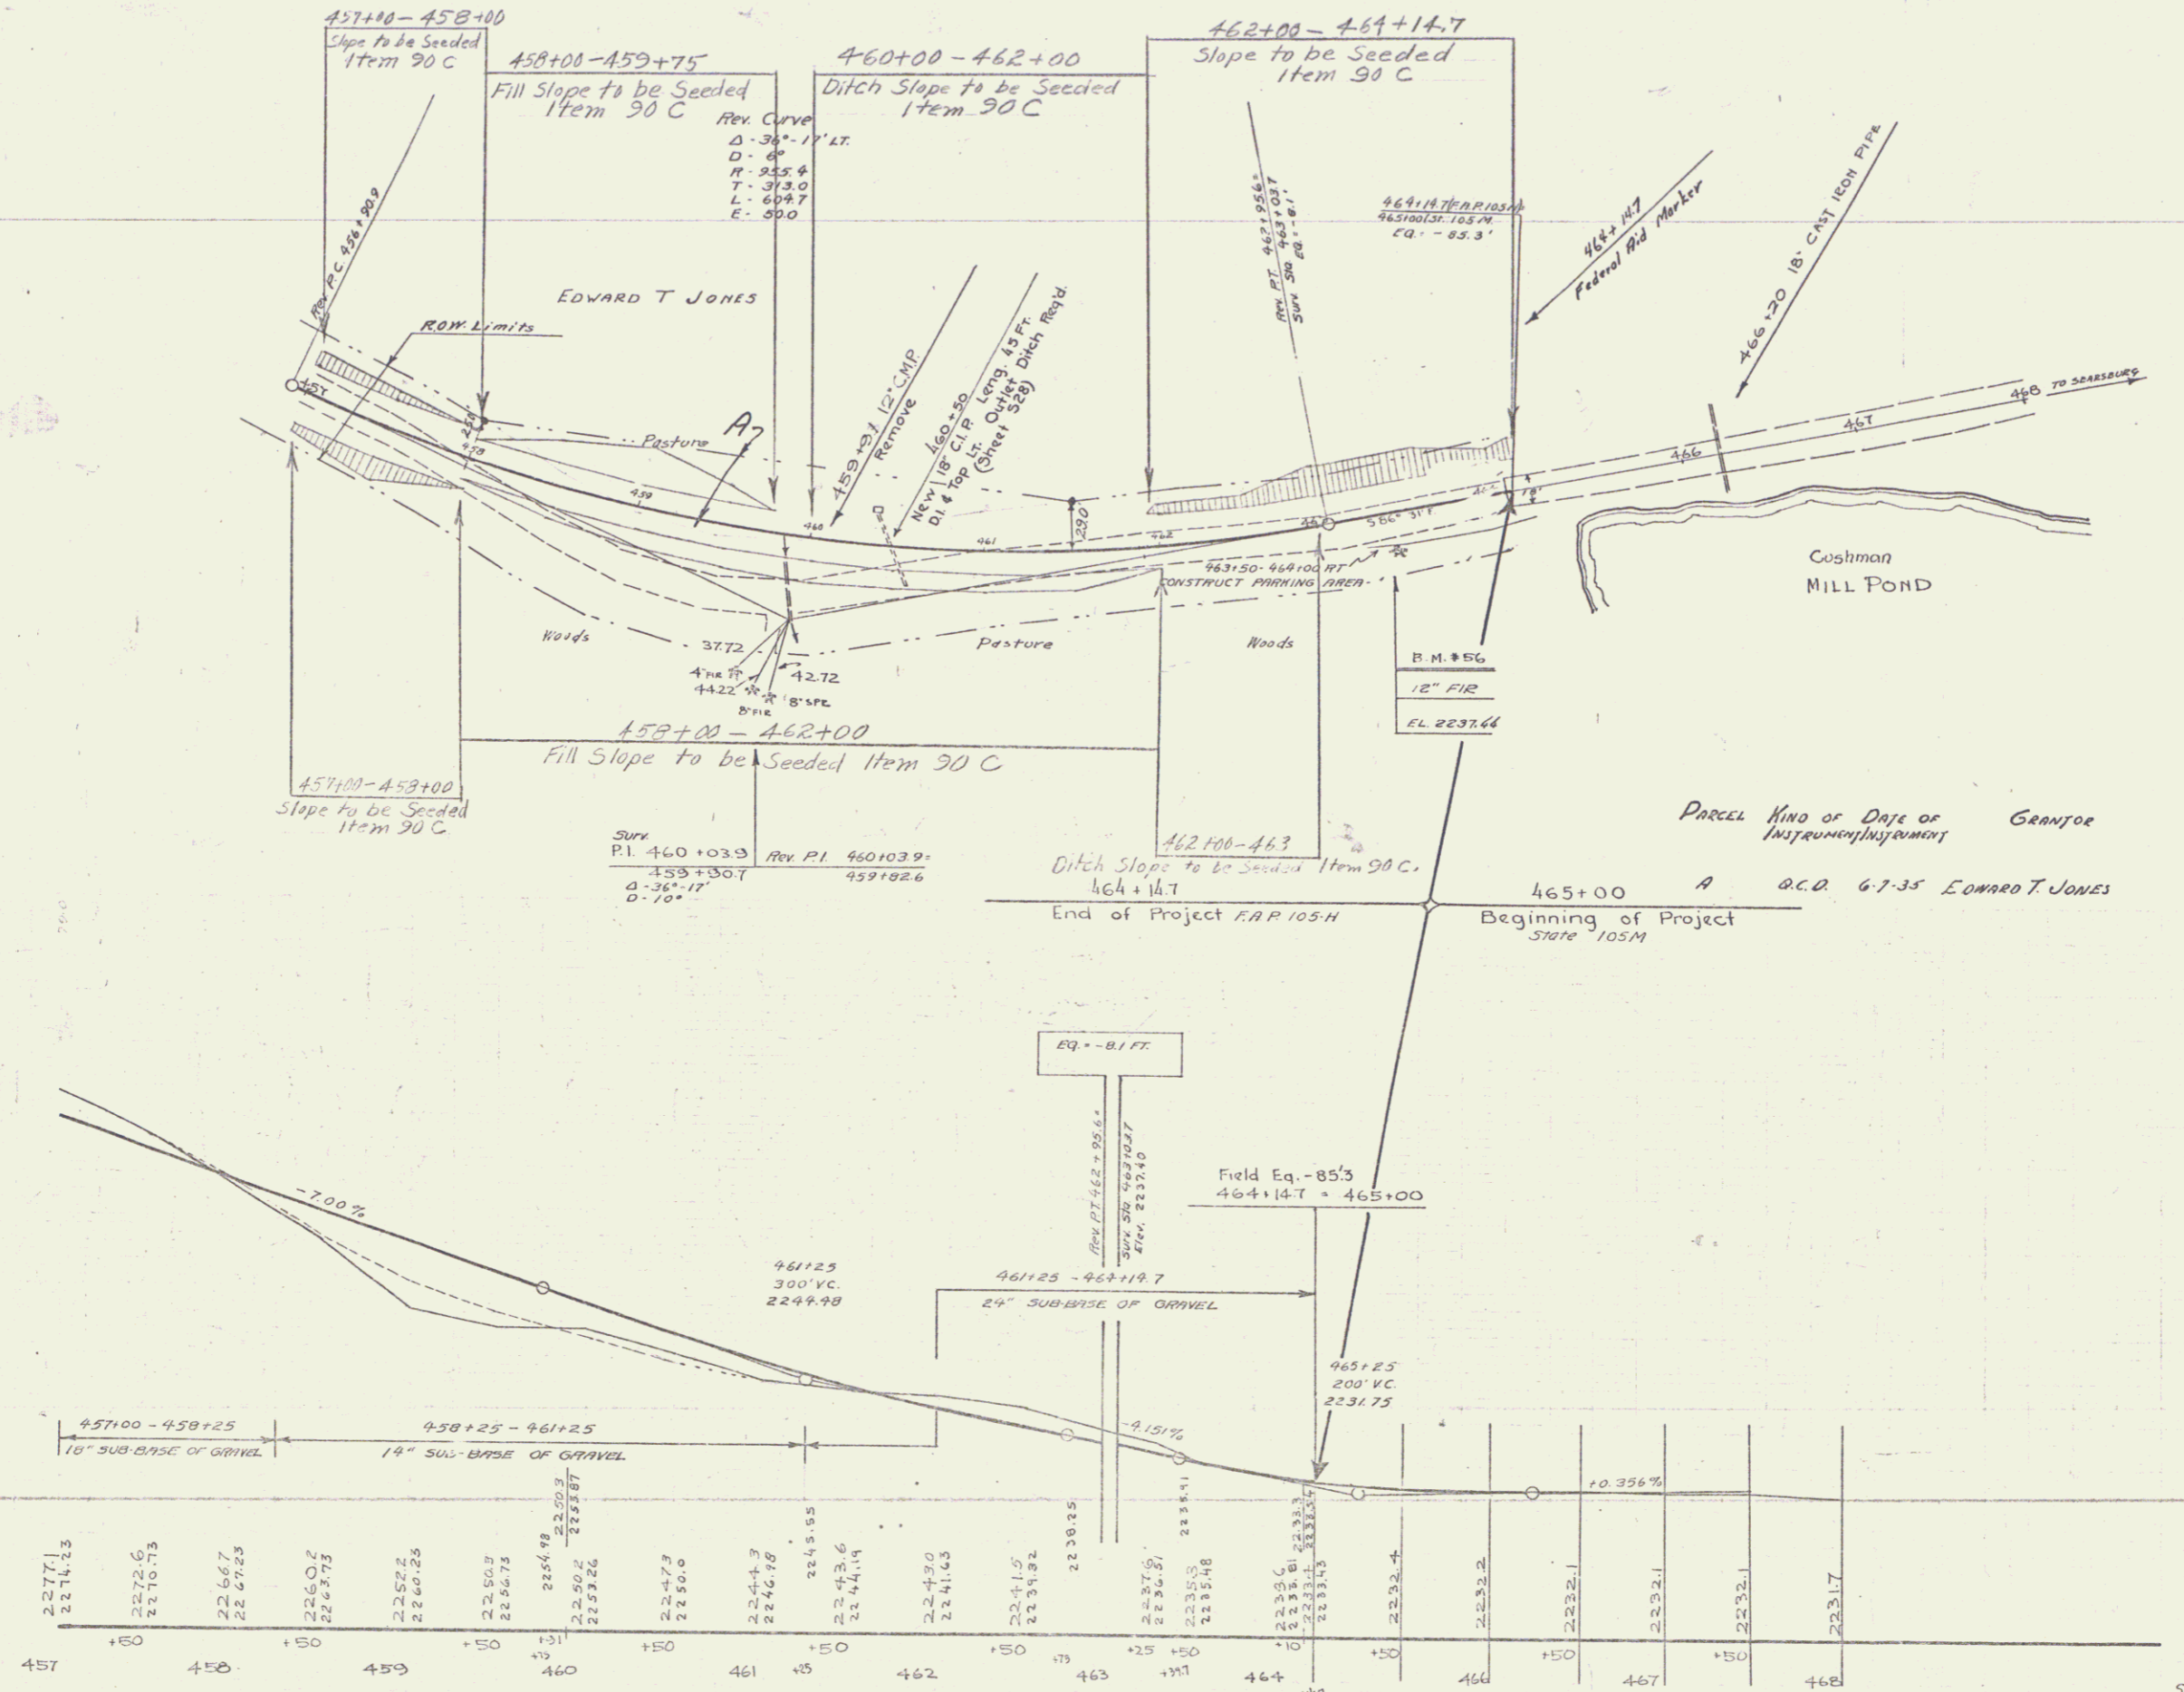

B.M. #56 SPIKE IN ROOT 12" FIR 10 FT RT. OF STA. 463+45 ELEV. 2237.44

PARCEL	KIND OF INSTRUMENT	DATE OF INSTRUMENT	GRANTEE	GRANTEE RECORDED	BOOK	PAGE	DATE
465+00	A	8.C.D. 6-7-35	EDWARD T. JONES	WOODFORD	18	359	6-13-35

SERIES Sheet 11 No. OF 45