

Col. Sig	Le. H	Right	Sta.	Left	Dist.	Way-Long
46477	21'	24'	46876-46880	104	40	176
47712	24'	24'	46876-47010	104	40	176
47800	24'	24'	47152	96	80	176

Size	Dist.	Le. H	Right	Sta.	Left	Dist.	Way-Long
12"	18'	39'	46627	18	39'	106	27
12"	18'	42'	47400	15	39'	106	27
12"	18'	42'	47722	18	42'	106	27

Size	Dist.	Le. H	Right	Sta.	Left	Dist.	Way-Long
12"	18'	39'	46627	18	39'	106	27
12"	18'	42'	47400	15	39'	106	27
12"	18'	42'	47722	18	42'	106	27

Size	Dist.	Le. H	Right	Sta.	Left	Dist.	Way-Long
12"	18'	39'	46627	18	39'	106	27
12"	18'	42'	47400	15	39'	106	27
12"	18'	42'	47722	18	42'	106	27

Size	Dist.	Le. H	Right	Sta.	Left	Dist.	Way-Long
12"	18'	39'	46627	18	39'	106	27
12"	18'	42'	47400	15	39'	106	27
12"	18'	42'	47722	18	42'	106	27



Size	Dist.	Le. H	Right	Sta.	Left	Dist.	Way-Long
12"	18'	39'	46627	18	39'	106	27
12"	18'	42'	47400	15	39'	106	27
12"	18'	42'	47722	18	42'	106	27

Size	Dist.	Le. H	Right	Sta.	Left	Dist.	Way-Long
12"	18'	39'	46627	18	39'	106	27
12"	18'	42'	47400	15	39'	106	27
12"	18'	42'	47722	18	42'	106	27

Size	Dist.	Le. H	Right	Sta.	Left	Dist.	Way-Long
12"	18'	39'	46627	18	39'	106	27
12"	18'	42'	47400	15	39'	106	27
12"	18'	42'	47722	18	42'	106	27

Size	Dist.	Le. H	Right	Sta.	Left	Dist.	Way-Long
12"	18'	39'	46627	18	39'	106	27
12"	18'	42'	47400	15	39'	106	27
12"	18'	42'	47722	18	42'	106	27

Parcel Kind of Date of Grantor
 A Q.C.D. 9-1-31 Stevens & Thompson Paper Co.
 Grantor: Stevens & Thompson Paper Co.
 Grantee: Woodford
 Recorded: 106-D 1931 4 47
 Book Page Date: 11 11 1-9-32

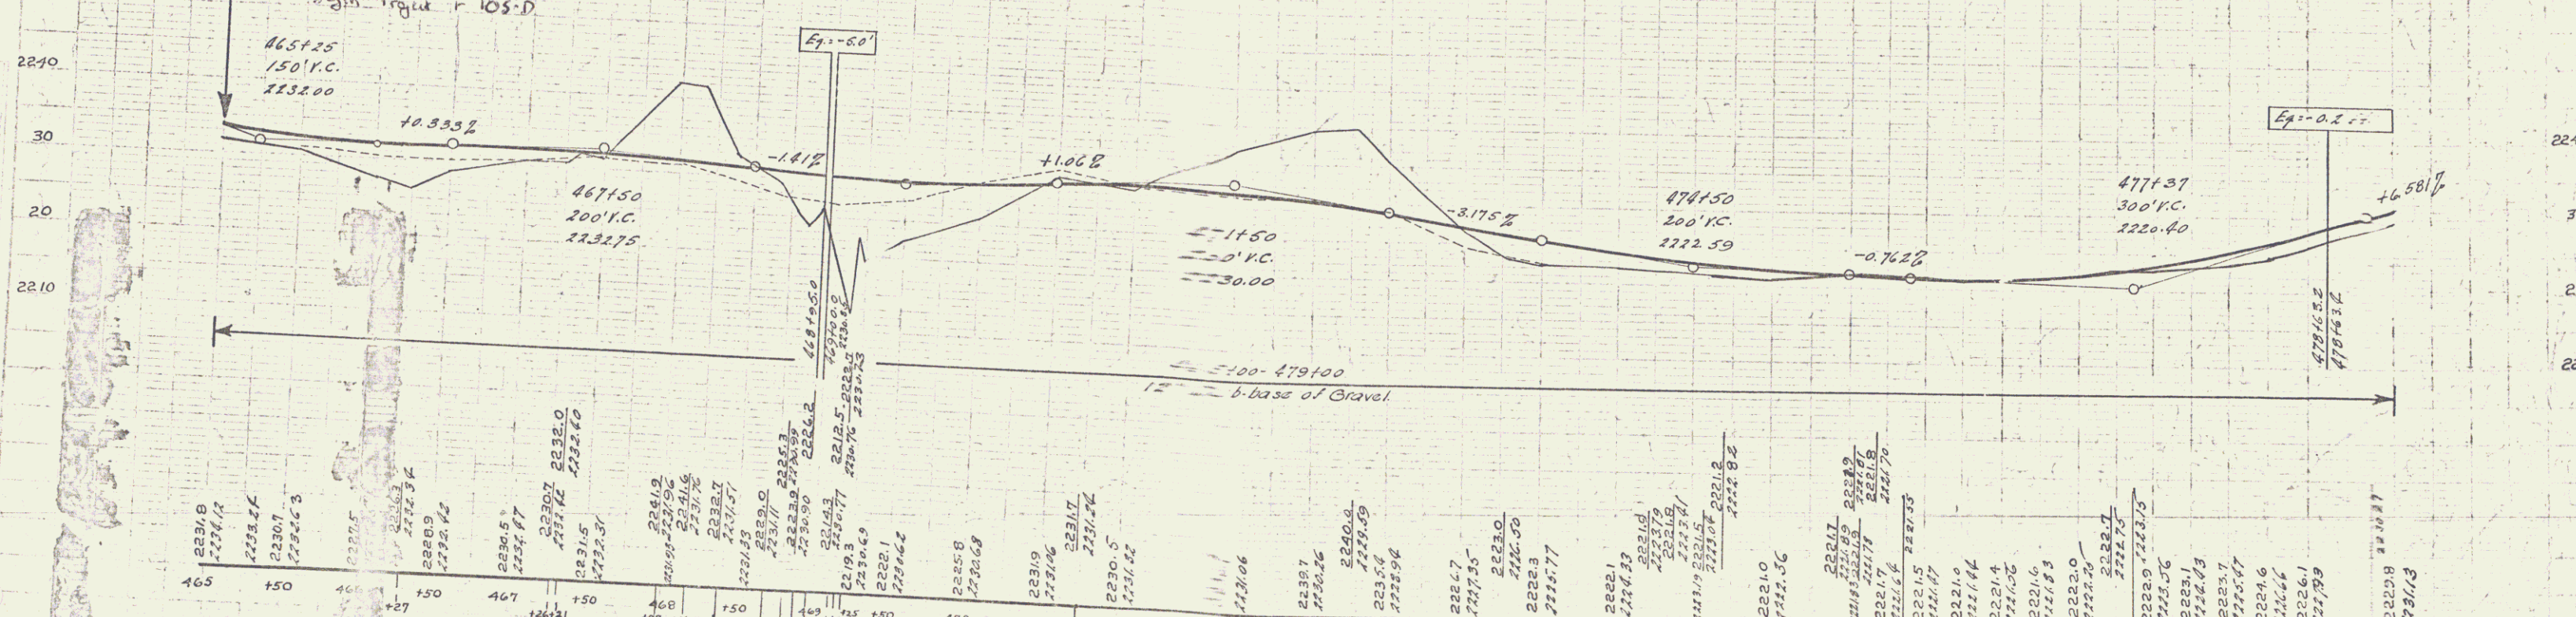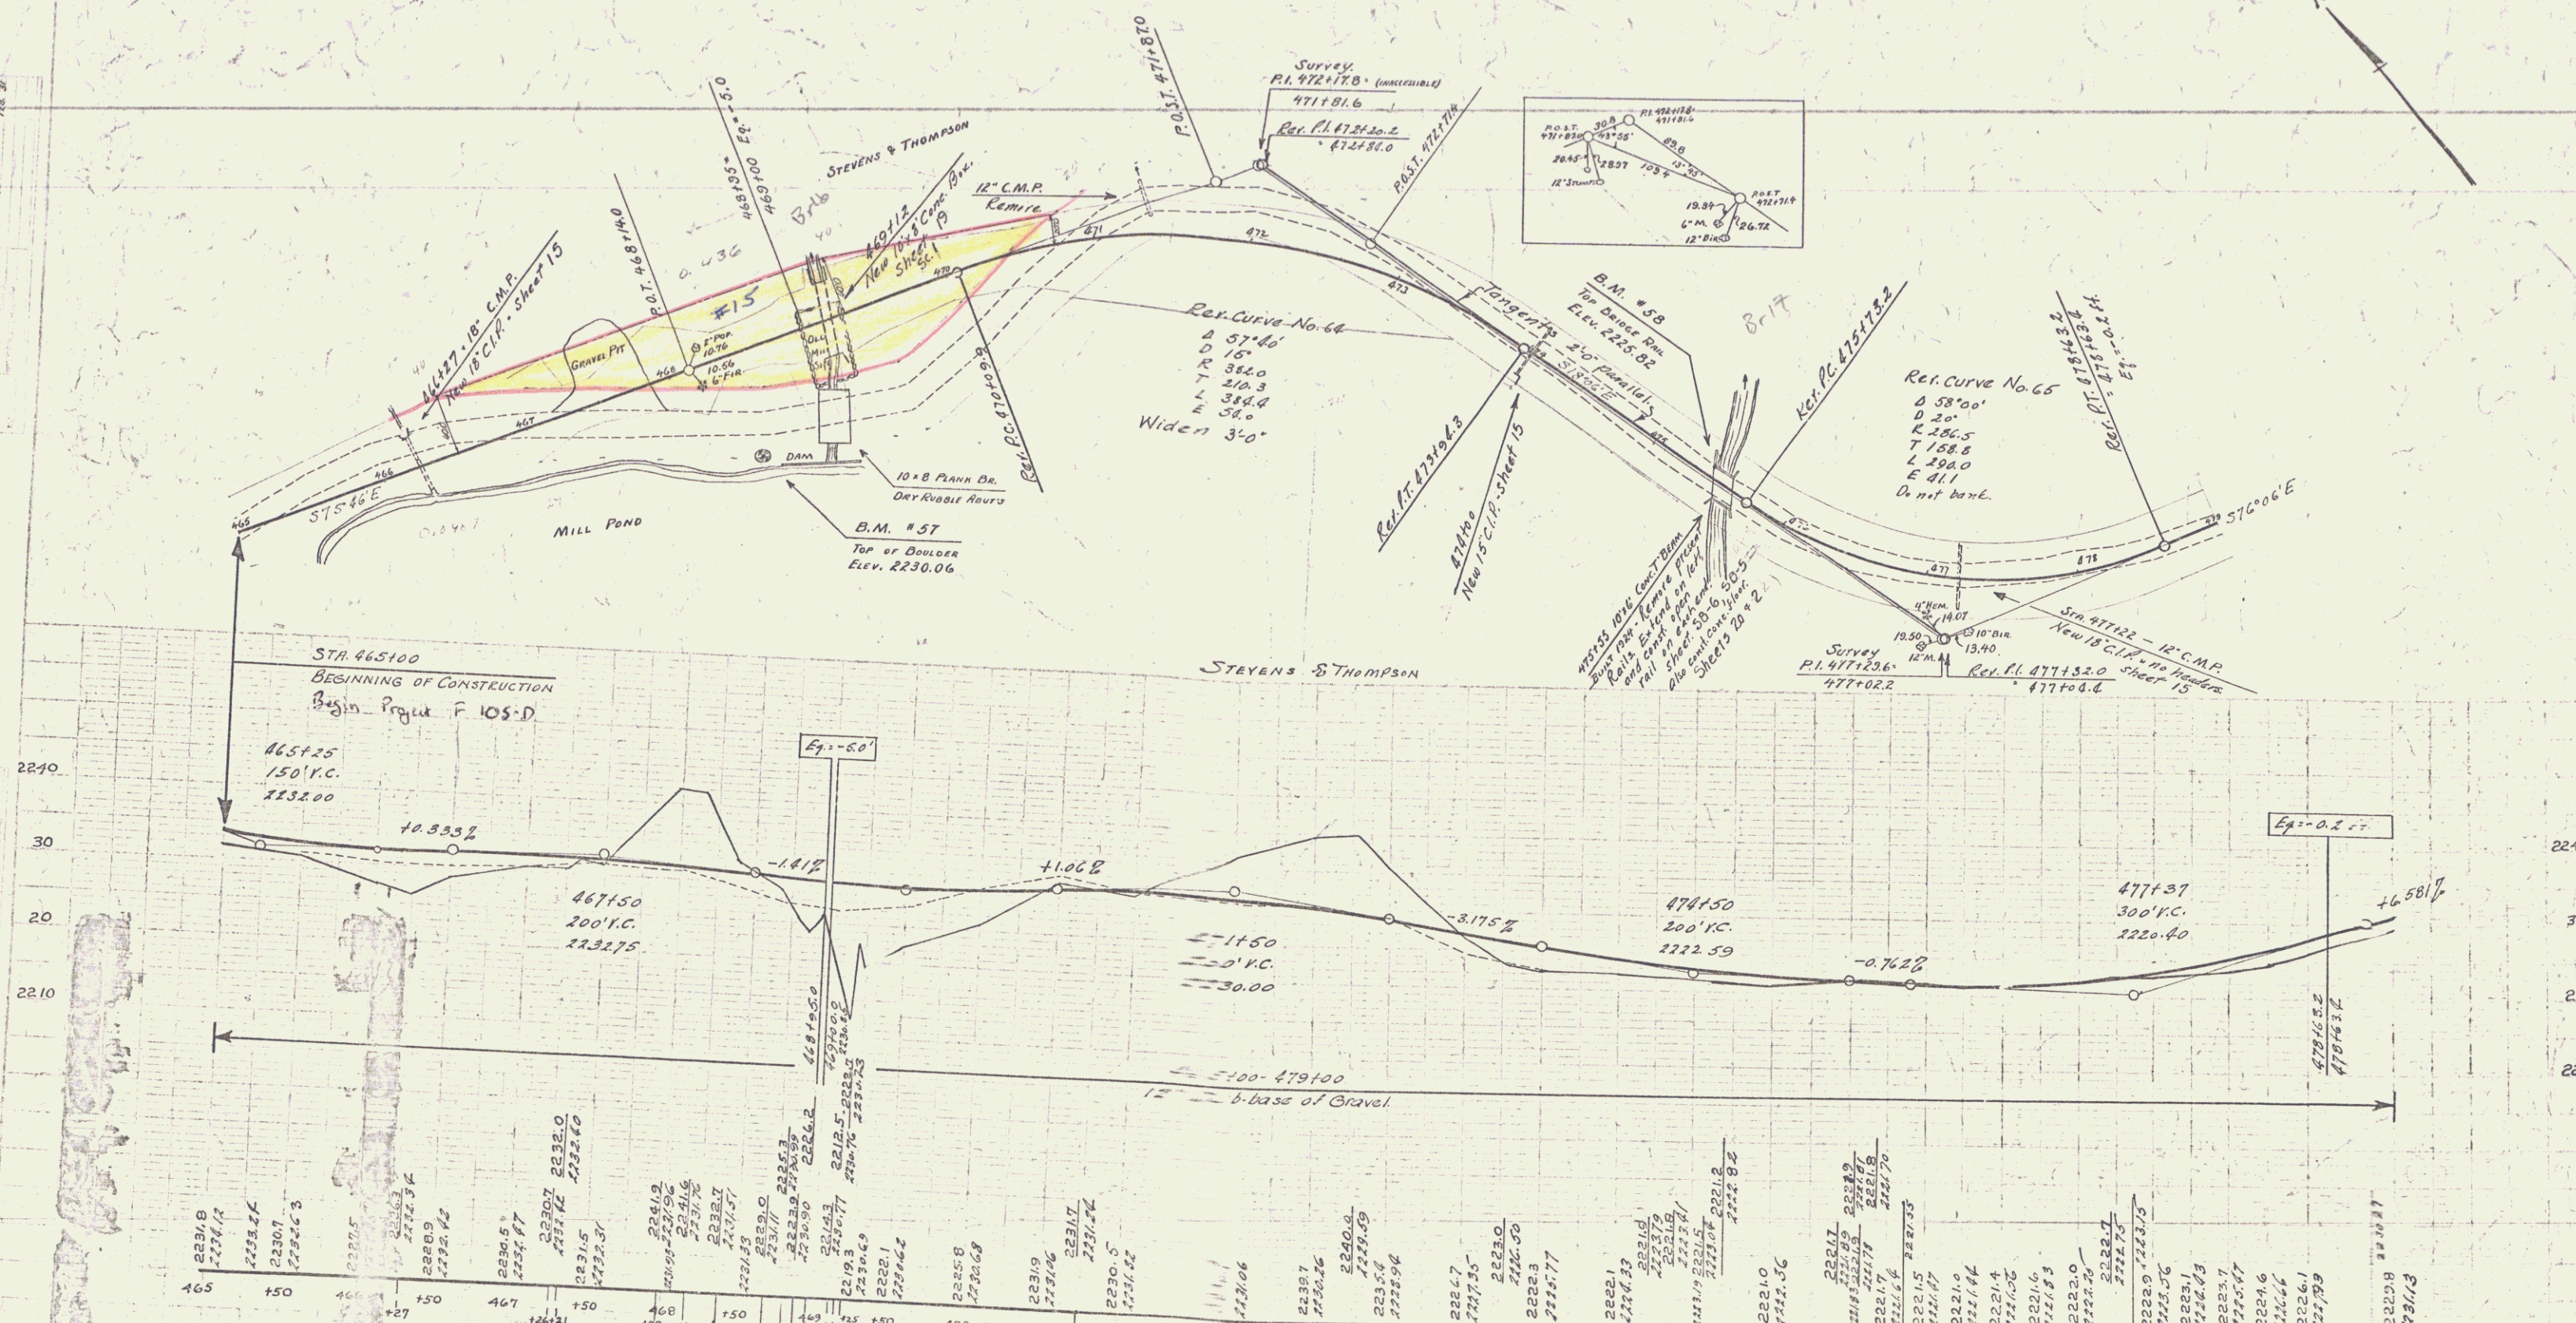

B.M. No. 57 Top of boulder, 72 ft. right of Sta. 468+51 Elev. 2230.06
 B.M. No. 58 Top of bridge rail, 9 ft left of Sta. 475+41 Elev. 2225.82