

ADD GURTS RAIL REQUIRED

Date Sta	Left	Right
584164	24	24
587110	24	24
589100	24	24
591105	24	24
594102	24	24



NEW CAST IRON PIPE CONVERTS REQUIRED

Sta	Diag	Long	Conc. A	Conc. Steel
584160	24	60	24cy	54
587110	18	36	18	34
589100	15	30	15	27
591105	18	36	18	34
594102	15	30	15	27

PARCEL KIND OF INSTRUMENT DATE OF GRANTOR GRANTEE RECORDED

Book	Page	Date
3	217	1-9-32
3	216	1-9-32
5	218	1-9-32

102-D 1931 12 47

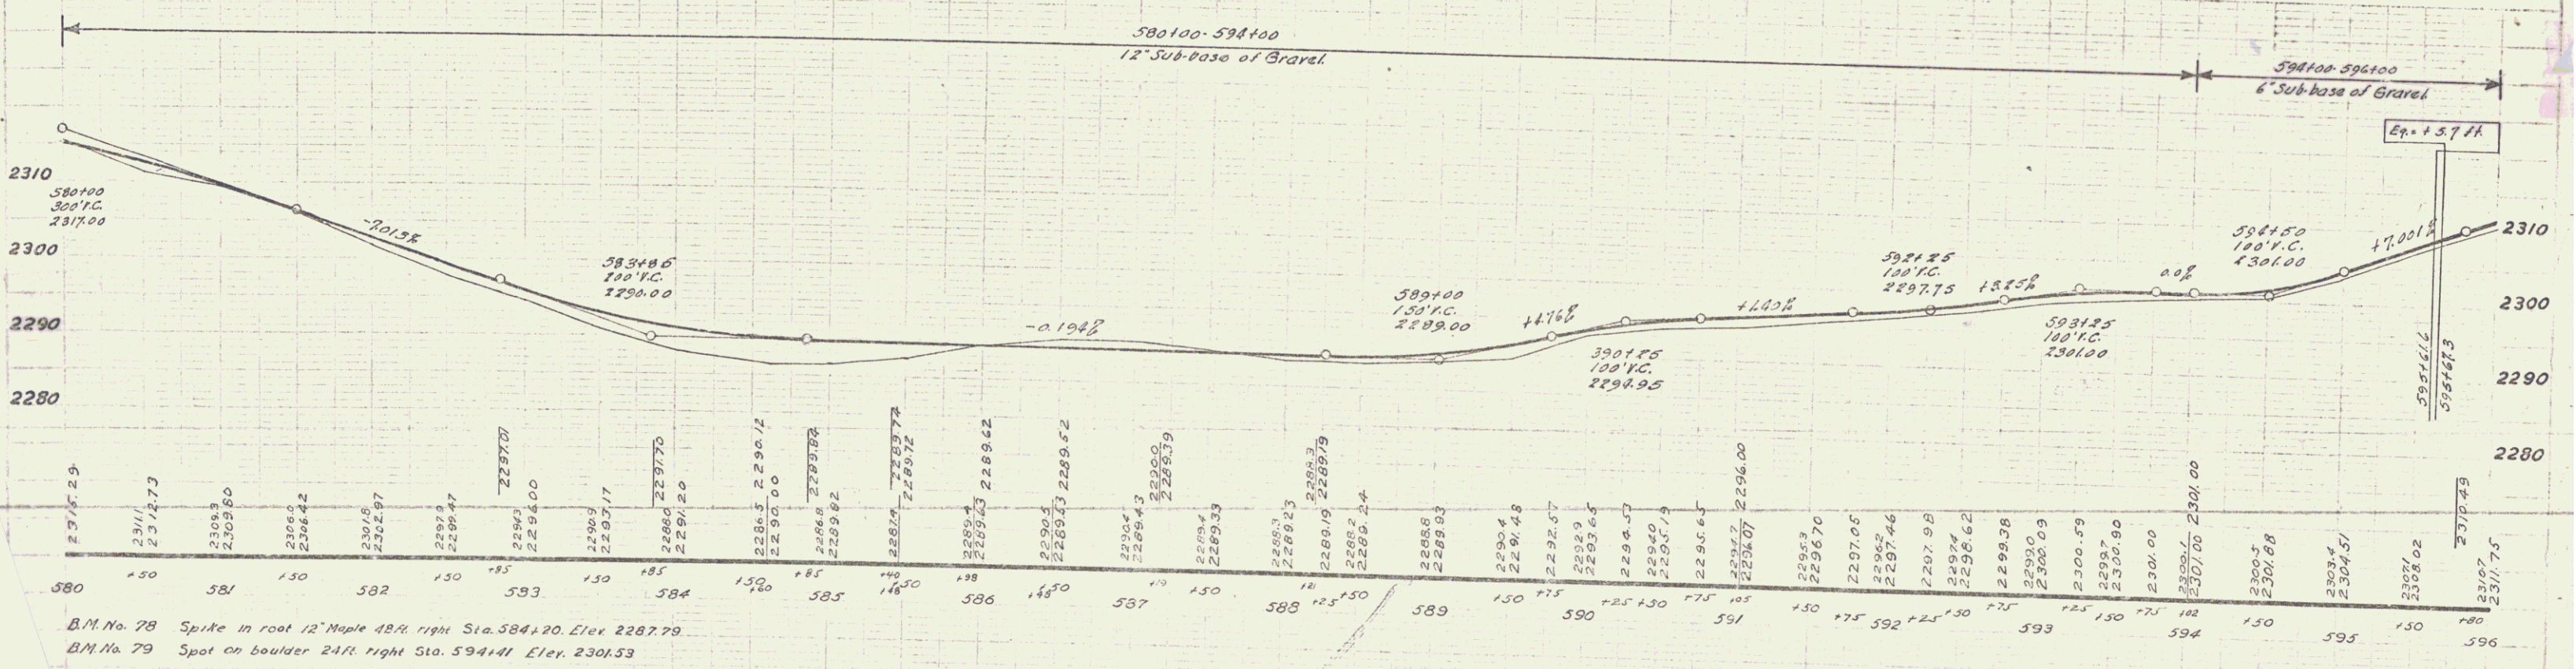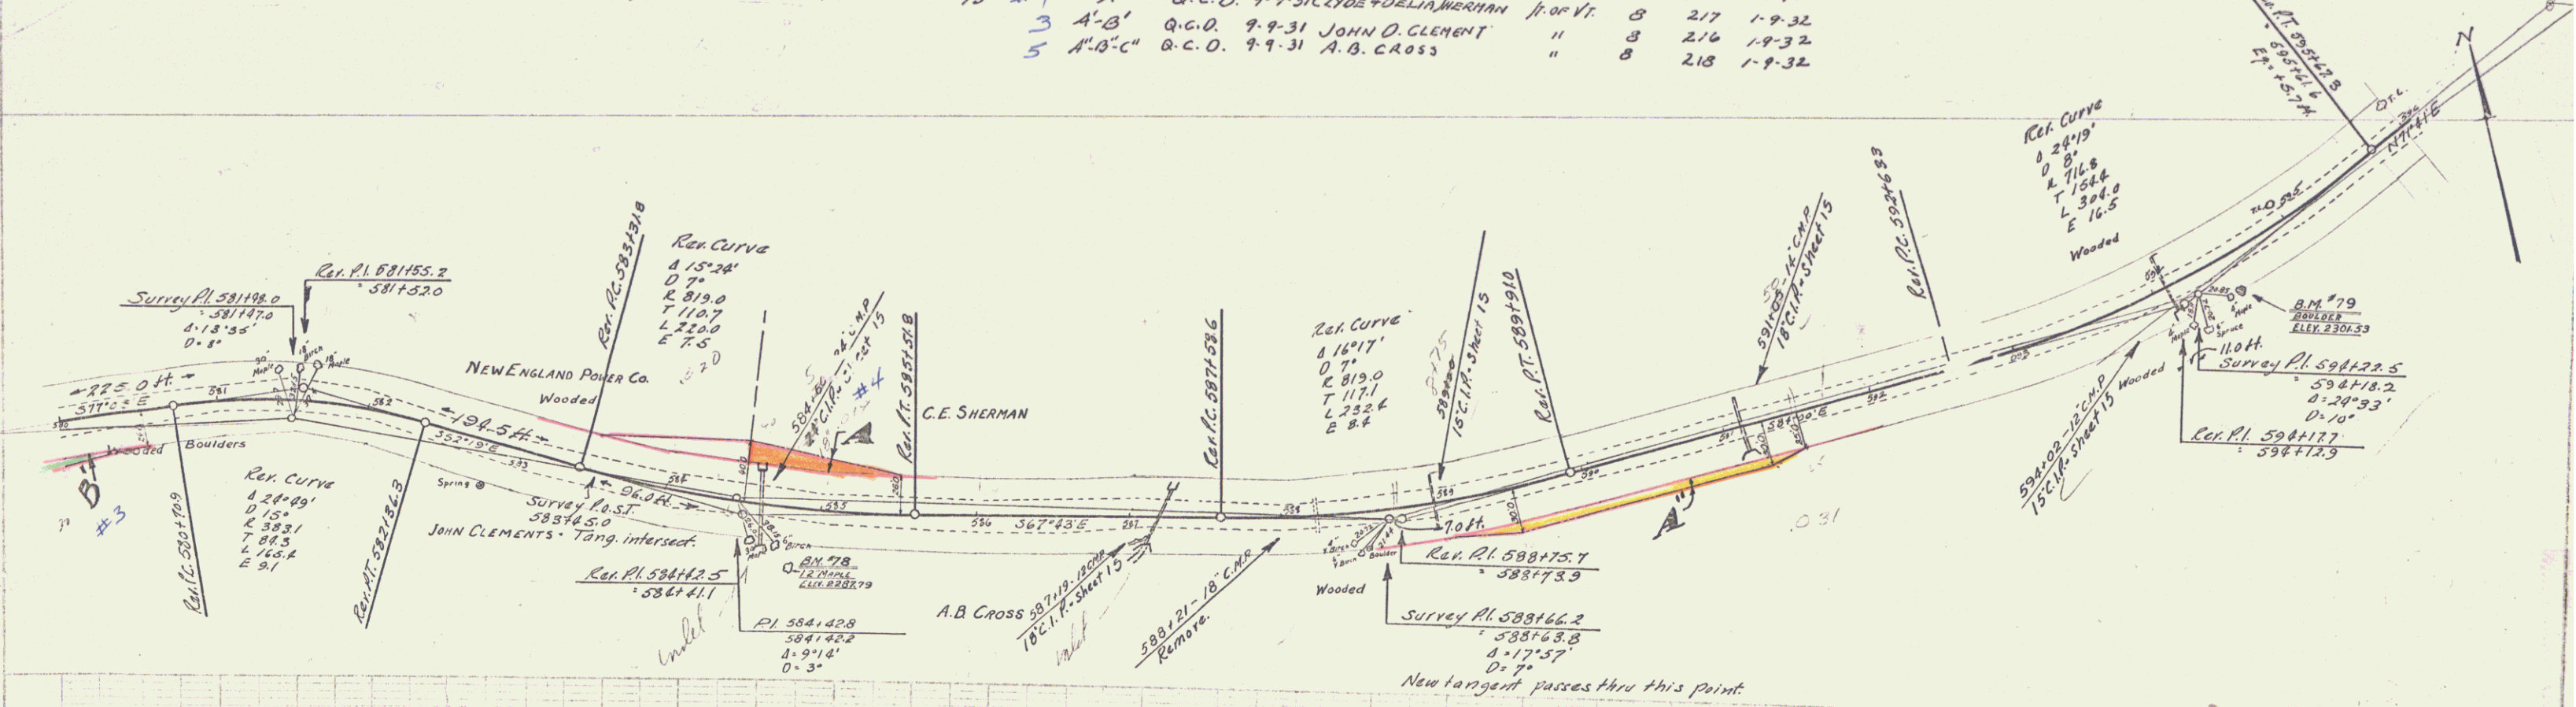

B.M. No. 78 Spike in root 12' Maple 48 ft right Sta. 584+20 Elev. 2287.79
 B.M. No. 79 Spot on boulder 24 ft right Sta. 594+11 Elev. 2301.53

SERIES F No. 105-D
 SHEET 12 OF 47

10