


INDEX OF SHEETS

SHEET NO.	TITLE PAGE
1	TYPICAL CROSS SECTION OF IMPROVEMENT (5" BITUMINOUS CONCRETE PAVEMENT)
3-4	QUANTITY SHEET (ITEMS) ITEM 361-B MOD
8	QUANTITY SHEET (DRAINAGE)
6-8	EARTHWORK SHEETS
9-17	PLAN AND PROFILE SHEETS
18	PLAN AND ELEVATION OF R.C.B. EXTENSION AT STA. 24+80
19	REINFORCING DETAILS R.C.B. EXTENSION AT STA. 24+80
20	REINFORCING SCHEDULE, R.C.B. EXTENSION AT STA. 24+80
21	SB-PP #1 DETAILS OF ROUND PLATE PIPE AT STA. 31+00
22	SB-PP #2 DETAILS OF ROUND PLATE PIPE AT STA. 31+00
23	DETAILS OF 8" PIPE AT STA. 43+80
24	SB-PP #1 DETAILS OF ROUND PLATE PIPE AT STA. 75+78
25	PLATE ARRANGEMENT FOR 108" C.O.M.P.P. STA. 75+78
26	SB-PP #1 DETAILS OF ROUND PLATE PIPE STA. 106+05
27	SB-PP #2 DETAILS OF ROUND PLATE PIPE STA. 106+05
28	PLATE ARRANGEMENT FOR 84" MULTI-PLATE PIPE STA. 106+05
29	A-81 TYPICAL FOR DRILLING AND BLASTING OF SOLID ROCK SUBGRADE
30	B-1 BANKING TABLES
31	B-5 TYPICAL SLOPE GRADING
32	B-6 MUCK EXCAVATION
33	C-1 CURB DETAILS
34	D-2 DETAILS OF HEADWALLS AND UNDERDRAIN
35	D-3 GUTE MATING
36	D-4 DETAILS OF FLUSHING BASINS
37	D-8 DETAILS OF RENF. CONC. DROP INLETS
38	D-11 DETAILS OF GRATES AND COVERS FOR DROP INLETS
39	D-16 REINF. CONC. PIPE END SECTIONS
40	E-1 BARRICADES, SIGNS AND LIGHTS (ROADWAY)
41	E-9 FEDERAL "AD" CONSTRUCTION IDENTIFICATION SIGNS
42	G-3 THREE CABLE GUARD RAIL WITH STEEL POSTS
43	G-4 STEEL GUIDE AND MARKER POSTS
44	J-1 PROJECT AND BOUNDARY MARKERS
45-81	CROSS SECTIONS
20-A	20-21 STANDARD CULVERT DETAILS
ADDITIONAL SHEETS	
6	ITEM, DETAIL & DRAINAGE
3	FINAL EARTHWORKS
1	X SECTION SHEET 57-A
1	LINE REVISION
4	GRAVEL BACKFILL EST.
6	BORROW, GRANULAR & GRAVEL PITS
17	DRAINAGE SECTION SHEETS

**STATE OF VERMONT
DEPARTMENT OF HIGHWAYS
PROPOSED IMPROVEMENT**

**TOWNS OF WOODFORD-SEARSBURG
COUNTY OF BENNINGTON
VERMONT ROUTE 9
BENNINGTON-BRATTLEBORO ROAD**

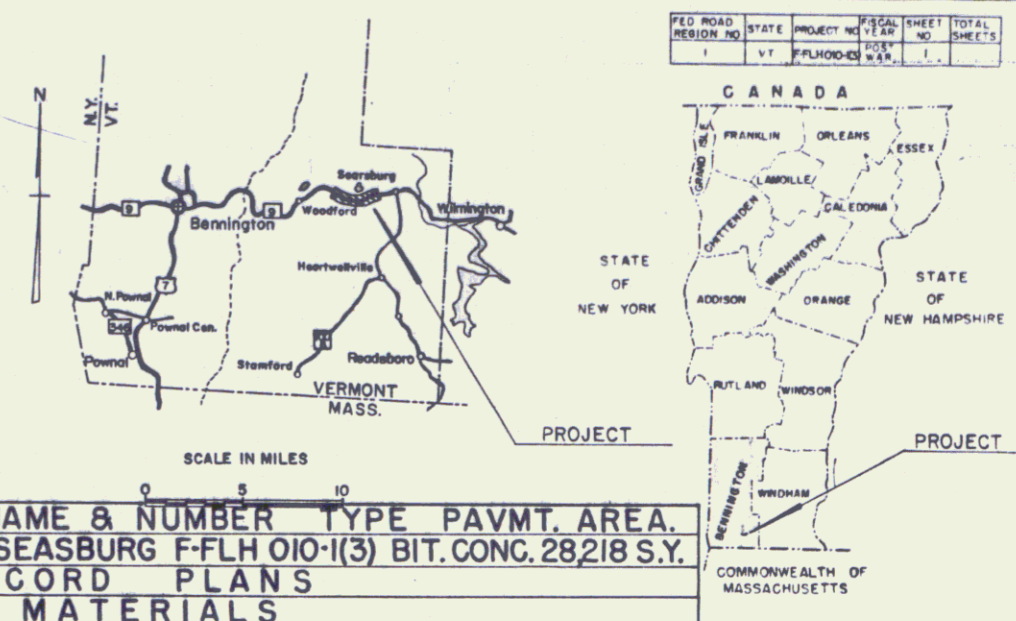

**PROJECT NAME & NUMBER TYPE PAVMT. AREA.
WOODFORD-SEARSBURG F-FLH 010-1(3) BIT. CONC. 28,218 S.Y.
RECORD PLANS**

BEGINNING AT A POINT APPROX. 519 FEET WESTERLY
OF THE WOODFORD-SEARSBURG TOWN LINE AND
EXTENDING EASTERLY 10,581.7 FEET.
LENGTH OF PROJECT 10,581.7 FEET * 2.004 MILES.

ADT 1960	950
ADT 1980	1650
DIV (1980)	280
D	70 %
T	7 %
	50 MPH

SUBBASE OF GRAVEL - HARBOUR PIT & RICE PIT - BENNINGTON, VT.
SUBBASE OF SAND - HARBOUR PIT - BENNINGTON, VT.
PENETRATION MACADAM CRUSHED GRAVEL BASE COURSE, BITUMINOUS CONCRETE & CONCRETE
CLASS "B" - WILLIAM E. DAILEY (PLANT) - SO. SHAFTSBURY, VT.
CUTBACK ASPHALT - MOBIL OIL CO. - ALBANY, N.Y.
REFINED TAR & ASPHALT CEMENT - KOPPERS CO., INC. - UTICA, N.Y.
REINFORCING STEEL - REPUBLIC STEEL CO. - BOSTON, MASS.
REINFORCED CONCRETE PIPE - HUME PIPE CO. OF NEW ENGLAND, INC. - WINDSOR, VT.
ASPHALT COATED CORR. GALV. METAL PIPE - NORTHEASTERN CULVERT CORP. - WESTMINSTER, VT.
CAST IRON GRATES - E. L. LEBARON FOUNDRY CO. - BROCKTON, MASS.
GUARD RAIL, STEEL GUIDE & MARKER POSTS, TREATED TIMBER CURB & JUTE MATTING - S. T. GRISWOLD & CO., INC. - WILLISTON, VT.

CONTRACTOR - W. H. MORSE CONSTRUCTION CO., INC.
BENNINGTON, VT.
RESIDENT ENGINEER - DANIEL G. CADIZ.
INSPECTORS - MAYNARD B. ASHLEY & DAVID E. JAMIESON.
RECORD PLANS - A. G. SPIDLE.
CONTRACT - DATED - FEBRUARY 11, 1964.
STARTED - FEBRUARY 28, 1964.
COMPLETED - JULY 15, 1965.
ACCEPTED - JULY 22, 1965.



CONVENTIONAL SIGNS

R.O.W.	COUNTY LINE
TOWN LINE	FENCE LINE
STONE WALL	UNFENCED PROPERTY
GUARD RAIL	TRAVELED WAY
RAILROAD	RETAINING WALL
CENTER LINE	SURVEY LINE
CULVERT	DROP INLET
TROLLEY POLE	POWER POLE
TELEPHONE POLE	TREES
JADES	LIMITED ACCESS

WOODFORD - SEARSBURG F-FLH 010-1(3)
CONTRACTOR - W. H. MORSE CONSTRUCTION CO., INC.
BENNINGTON, VT.
RECORD PLANS - A. G. SPIDLE
CONSTRUCTION COMPLETED - JULY 15, 1965.

APPROVED DATE 4/1/63	APPROVED DATE 4/15/63	APPROVED DATE 4/16/63	APPROVED DATE 4/23/63	APPROVED DATE 4/3/63	APPROVED DATE 4/3/63
-------------------------	--------------------------	--------------------------	--------------------------	-------------------------	-------------------------

Pin # 99R827

DATE: FOR REVISIONS...
FIELD CHECKED...
EITHER THE FIELD...
FILE.

THESE PLANS ARE SUBJECT TO SUCH REVISIONS AS MAY BE
REQUIRED BY THE BUREAU OF PUBLIC ROADS OR THE COMMISSIONER
OF HIGHWAYS.

CONSTRUCTION IS TO BE CARRIED ON IN ACCORDANCE WITH
THE PLANS AND THE STANDARD SPECIFICATIONS FOR HIGHWAY AND BRIDGE
CONSTRUCTION OF JANUARY 1956 SUBMITTED TO THE BUREAU OF
PUBLIC ROADS AS APPROVED JULY 5 1956 INCLUDING ALL SUBSEQUENT
APPROVED REVISIONS AND SUCH REVISED SPECIFICATIONS AND SPECIAL
PROVISIONS AS ARE SUBMITTED WITH THE PLANS.

DEPARTMENT OF COMMERCE
BUREAU OF PUBLIC ROADS

APPROVED

DIVISION ENGINEER DATE

PROJECT F NO. FLH 010-1(3)

SHEET 1 OF 81 SHEETS