


PLAN  
 9/62  
 H. Moran  
 5.642  
 1962

9/62  
 H. Moran  
 5.642  
 1962

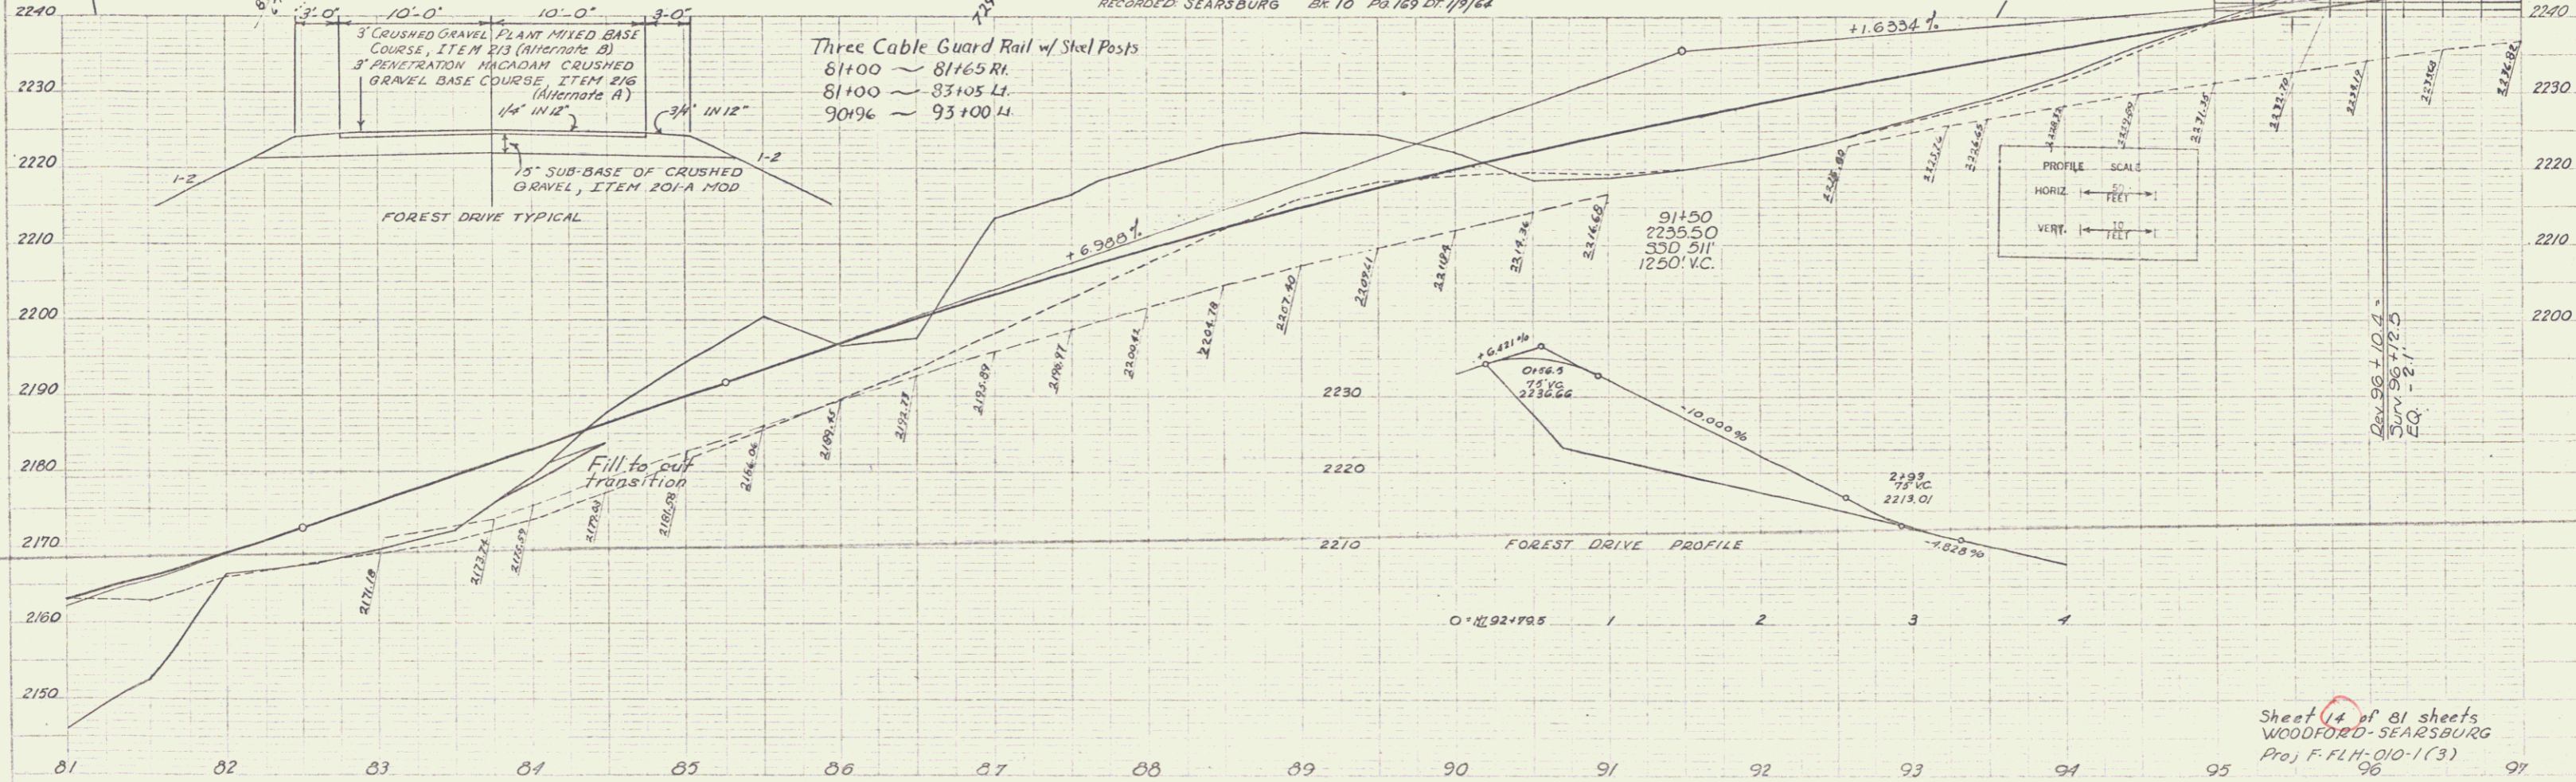

Sheet 14 of 81 sheets  
 WOODFORD-SEARSBURG  
 Proj. F.P.L.H. 010-1(3)  
 96

6