

INDEX OF SHEETS

SHEET NO. 1	TITLE PAGE
2	TYPICAL CROSS-SECTION OF IMPROVEMENT BITUMINOUS MACADAM SURFACE COURSE
3	BANKING AND WIDENING TABLES
4	PLAN AND PROFILE
5	ABUTMENT DETAILS
6	STANDARD STRUCTURE SHEET SIB 24 45 SKEW (MODIFIED FOR 30 SKEW)
7	SB 5C RAIL AND CURB
8	SB 11 BARRICADES, LIGHTS AND SIGNS.
9	SB 20 DETAILS C,E,K,L AND GEN. NOTES.
10	S 30 CABLE GUARD RAIL
11-14	ROADWAY CROSS SECTIONS
15	CHANNEL CROSS SECTIONS

FED. ROAD DIST. NO.	STATE	PROGRAM	FISCAL YEAR	SHEET NO.	TOTAL SHEETS
9	VT.	CR. D-C	1938	1	15

STATE OF VERMONT  
STATE HIGHWAY DEPARTMENT


PLAN AND PROFILE OF PROPOSED  
STATE HIGHWAY

EMERGENCY RELIEF PROJECT

TOWN OF WILMINGTON P.# 99R835

BRATTLEBORO-WILMINGTON ROAD  
BEGINNING AT A POINT 6020 FEET SOUTH EAST-  
ERLY FROM THE INTERSECTION OF STATE ROUTE  
NO.8 WITH STATE ROUTE NO.9. THENCE EXTEN-  
DING WESTERLY A DISTANCE OF 538.7FEET.

LENGTH OF BRIDGE 74.0FT.= 0.014 MI.  
LENGTH OF APPROACHES 464.7FT.= 0.088MI.  
TOTAL LENGTH OF PROJECT 538.7FT.= 0.102MI.

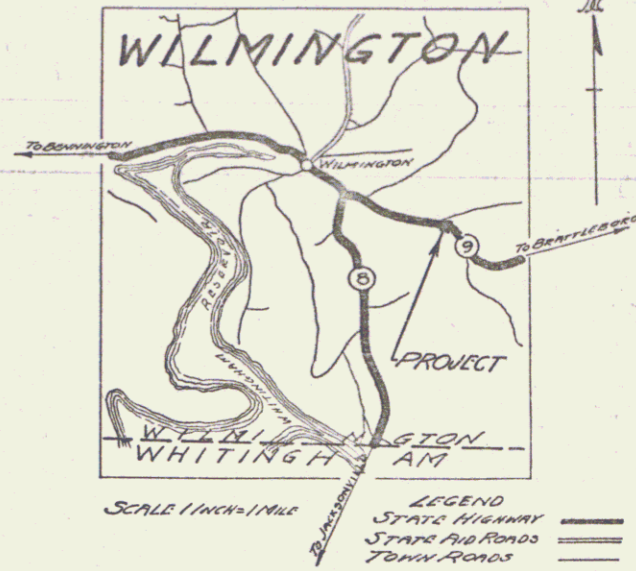

STANDARD STRUCTURE SHEETS APPROVED  
By The Chief Engineer.  
S-30 August 15, 1934.

These Plans are Subject To Such Revisions As May Be  
Required By The Bureau Of Public Roads Or The  
Commissioner Of Highways.

CONSTRUCTION IS TO BE CARRIED ON IN ACCORDANCE WITH  
THE PLANS AND STANDARD ROAD AND BRIDGE SPECI-  
FICATIONS OF 1936 AS APPROVED DECEMBER 23, 1936  
BY THE BUREAU OF PUBLIC ROADS INCLUDING ALL  
SUBSEQUENT APPROVED REVISIONS AND SUCH  
AS PER SPECIFICATIONS AND SPECIAL PROVISIONS  
AS ARE SUBMITTED WITH THESE PLANS.

RIGHT-OF-WAY DIVISION  
TOWN FILE  
PERPETUAL  
Form of VT 9  
(To Be Returned To R.O.W. Division)

APPROVED: Nov. 21, 1938  
W. August  
COMMISSIONER OF HIGHWAYS

SUBMITTED BY ORDER OF THE STATE HIGHWAY BOARD

Route VT 9  
Date 11/16/1938

RECOMMENDED \_\_\_\_\_  
DISTRICT ENGINEER BUREAU OF PUBLIC ROADS  
RECOMMENDED FOR APPROVAL \_\_\_\_\_  
CHIEF ENGINEER BUREAU OF PUBLIC ROADS  
APPROVED \_\_\_\_\_  
DIRECTOR - BUREAU OF PUBLIC ROADS

SERIES ER No. 9-C FILED  
SHEET 1 OF 15

PROJECT NUMBER	ER-9-C
LENGTH	0.102 MI.
TYPE	1 Lane Concrete Floor
CONTRACTOR	Ross Construction Co.
YEAR	1938

CONVENTIONAL SIGNS

GROUND ELEVATION DATUM LINE

GRADE ELEVATION DATUM LINE

CURVE DATA

DEFLECTION ANGLE Δ

DEGREE OF CURVE D

RADIUS OF CURVE R

TANGENT DISTANCE T

LENGTH OF CURVE L


EXTERNAL DISTANCE E

POINT OF INTERSECTION P. I.

POINT OF CURVE P. C.

POINT OF TANGENT P. T.

POINT ON TANGENT P. O. T.

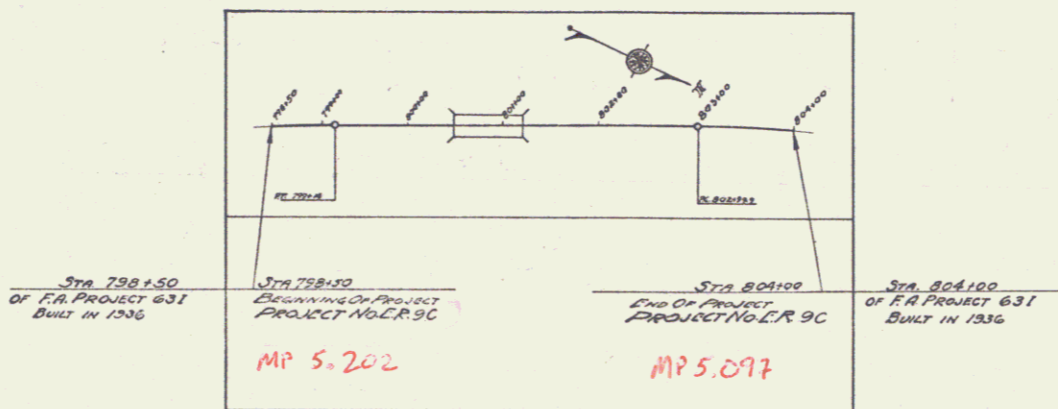

SCALES

TITLE SHEET	1"=100'
TYPICAL SHEETS	1"=2'
LAYOUTS PLAN	1"=20'
PROFILE HOR.	1"=20'
VERT.	1"=10'
CROSS SECTIONS	1"=5'

APPROVED: P. M. [Signature]  
DISTRICT HIGHWAY COMMISSIONER

CORRECT: A. D. [Signature]  
BRIDGE ENGINEER

DIST. # 1 PLANS