


NOTE
 The attention of the contractor is called to the Springs located on the R. of the 709+00. He shall take proper precautions during construction to avoid damage to the Springs, as it is necessary that the flow from the Springs be maintained during and after construction. Contractor is held liable for all damage done to the Springs from the beginning of construction to the satisfactory completion of the project. A 3" diameter for use in connection with the meter pipe at Sta. 709+00 to be constructed. There is to be for an a coal plus base.

PARCEL	KIND OF INSTRUMENT	DATE OF INSTRUMENT	GRANTOR	GRANTEE	RECORDED	REMARKS
A	M.D.	1-13-35	LEON M. HALL & MARY E. HALL	STOF V. 30	77-78	1-21-35
B	Q.C.D.	6-17-36	LEON M. HALL & MARY E. HALL	STOF V. 31	201-202	9-17-40

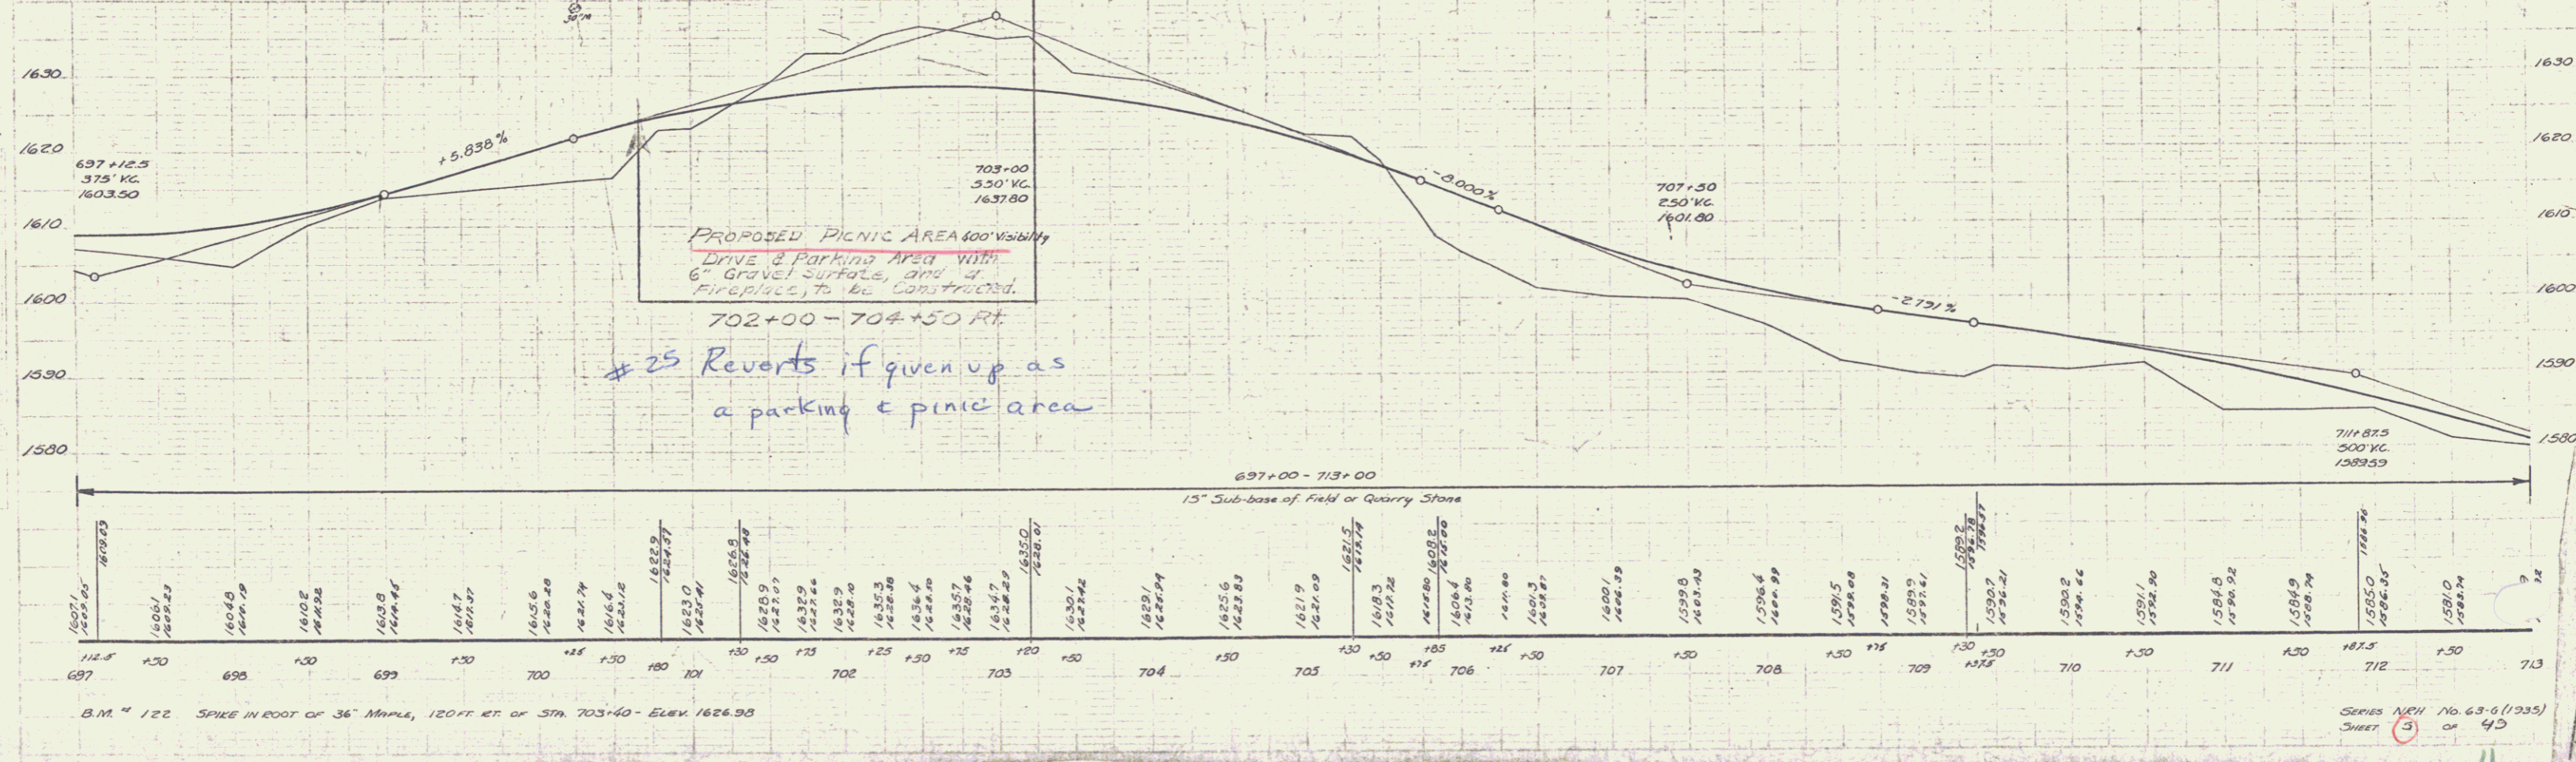

#25 Reverts if given up as a parking & picnic area

B.M. # 122 SPIKE IN ROOT OF 36" MAPLE, 120 FT. RT. OF STA. 703+40 - ELEV. 1626.98