


ESTIMATED QUANTITIES FOR 10.8 CONC. CURV.

ITEM 14 CHANNEL EXCAV.	75	CY.
" 15 STRUCT. EXCAV.	149	"
" 33A CONC. CLASS "A"	92	"
" 34 REINF. STEEL	6932	LB.

PARCEL	KIND OF DATE OF INSTRUMENT	GRANTOR	GRANTEE	RECORDED BOOK PAGE DATE	REMARKS
A B	N.D.	3-5-35	H.W. MEYER	STA. VI. 30 11/12 4-5-35	

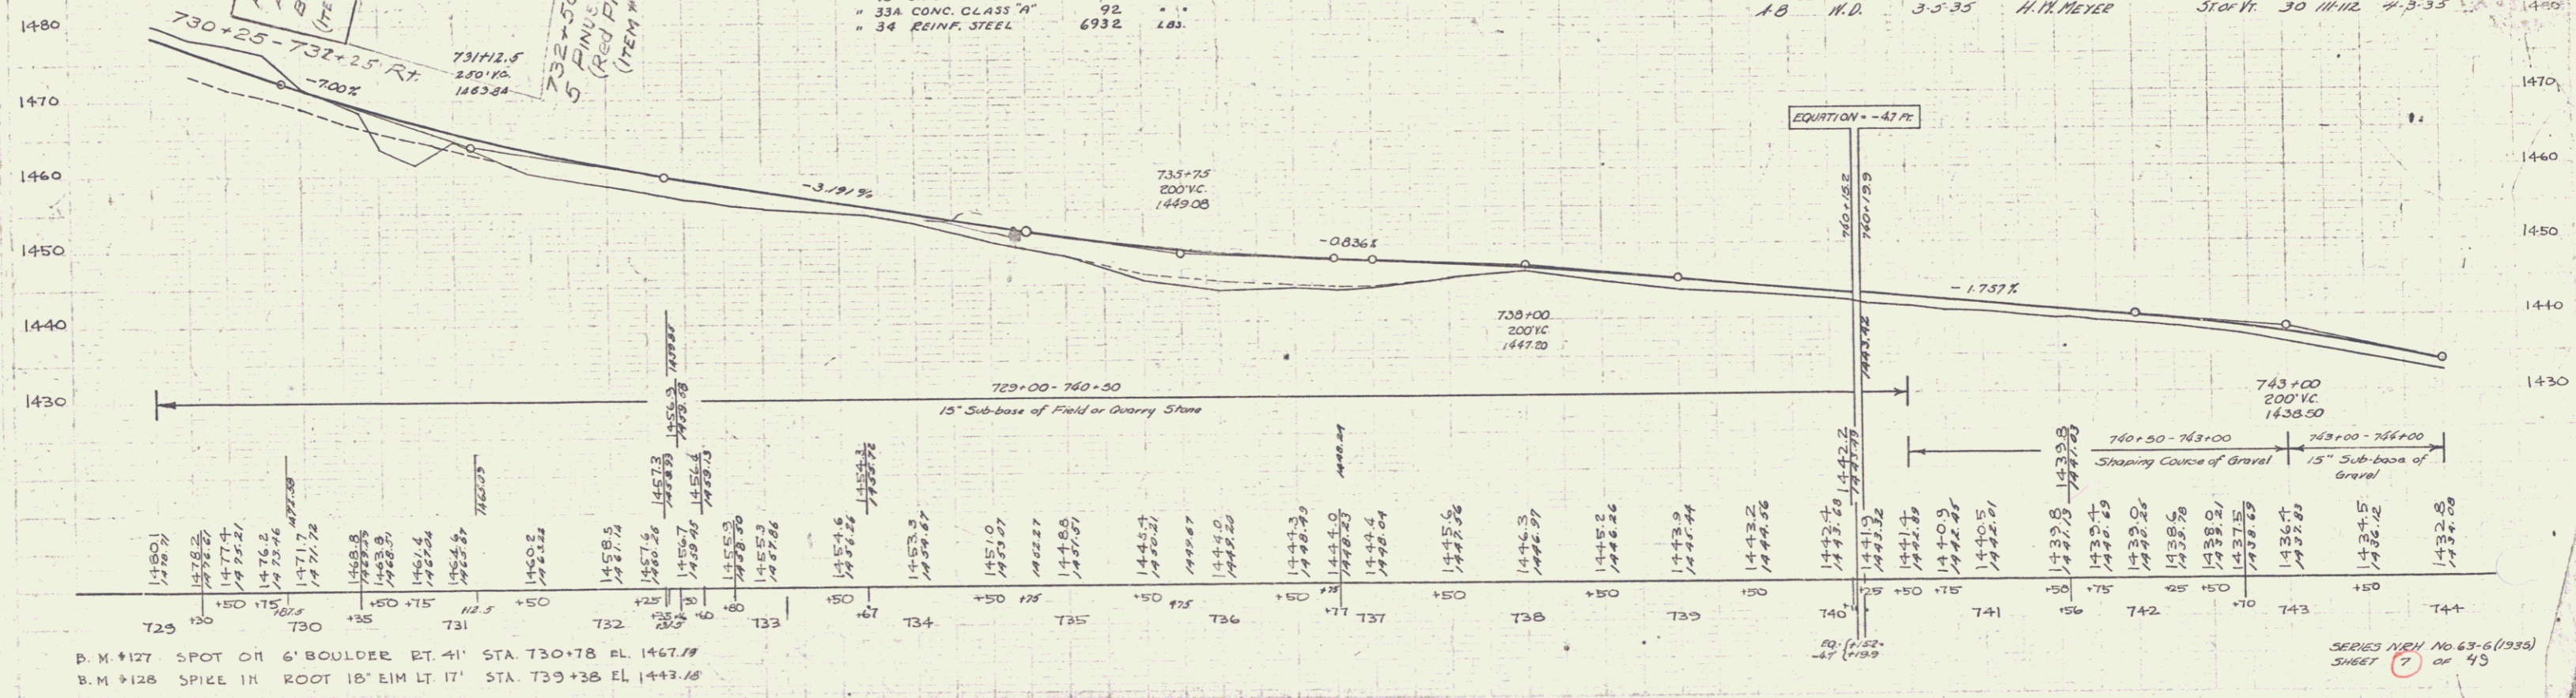

P.M. #127 SPOT OR 6' BOULDER RT. 41' STA. 730+78 EL. 1467.19  
 B.M. #128 SPIKE IN ROOT 18' EIM LT. 17' STA. 739+38 EL. 1443.15