
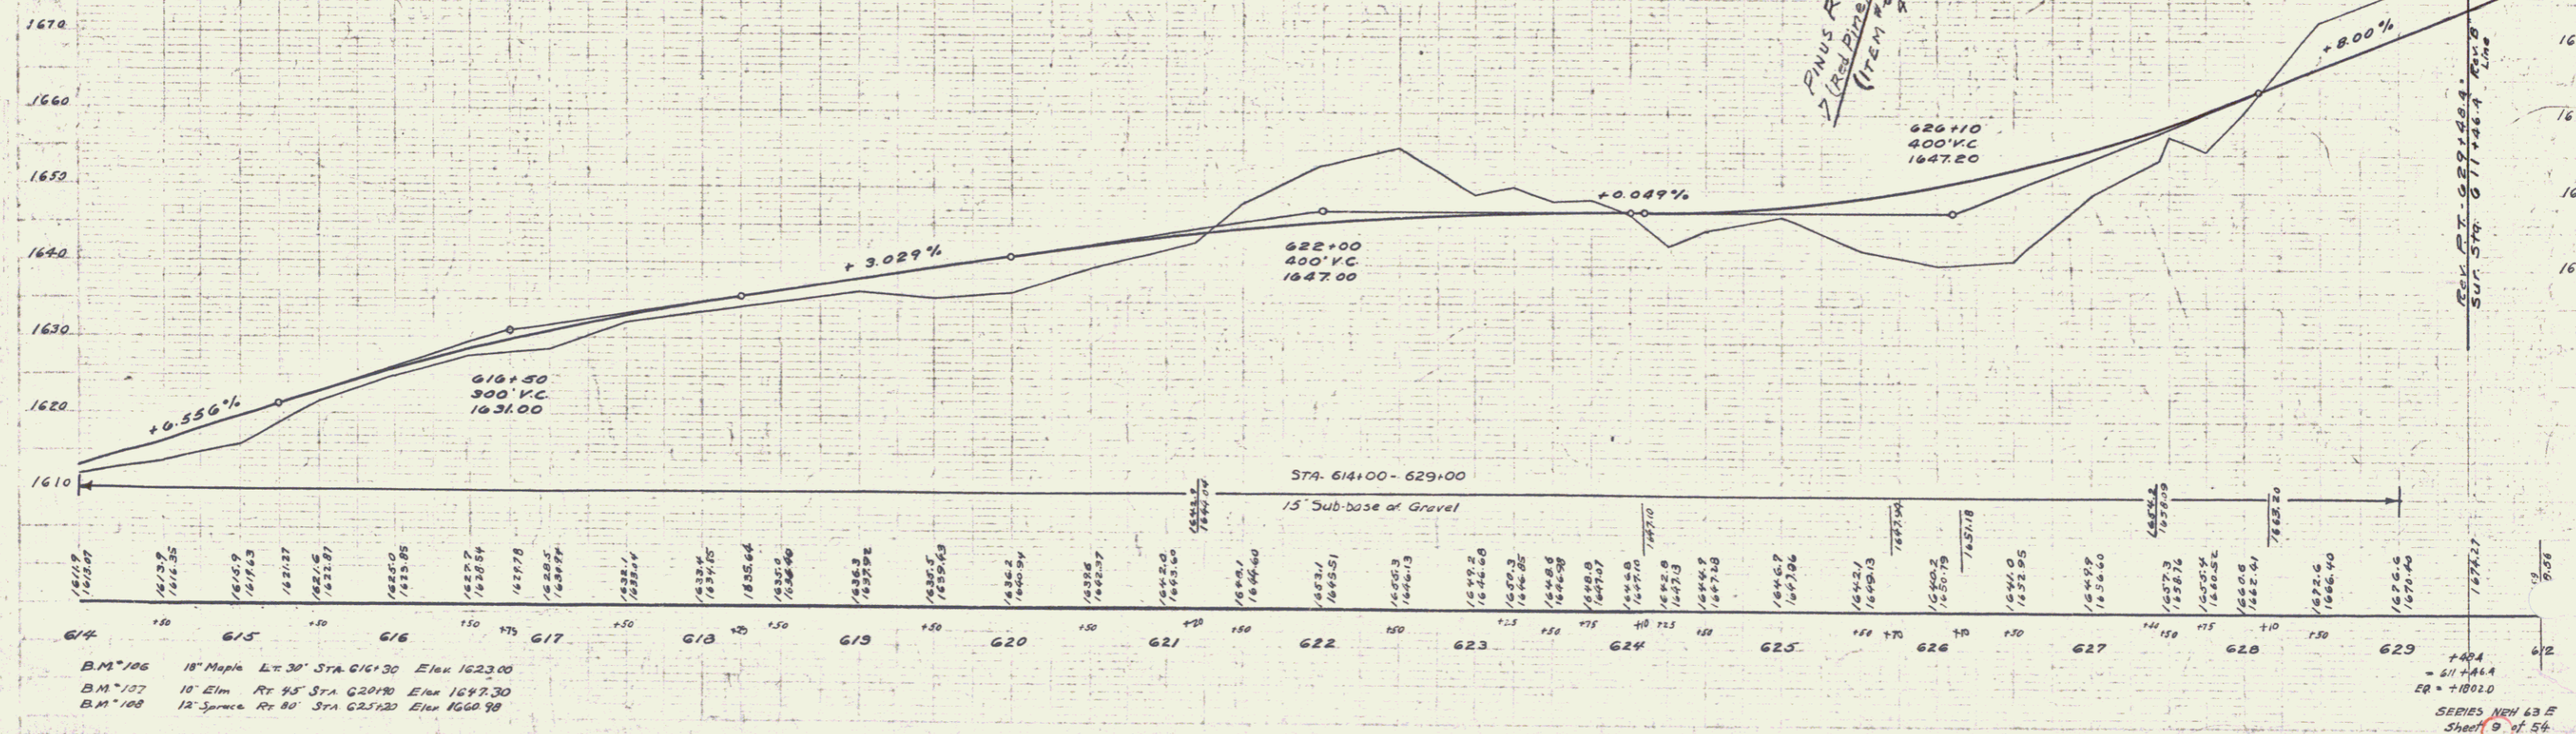


DARCEL	KIND OF INSTRUMENT	DATE OF INSTRUMENT	GRANTOR	GRANTEE	RECORDED MARLBORO	REMARKS
A-D	W-D	10-11-35	H.P. WHITE	ST. OF VT.	11-435 14	370-11
A-B	W.D.	6-5-34	W.H. ADAMS	"	6-15-34 10	491-492
A-C	W.D.	2-1-34	R.L. MACNEIL	"	4-6-34 18	475-476

NO.	DATE	BY	TOTAL SHEETS
652	12-24	J.S.	54

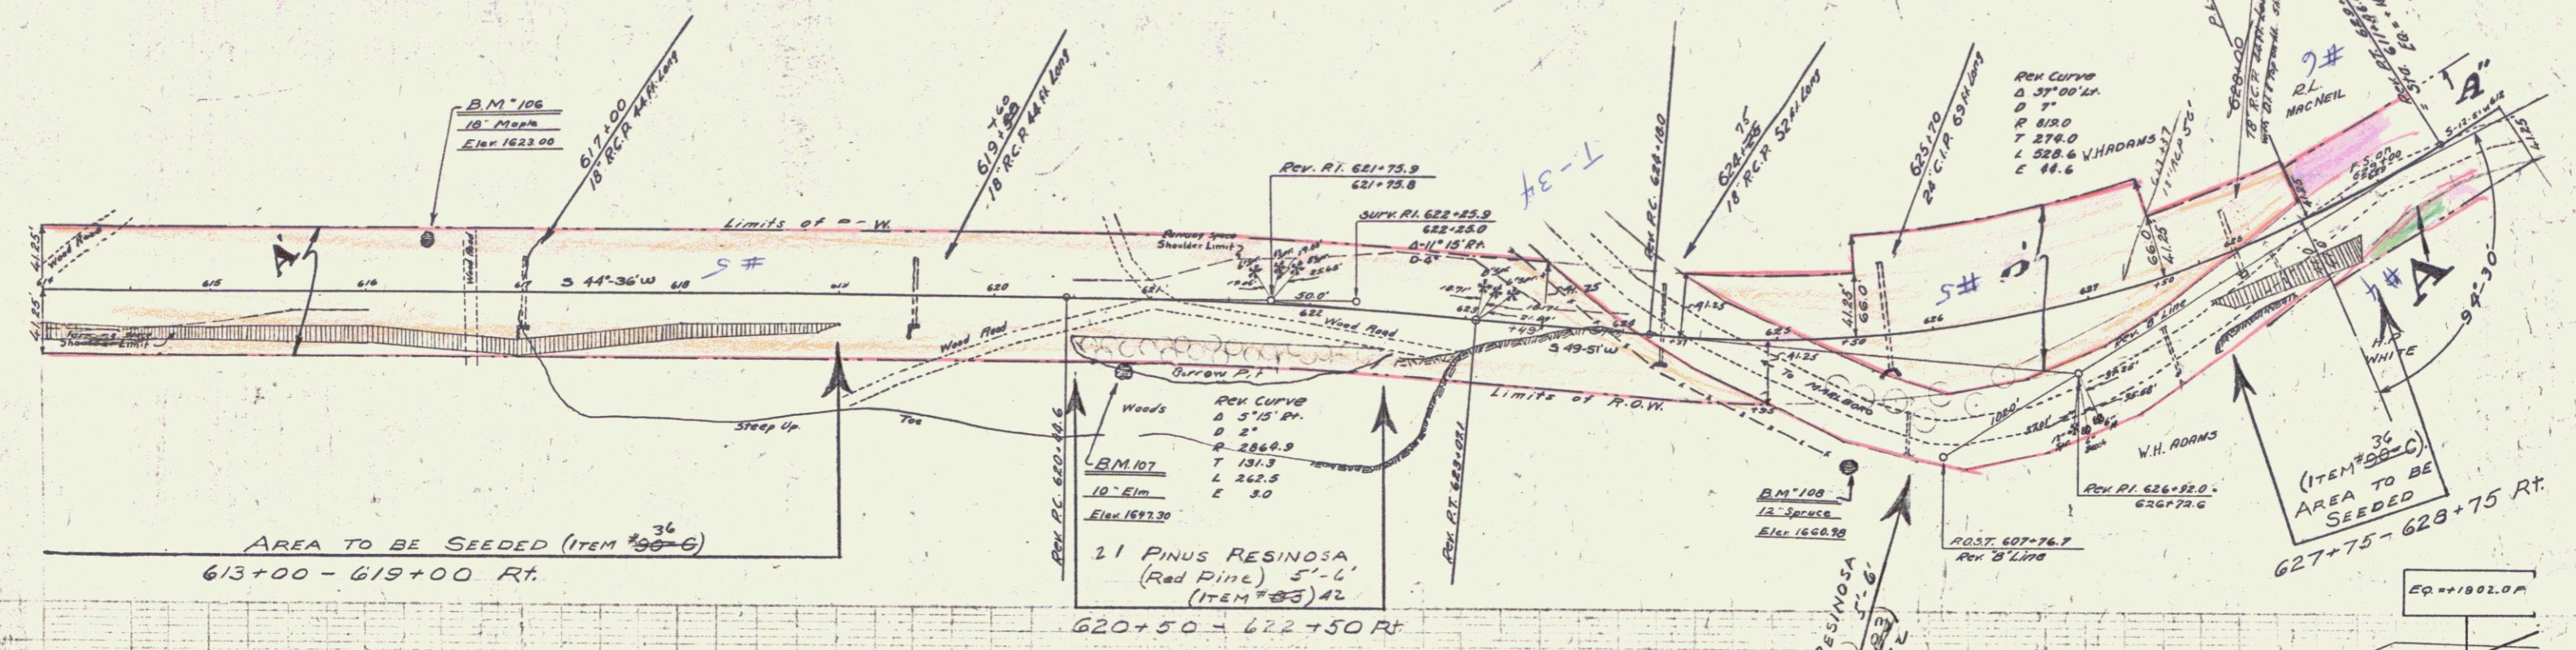

B.M. 106 10' Maple Lx 30' STA 616+30 Elev 1623.00
 B.M. 107 10' Elm Rt 35' STA 620+30 Elev 1627.30
 B.M. 108 12' Spruce Rt 80' STA 625+30 Elev 1600.90

SERIES NEW 65 E
 Sheet 9 of 54