
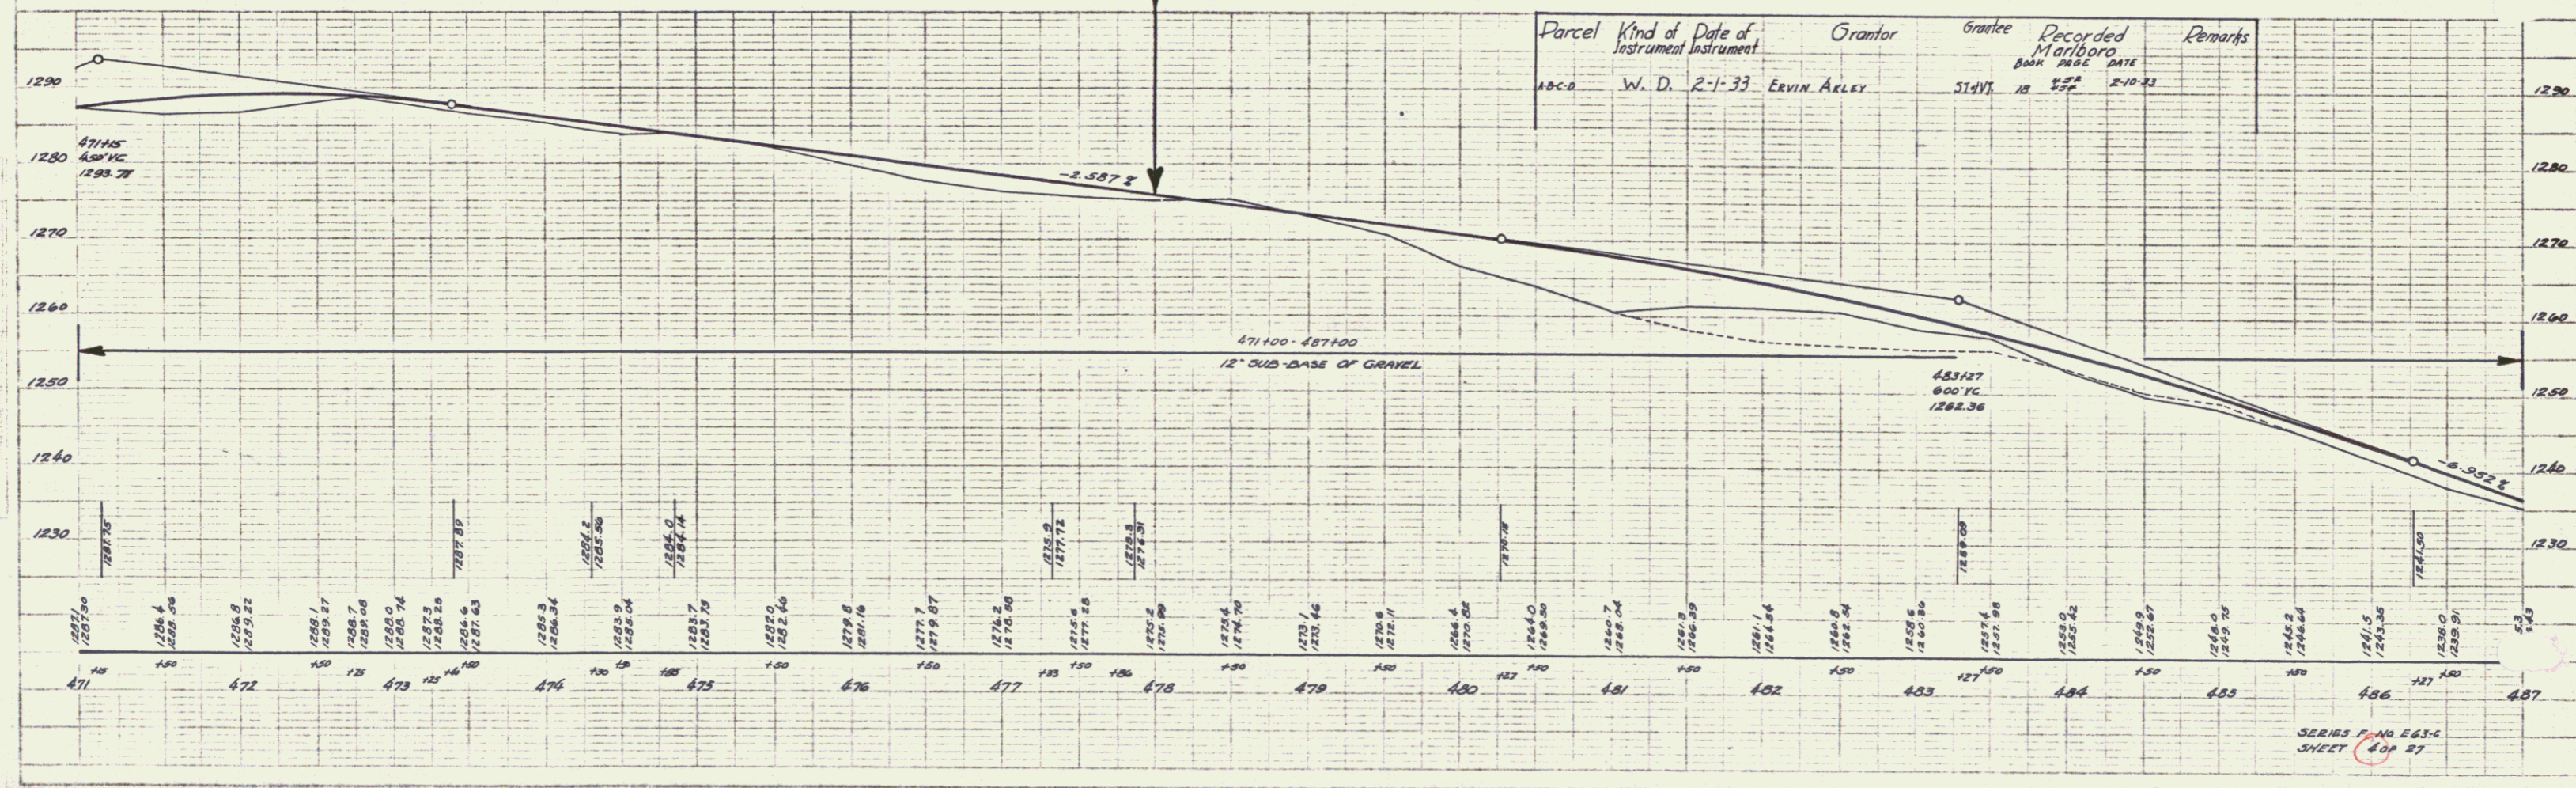


FED. ROAD DIST. NO.	STATE	FED. AID PROJ. NO.	FISCAL YEAR	SHEET NO.	TOTAL SHEETS
9	VI.	EG3C	1934	27	27

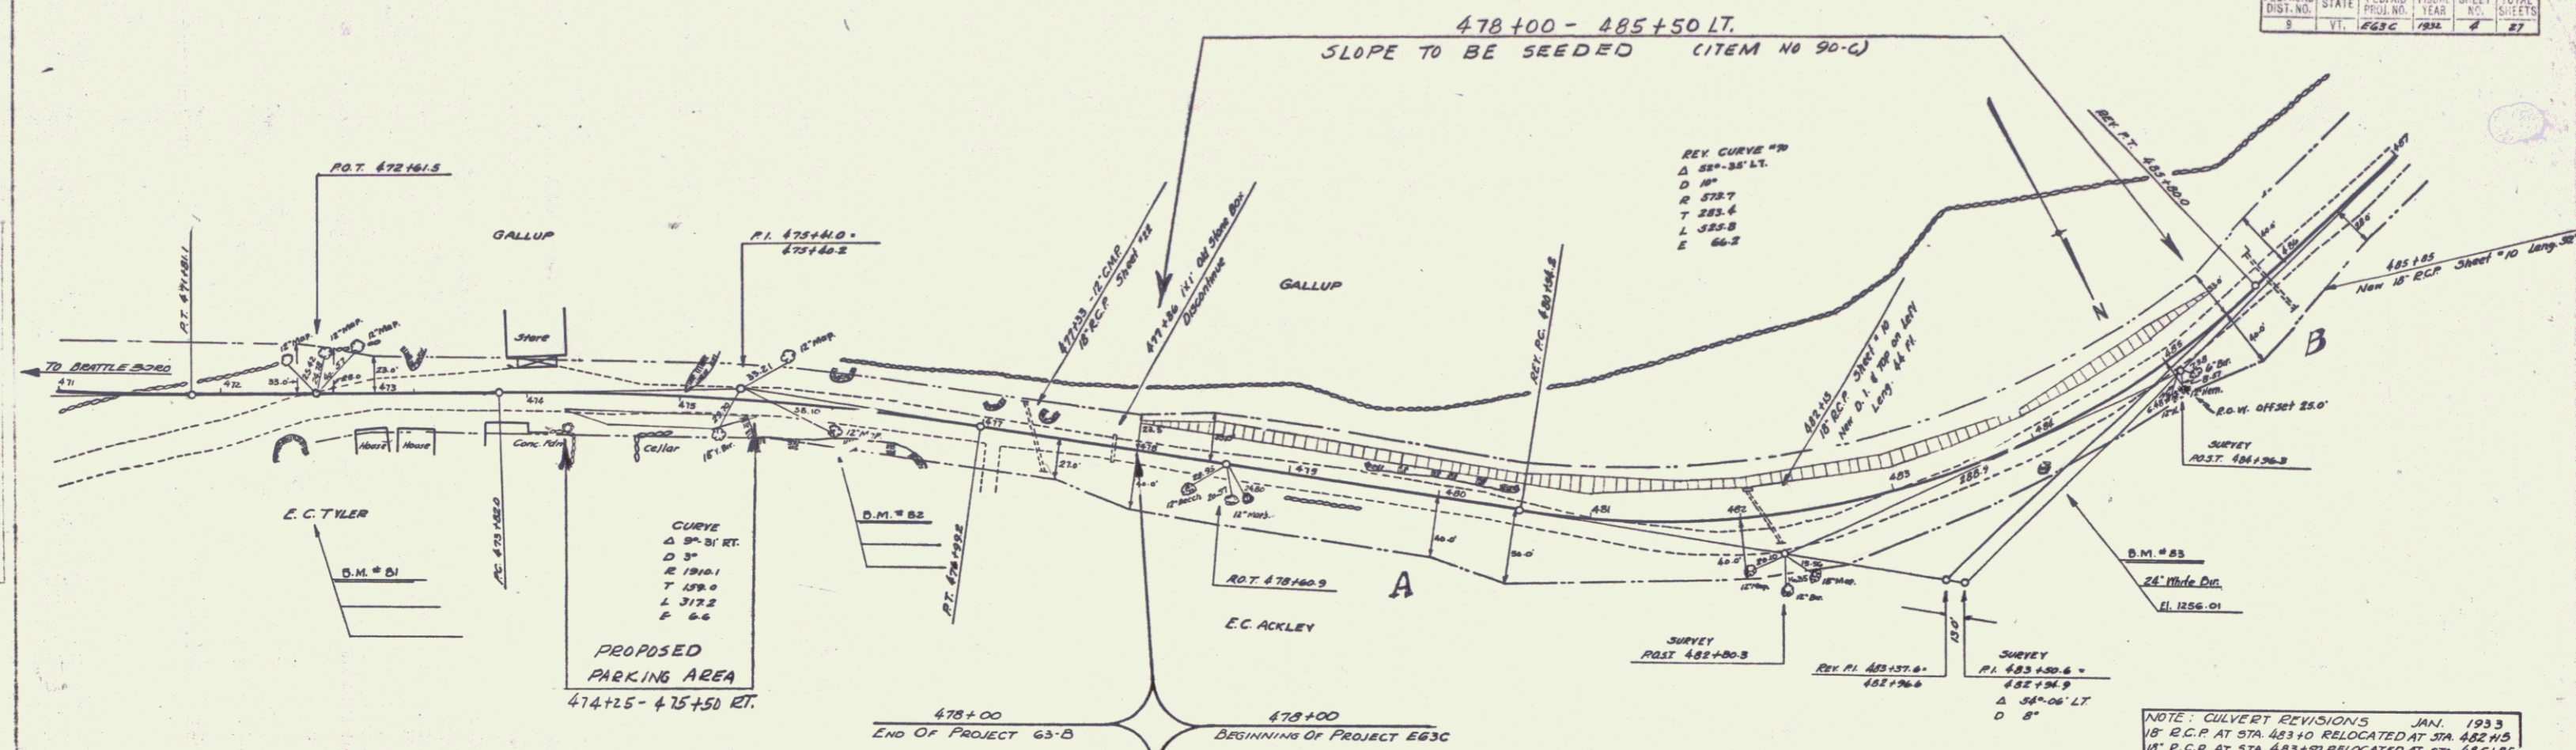

SERIES F. NO. 663-C
SHEET 27 OF 27