


PARCEL	KIND OF INSTRUMENT	DATE	GRANTOR	GARTEE	RECORDED	REMARKS
A-B-C-D-E	W.D.	2-1-33	ERVIN AKLEY	ST. J. V.	BOOK PAGE DATA 18 46 2-10-33	

NOTE: CULVERT REVISIONS JAN. 1933
 26' R.C.P. AT STA. 523+00 TO BE DECREASED TO 18' R.C.P.
 26' R.C.P. " " 529+07 " " INCREASED TO 30' "

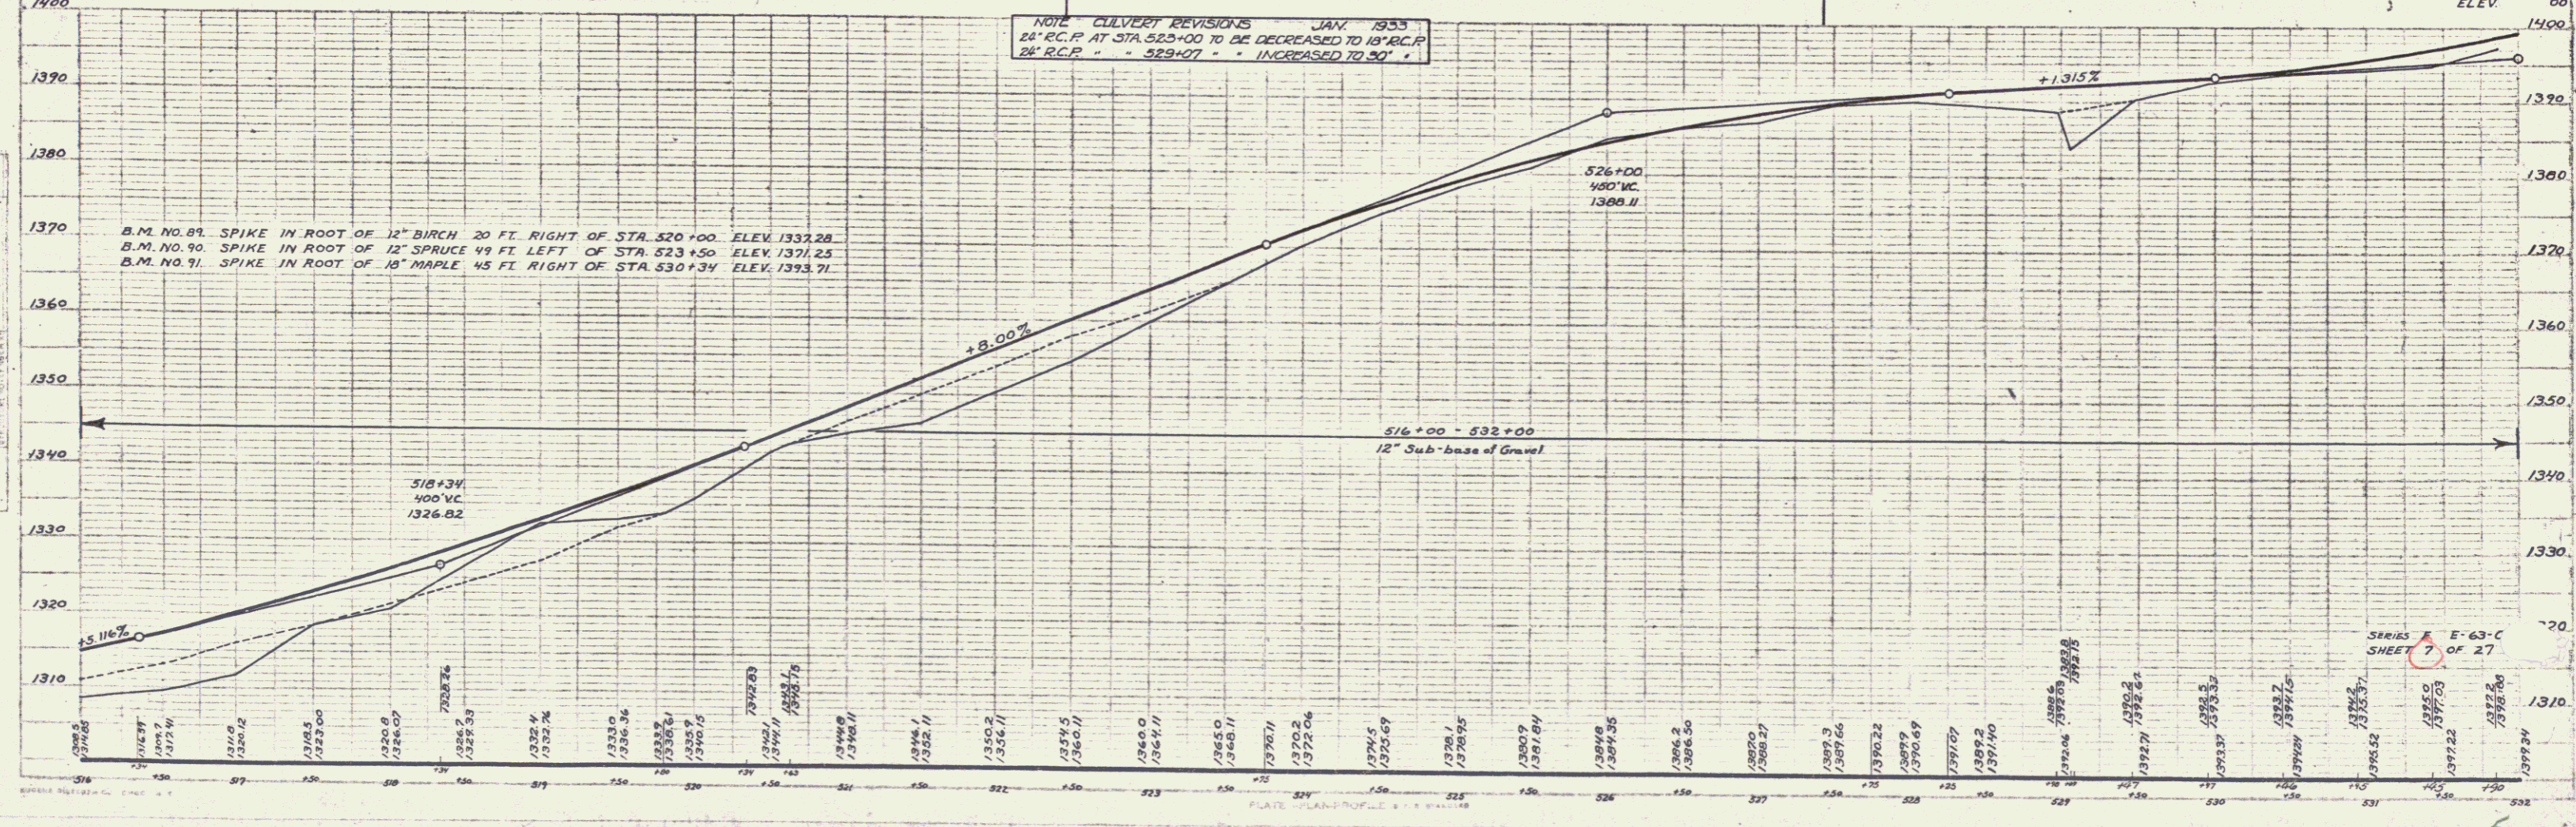

B.M. NO. 89. SPIKE IN ROOT OF 12" BIRCH 20 FT. RIGHT OF STA. 520+00 ELEV. 1337.28
 B.M. NO. 90. SPIKE IN ROOT OF 12" SPRUCE 49 FT. LEFT OF STA. 523+50 ELEV. 1371.25
 B.M. NO. 91. SPIKE IN ROOT OF 10" MAPLE 45 FT. RIGHT OF STA. 530+34 ELEV. 1393.71