
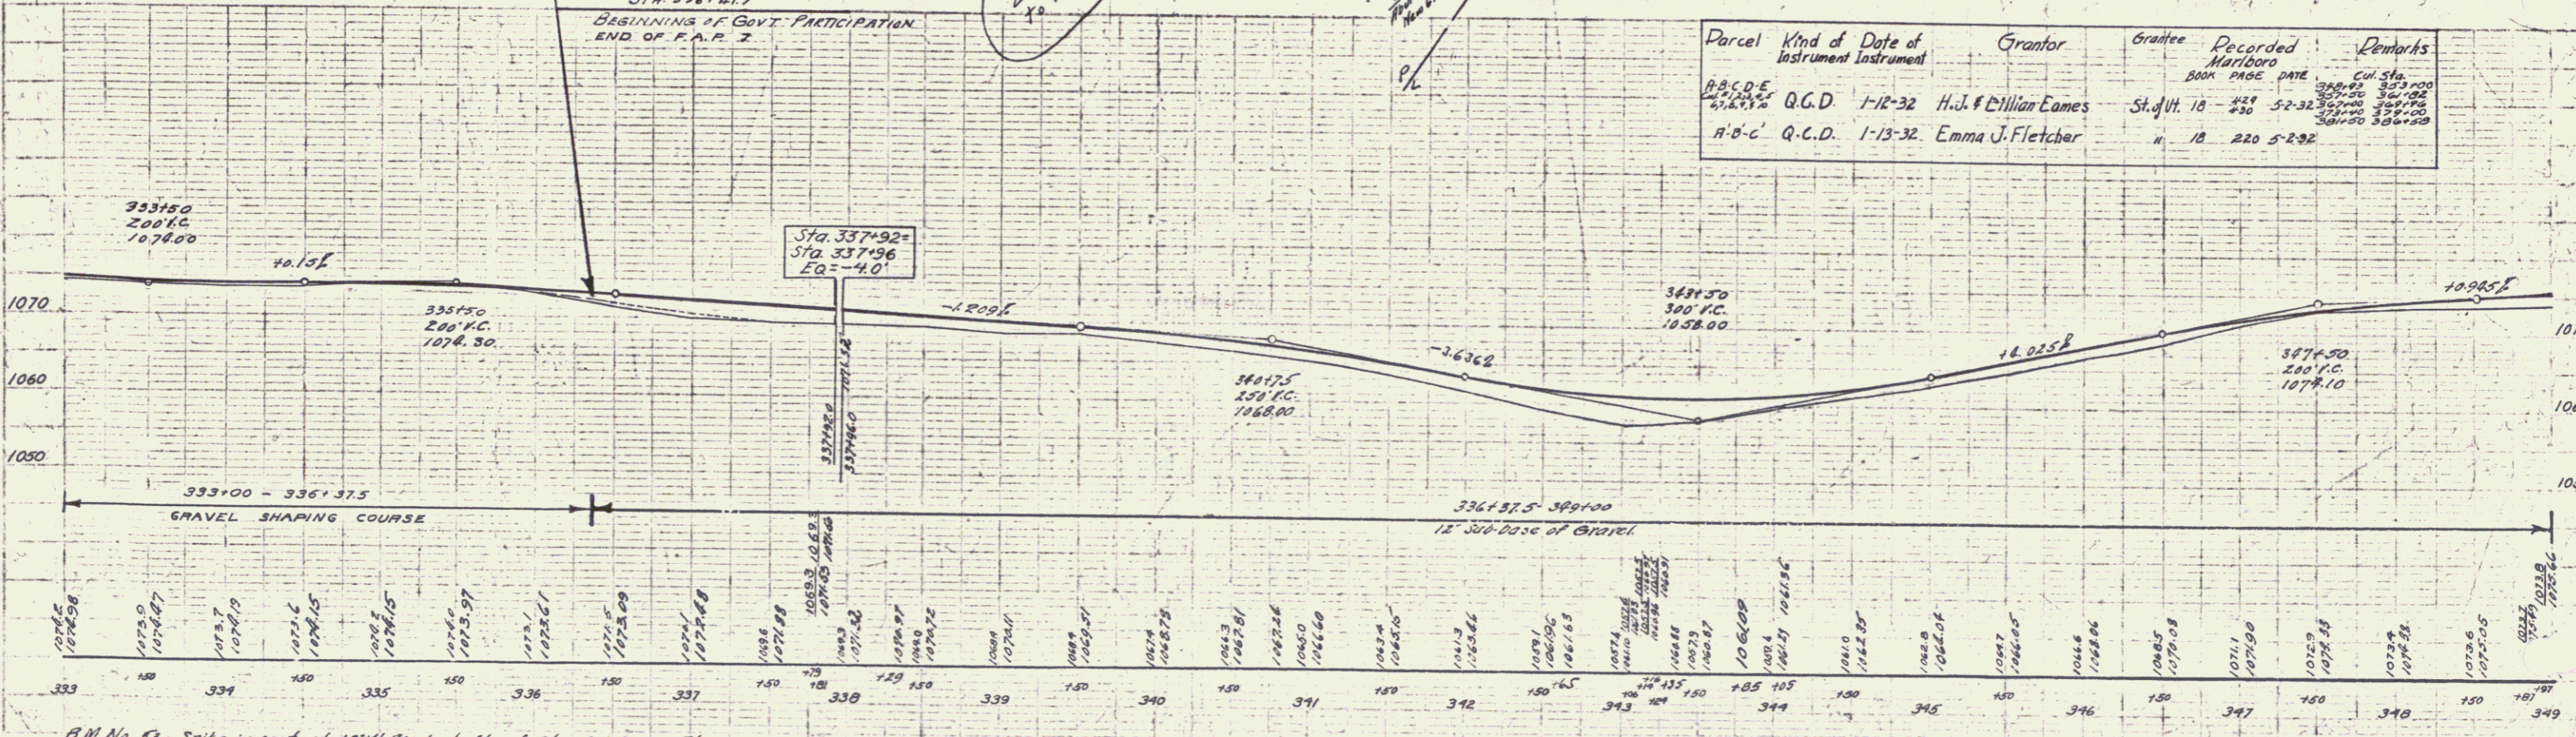


WOOD GUYLE POSTS REQUIRED		CABLE GUARD RAIL REQUIRED		NEW ROUND CONE PILE CURBETS REQUIRED		NEW ROUND CONE BOX CURBETS REQUIRED						
CULE STA.	LEFT	RIGHT	STATION	LENG	CONST.	PAYMENT	STATION	SIZE	CON. #	STREEL	STRUCT. EXC.	
333+94	1	1	34215	343+41.7	72'	40'	112'	34717	24"	42"	64 CY	
348+97	1	1	34318	344+00	36'	40'	136'	34879	18"	40"	18	
								34918	24"	32 1/2"	375'	128 CY

63-B 1922 S. 50

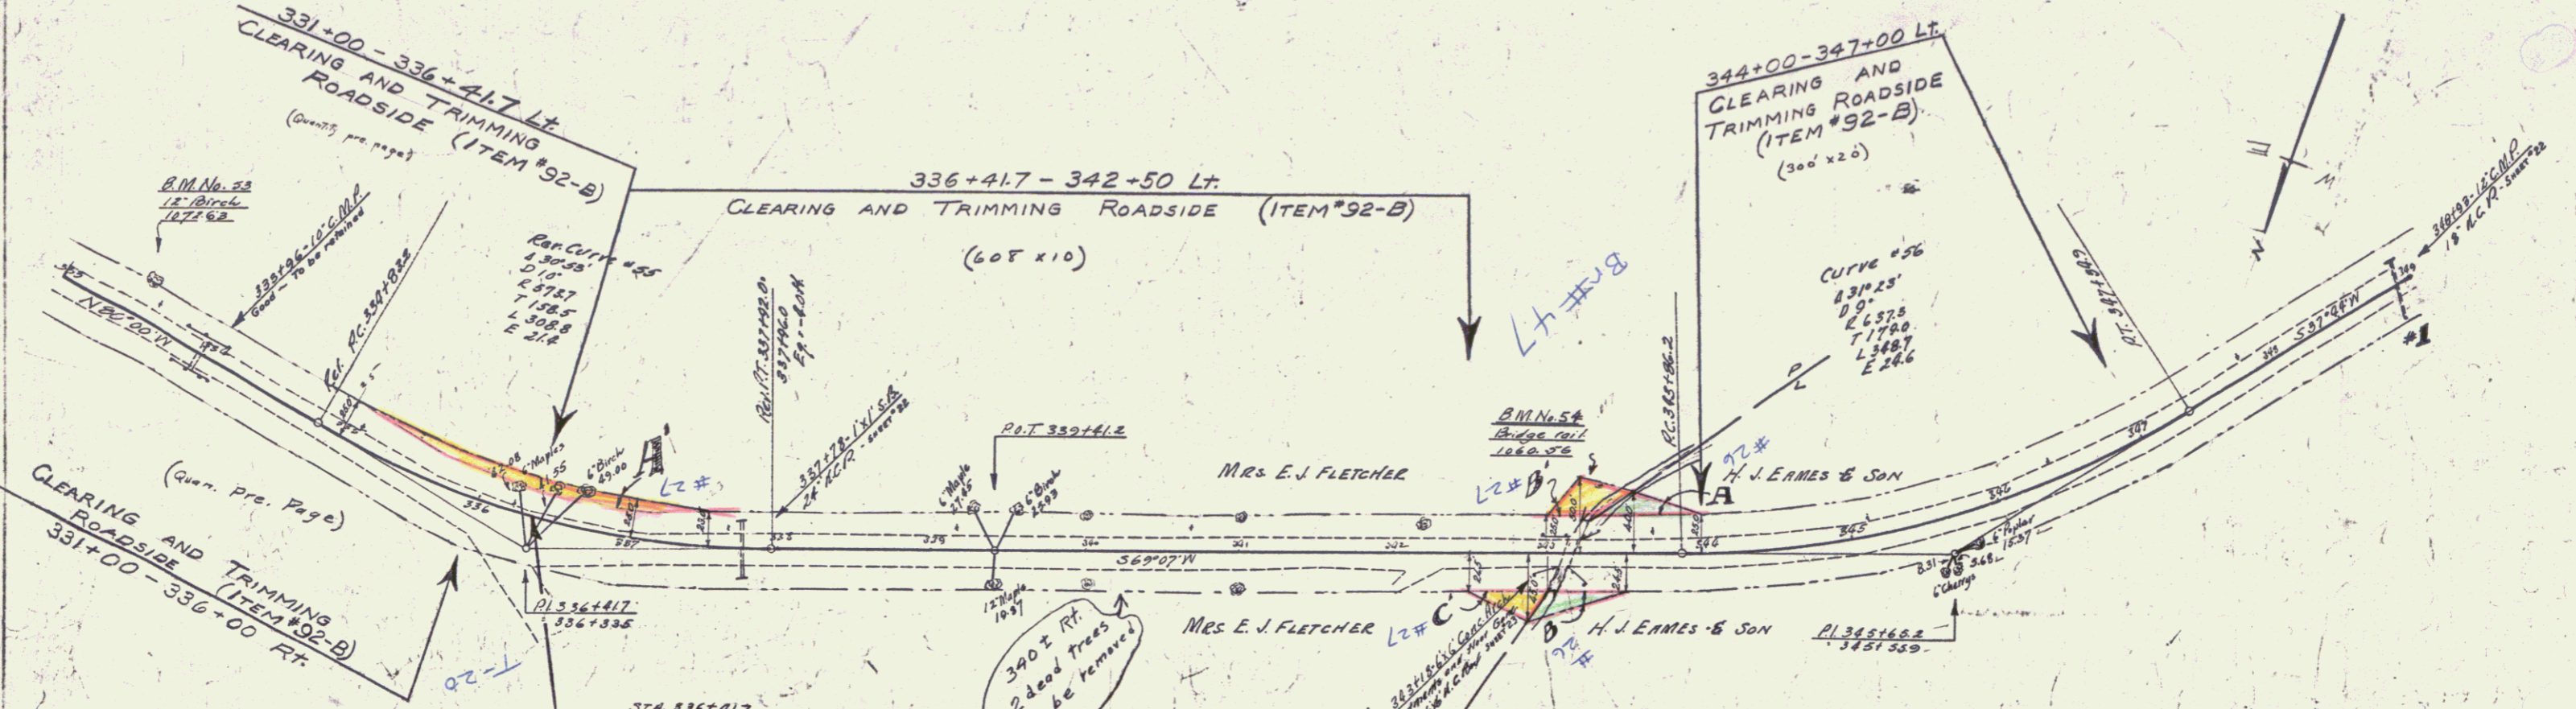

Parcel	Kind of Instrument	Date of Instrument	Grantor	Grantee	Recorded	Remarks
A, B, C, D, E	Q.C.D.	1-12-32	H. J. Eames	St. J. H. 10	439	52-32
A, B, C	Q.C.D.	1-13-32	Emma J. Fletcher	" 10	220	5-232

B.M. No. 53. Spile in root of 12" W. Birch, left of Sta. 333150 Elev. 1072.63
 B.M. No. 54. Top of SE post on bridge, left of Sta. 343135 Elev. 1062.76

SERIES F. No. 63-B
 SHEET 5 OF 50