



WOOD GUIDE RAIL REQUIRED				CABLE GUARD RAIL REQUIRED				NEW RAIN GONG PIPE COLLECTORS REQUIRED				
CUH. STA.	Left	Right	Stations	Length	Count	Material	Sta.	Width	Length	CUH. H.	C.R.M.	Steel
361182			361182-365100 Lk	338'	40'	372'	353100	10'	36'	1.6cy	-	-
							357150	15'	36'	-	1.6'	-
							361182	30'	48'	2.1cy	1.6'	36

WOOD GUIDE Posts Required  
 CUH. STA. Left Right  
 353100 / /  
 357150 / /

349+75 - 350+75 Lt.  
 PROPOSED PARKING AREA

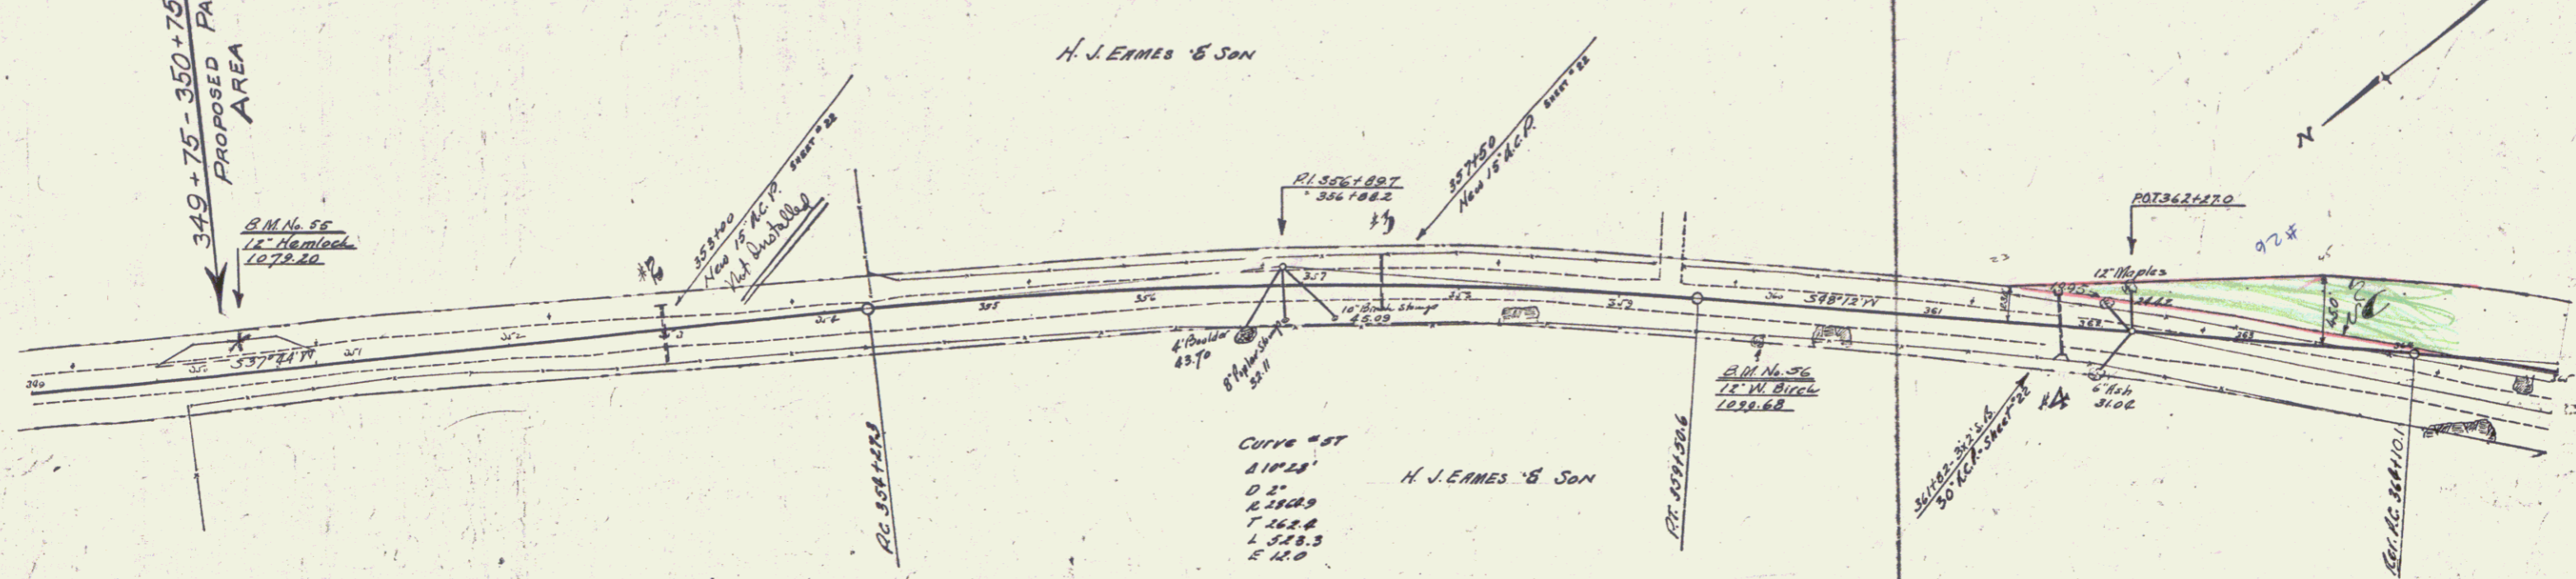

Parcel	Kind of Instrument	Date of Instrument	Grantor	Grantee	Recorded	Remarks
365100	Q.C.D.	1-12-32	H. J. & Lillian Eames	Shuffh.	10-23-32	5-2-32

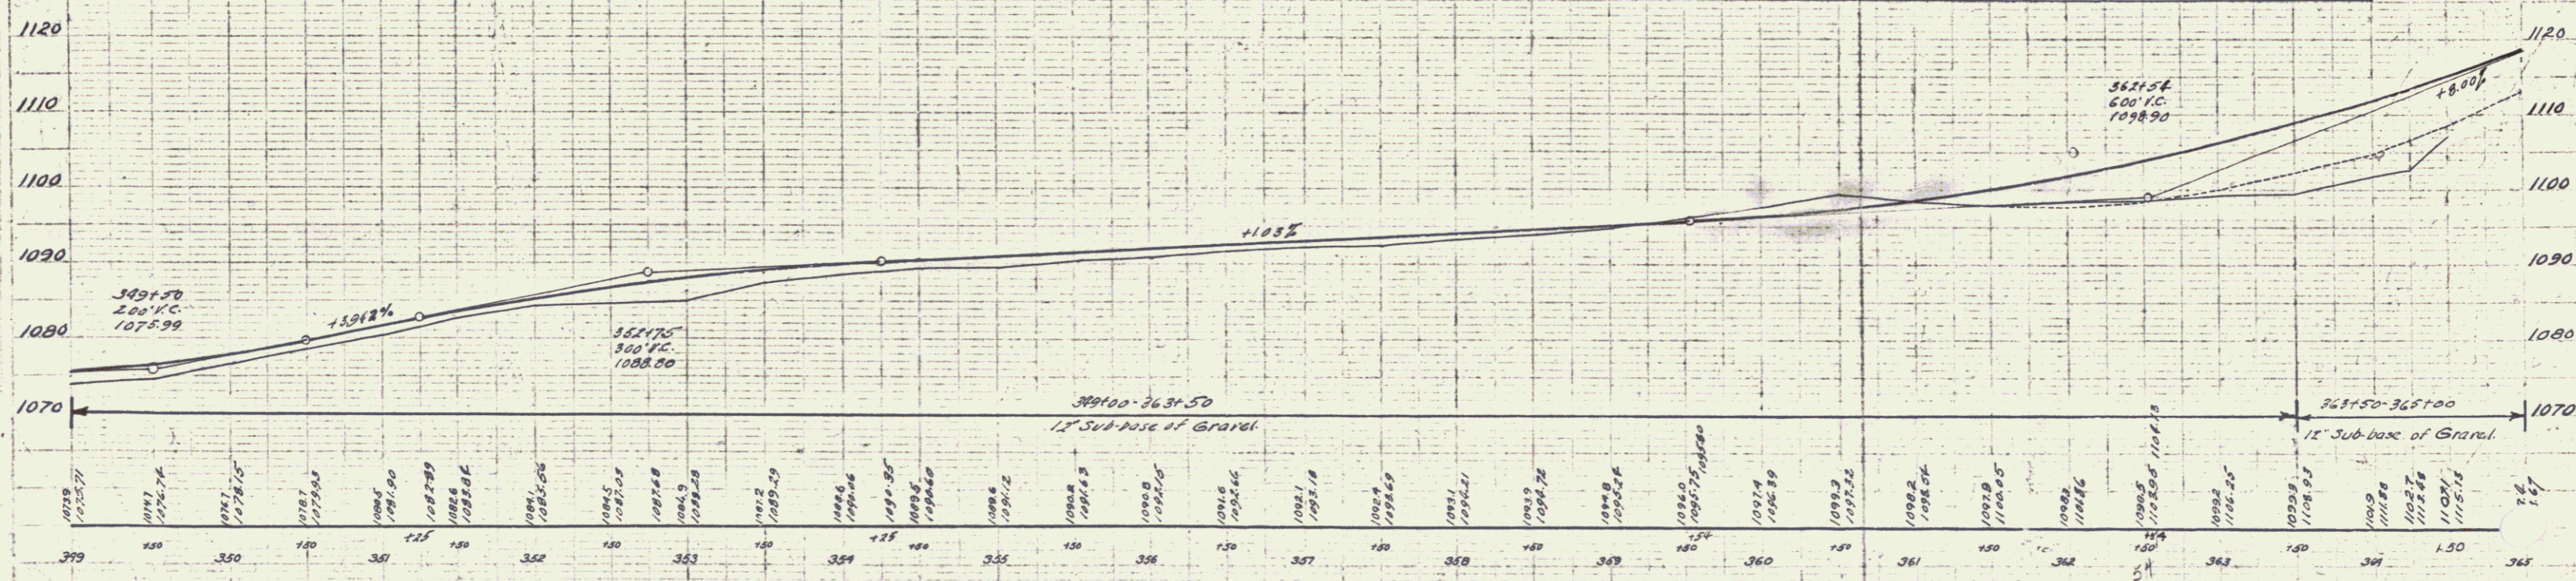

B.M. No. 55. Spike in root of 12" Hemlock, left of Sta. 350+25. Elev. 1079.20.  
 B.M. No. 56. Spike in root of 12" W. Birch, right of Sta. 360+00. Elev. 1099.68