


WOOD GUARD RAIL REQUIRED			CRIBLE GUARD RAIL REQUIRED			NEW POINT CUNG PILE CULVERTS REQUIRED					
Culv. Sta.	Left	Right	Stations	Concl	Length	Station	Diam	Length	Comp. P.	Steel	C.F.M.
369796		24'	367100-367244	46'	22'	367100	18"	52'	5.2	58	1.8
369796			367196			367196	30"	48'			1.8
379700			375149			375149	18"	44'			1.8
379700			379100			379100	15"	48'			1.8

WOOD GUARD POSTS REQUIRED		
Culv. Sta.	Right	Left
367100	1	1
369196	1	1
379100	1	1
379700	1	1

STATE OF ILLINOIS  
 COUNTY OF COOK  
 63-B 1932 7 50

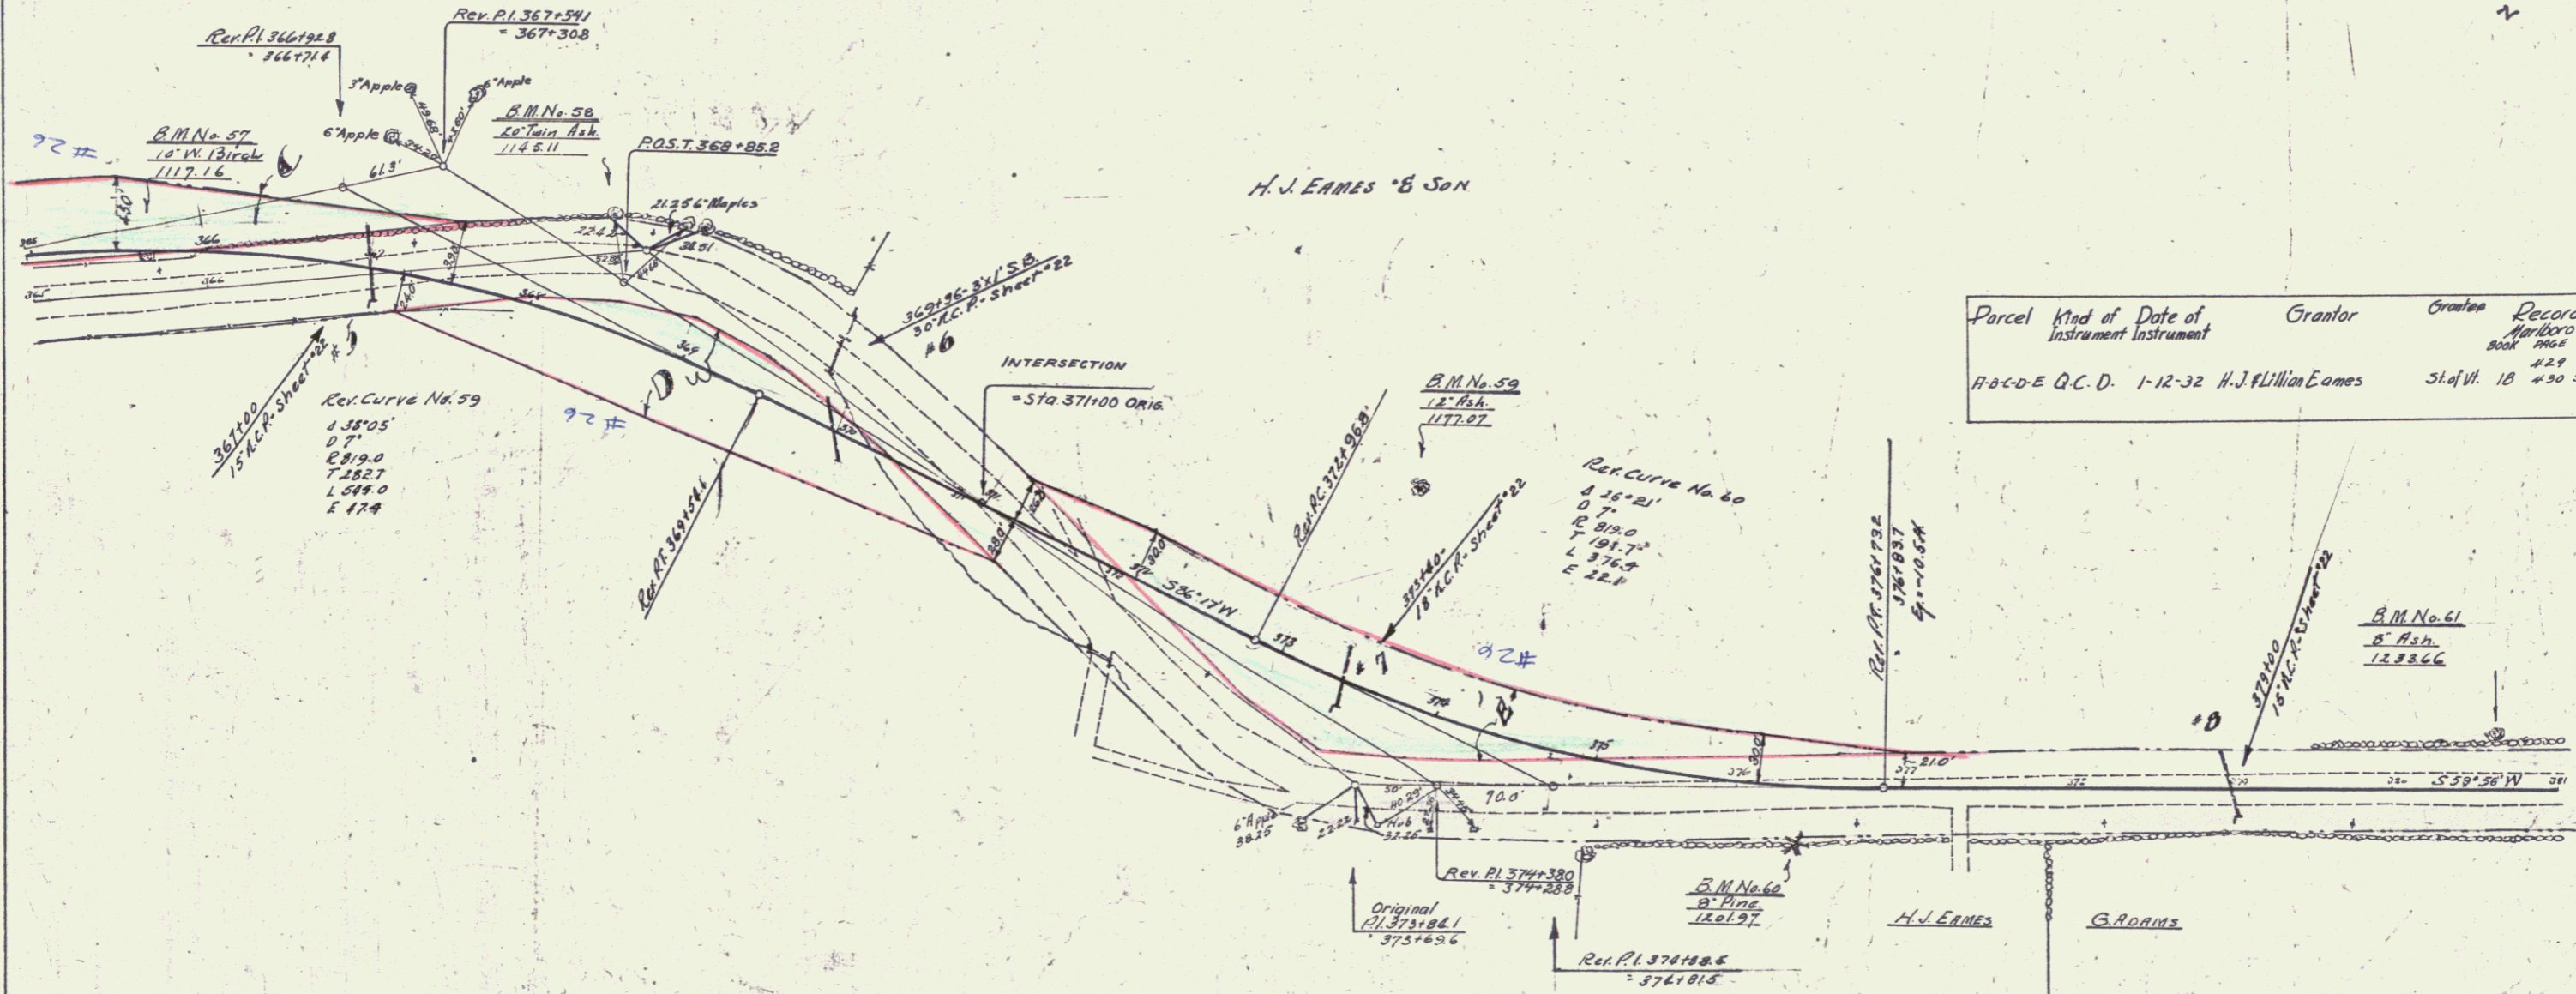

Parcel	Kind of Instrument	Date of Instrument	Grantor	Grantee	Recorded	Remarks
A-B-C-D-E	Q.C.D.	1-12-32	H.J. William Eames	St. of Ill.	18	430 5-2-32 367100 369196 375149 379100 381150 386150

5