


MARK BOOK ELEMENTS CHECKED BY FIELD CHECKER NO.

MARK BOOK ELEMENTS CHECKED BY FIELD CHECKER NO.

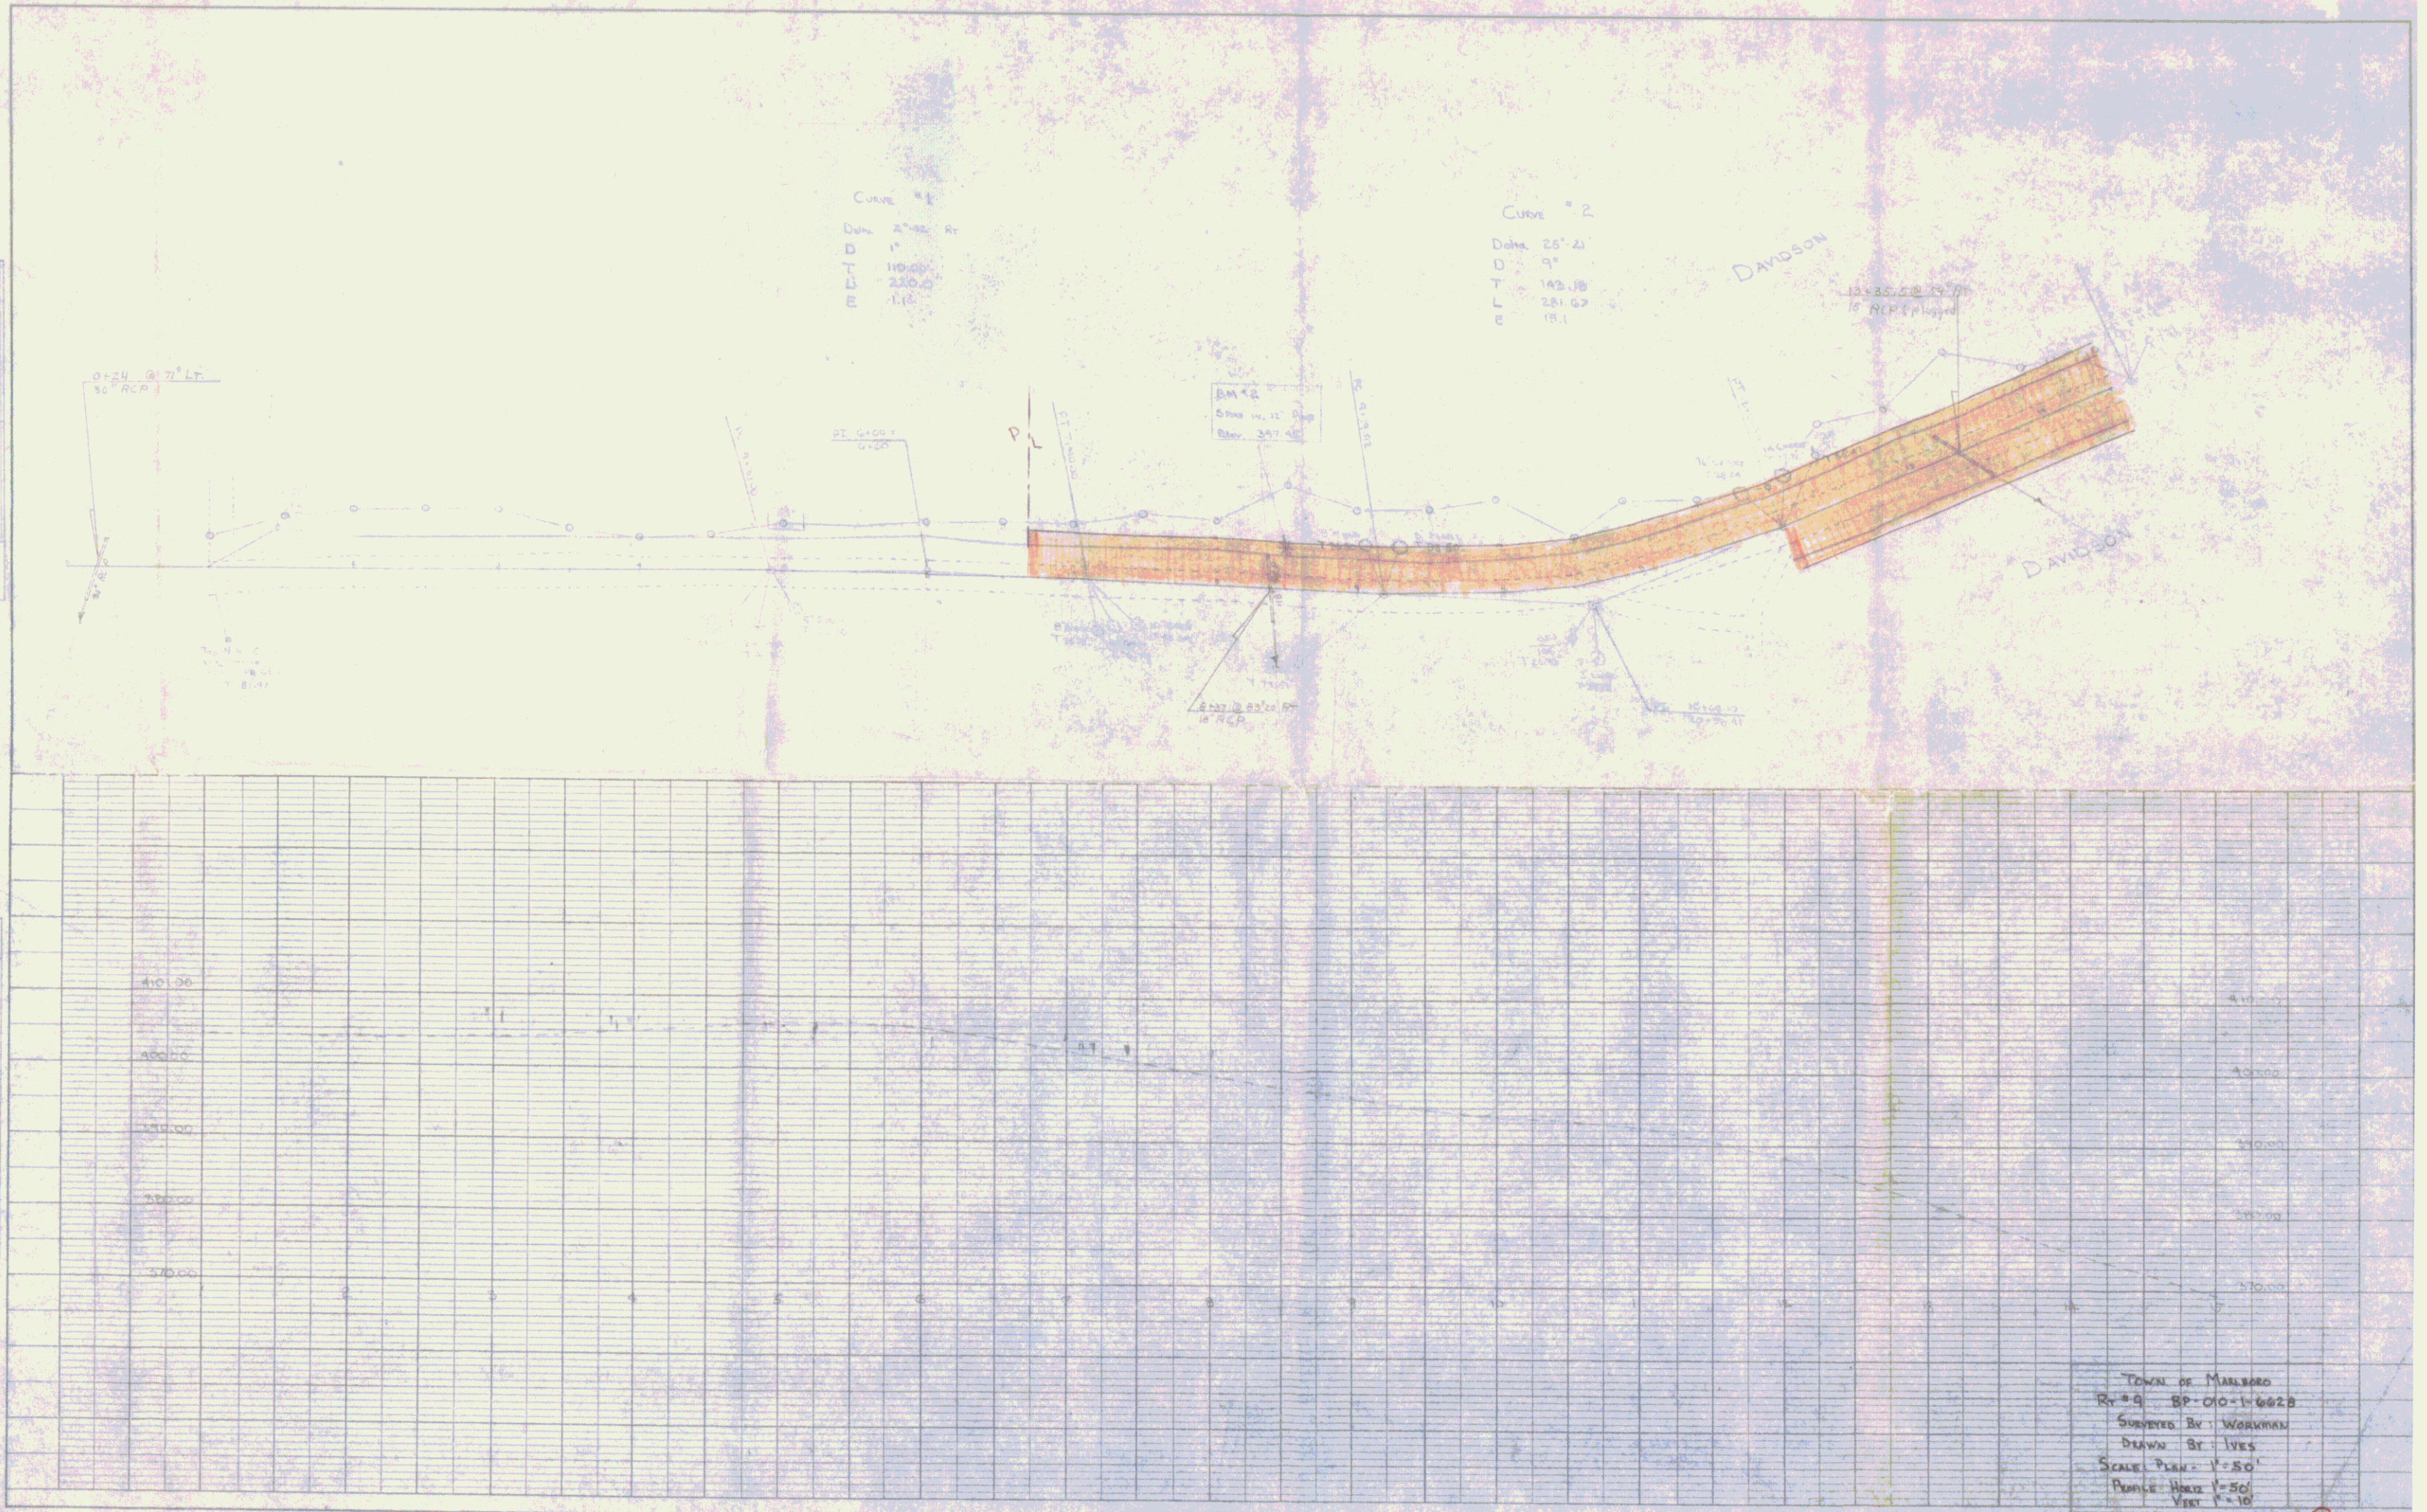

TOWN OF MARLBORO
BY: G. B. O. - 11/6/28
SURVEYED BY: WORKMAN
DRAWN BY: VES
SCALE: PLAN = 1" = 50'
PROFILE: VERT = 1" = 10'

SHEET 1A of 2

K-E PLATE 1. PLAN PROFILE
KORREL & ASSOC. CO.

1A