

INDEX OF SHEETS

SHEET NO	TITLE PAGE
2	TYPICAL CROSS-SECTION OF IMPROVEMENT
3	PLAN AND PROFILE STA. 0+00 TO STA. 13+00
4	" " " 13+00 " 28+00
5	" " " 28+00 " 43+00
6	" " " 43+00 " 58+00
7	" " " 58+00 " 73+00
8	" " " 73+00 " 87+00
9-16	CROSS-SECTIONS

FED. ROAD DIST. NO.	STATE	FED. AID PROJ. NO.	FISCAL YEAR	SHEET NO.	TOTAL SHEETS
0	VT.	7	1917	1	16


STATE OF VERMONT  
STATE HIGHWAY DEPARTMENT

PLAN AND PROFILE OF PROPOSED  
STATE HIGHWAY  
FEDERAL AID PROJECT

Pin # 99R842

TOWN OF MARLBORO  
BRATTLEBORO-WILMINGTON ROAD  
FROM CHURCH HOLLOW CORNERS TO BRATTLEBORO LINE

SCALES PLAN 1" = 80' FT.  
PROFILE HORIZ. 1" = 20' FT. VERT. 1" = 10' FT.  
CROSS-SECTIONS 1" = 8' FT.

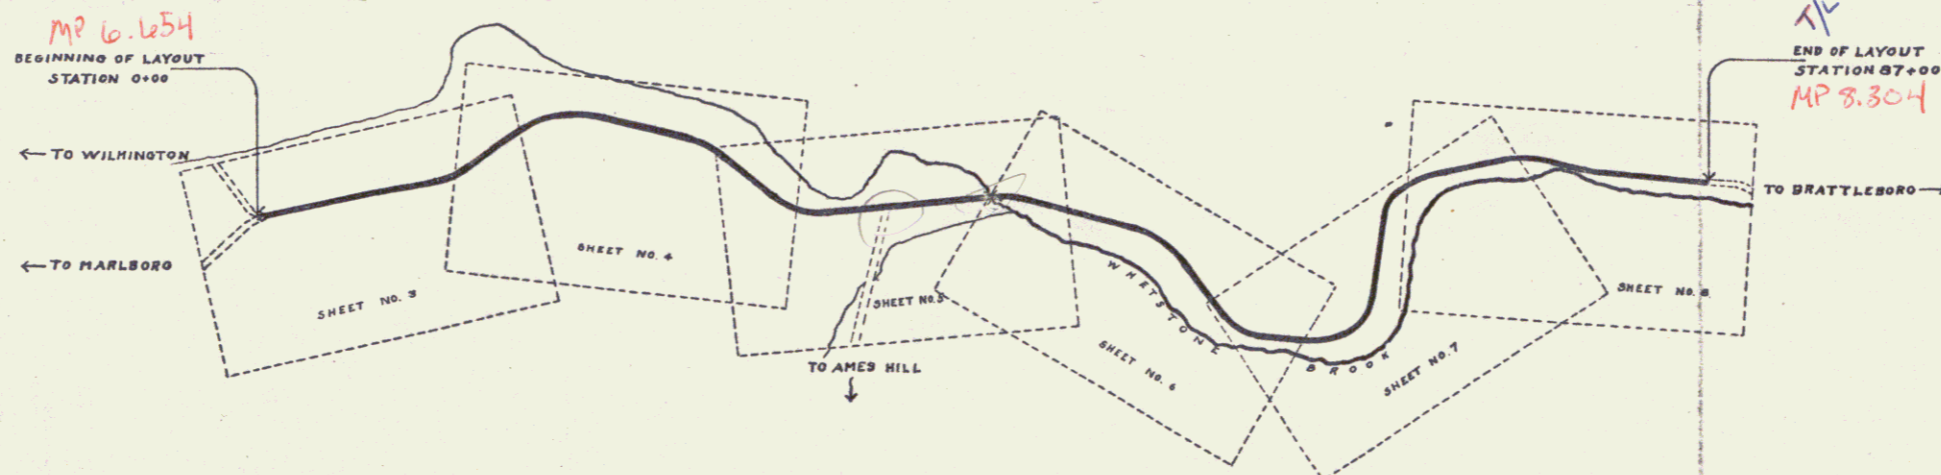

Tk Brattleboro

RIGHT-OF-WAY DIVISION  
TOWN FILE  
PERPETUAL  
Rte Town of VT 9  
(To Be Returned To R.O.W. Division)

PROJECT NUMBER	LENGTH	DATE
Marlboro F-7		1/1/20
CONTRACTOR	TYPE	
LOCATION	see file card	

CONVENTIONAL SIGNS

	GROUND ELEVATION	DATE	NAME
	GRADE ELEVATION	DATE	NAME
	CURVE DATA		
	DEFLECTION ANGLE	Δ	
	DEGREE OF CURVE	D.	
	RADIUS OF CURVE	R.	
	TANGENT DISTANCE	T.	
	LENGTH OF CURVE	L.	
	EXTERNAL DISTANCE	E.	
	POINT OF INTERSECTION	P. I.	
	POINT OF CURVE	P. C.	
	POINT OF TANGENT	P. T.	

LAYOUT  
SCALE 500 FT. = 1 INCH.

RECOMMENDED

STATE ENGINEER

SUBMITTED

STATE HIGHWAY COMMISSIONER

RECOMMENDED

DISTRICT ENGINEER

OFFICE OF PUBLIC ROAD AND RAIL ENGINEERING

RECOMMENDED FOR APPROVAL

APPROVED

DIRECTOR OFFICE OF PUBLIC ROAD AND RAIL ENGINEERING

Route VT 9  
Date 1/1/1920

Series F No. 7 Filed  
Sheet 1 of 16