


TOWNS OF
 BRATTLEBORD-MARLBORO
 Project # FAP 132A
 Pin # 99R843
 Route VT9
 Date 1/1/1940

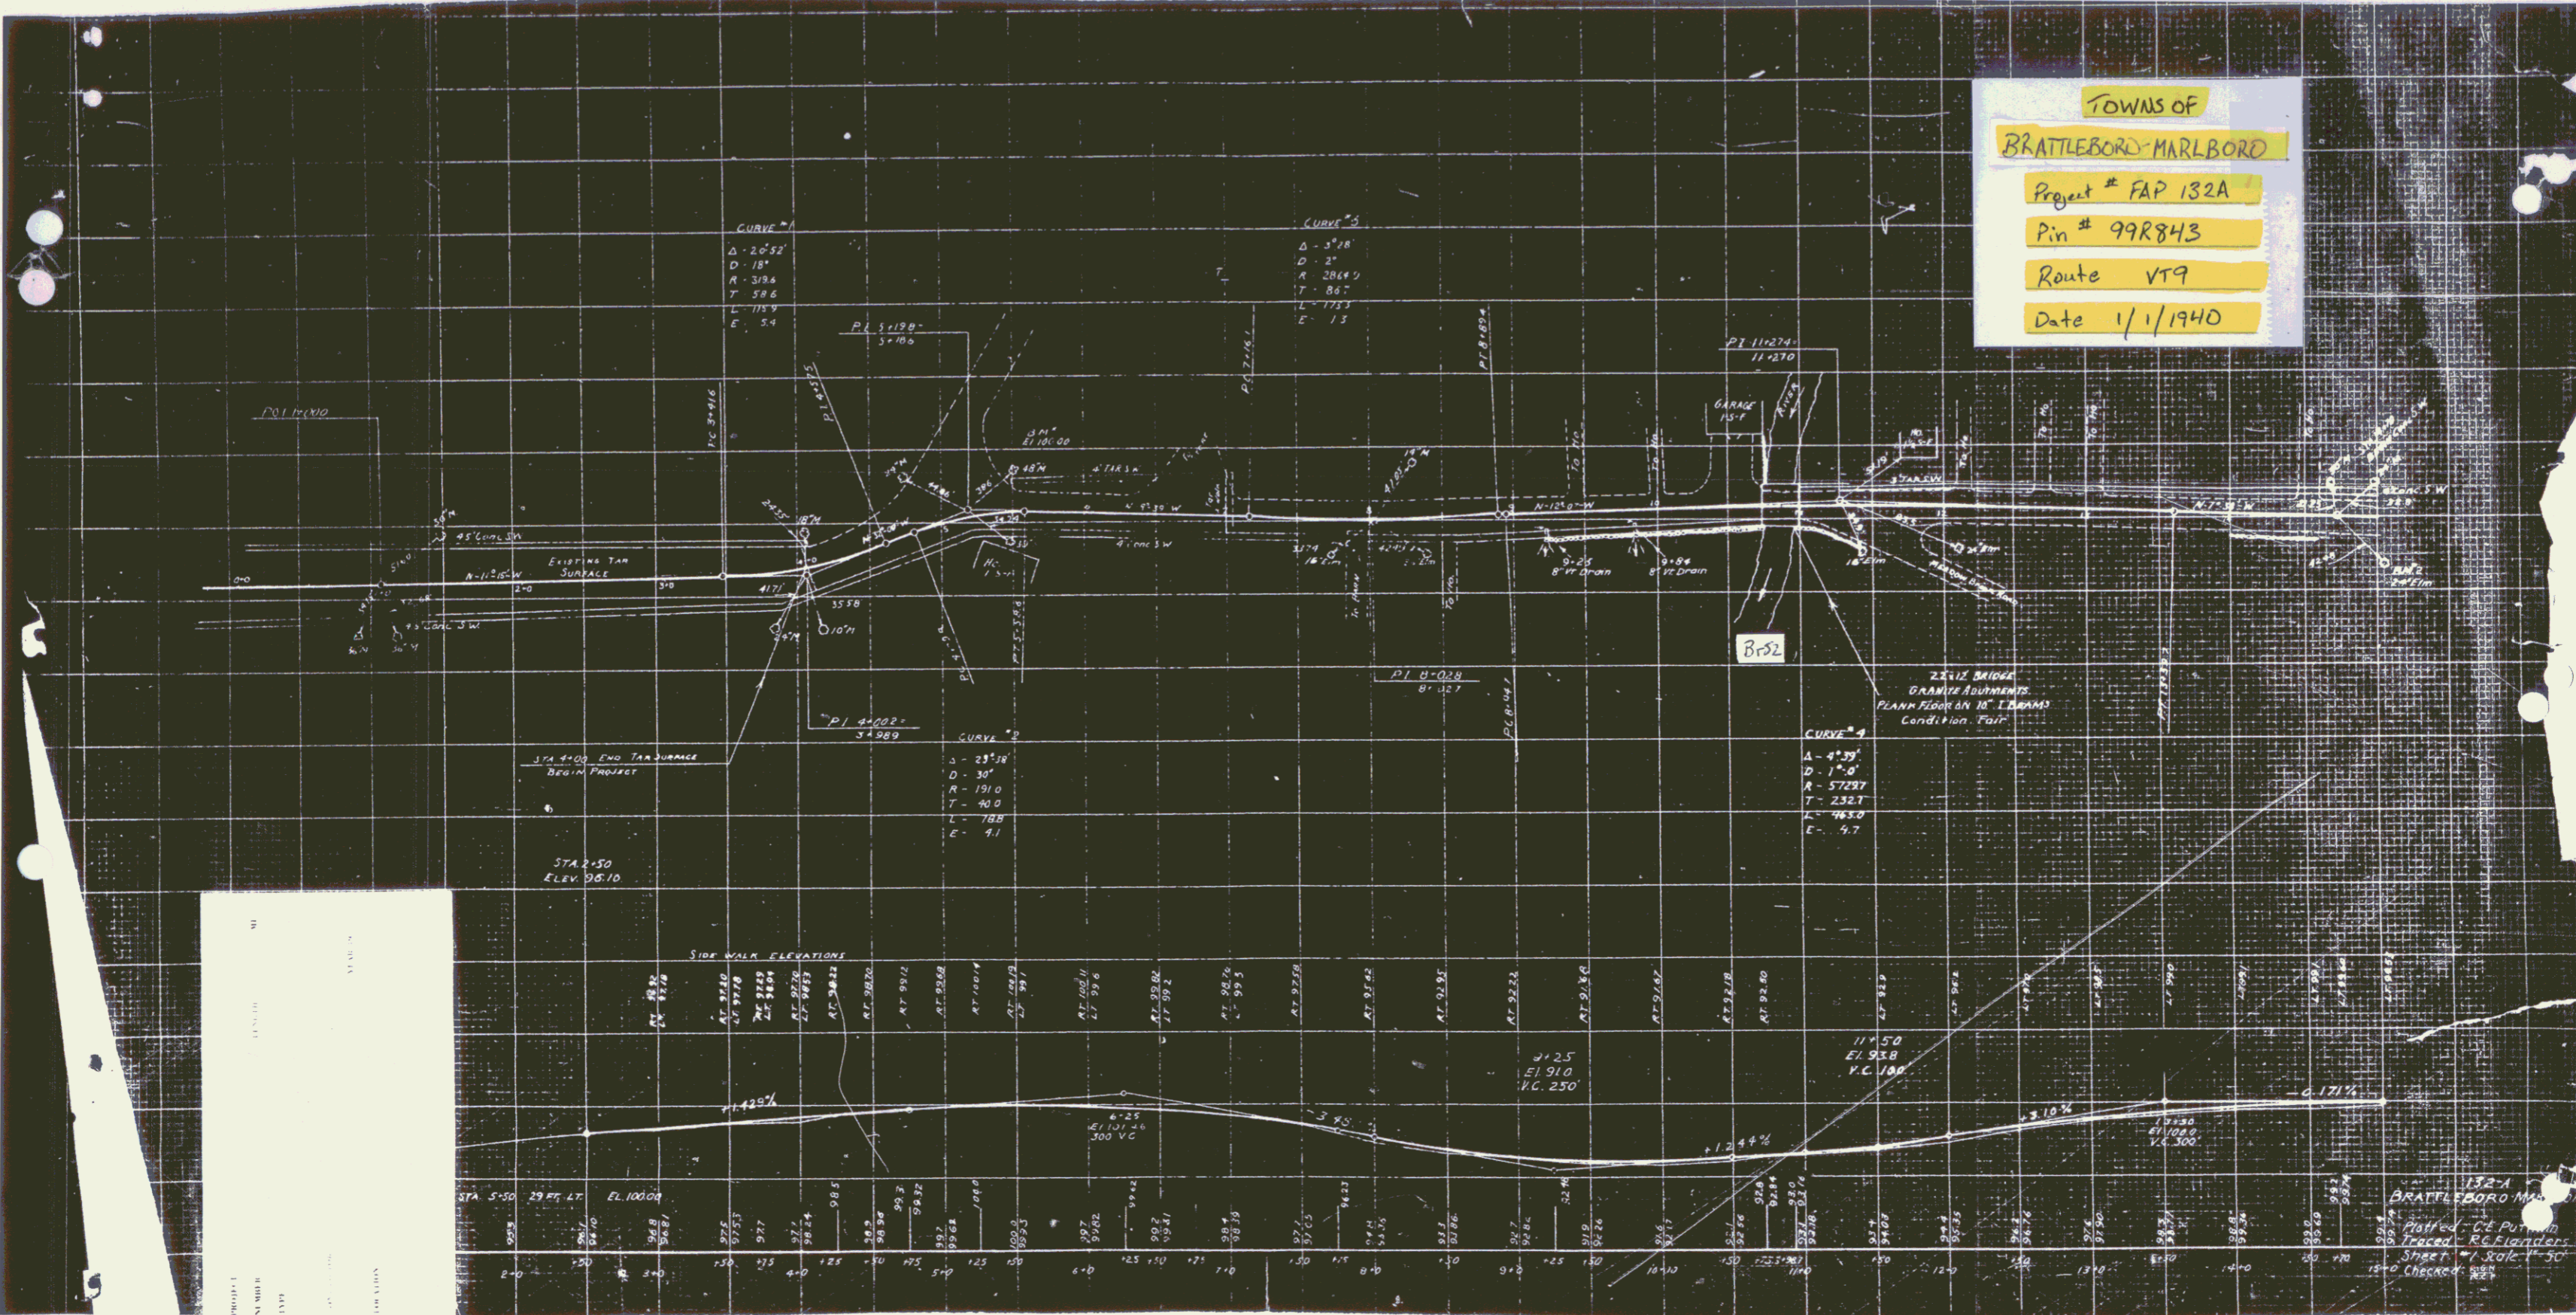

PROJECT NUMBER 132A
 DATE 1/1/1940
 DRAWN BY [illegible]
 CHECKED BY [illegible]

Bennington
 4.763-0.00
 Marlboro
 8.304-6.775

132A
 BRATTLEBORD-MARLBORO
 Project # FAP 132A
 Pin # 99R843
 Route VT9
 Date 1/1/1940
 Checked by [illegible]