


30

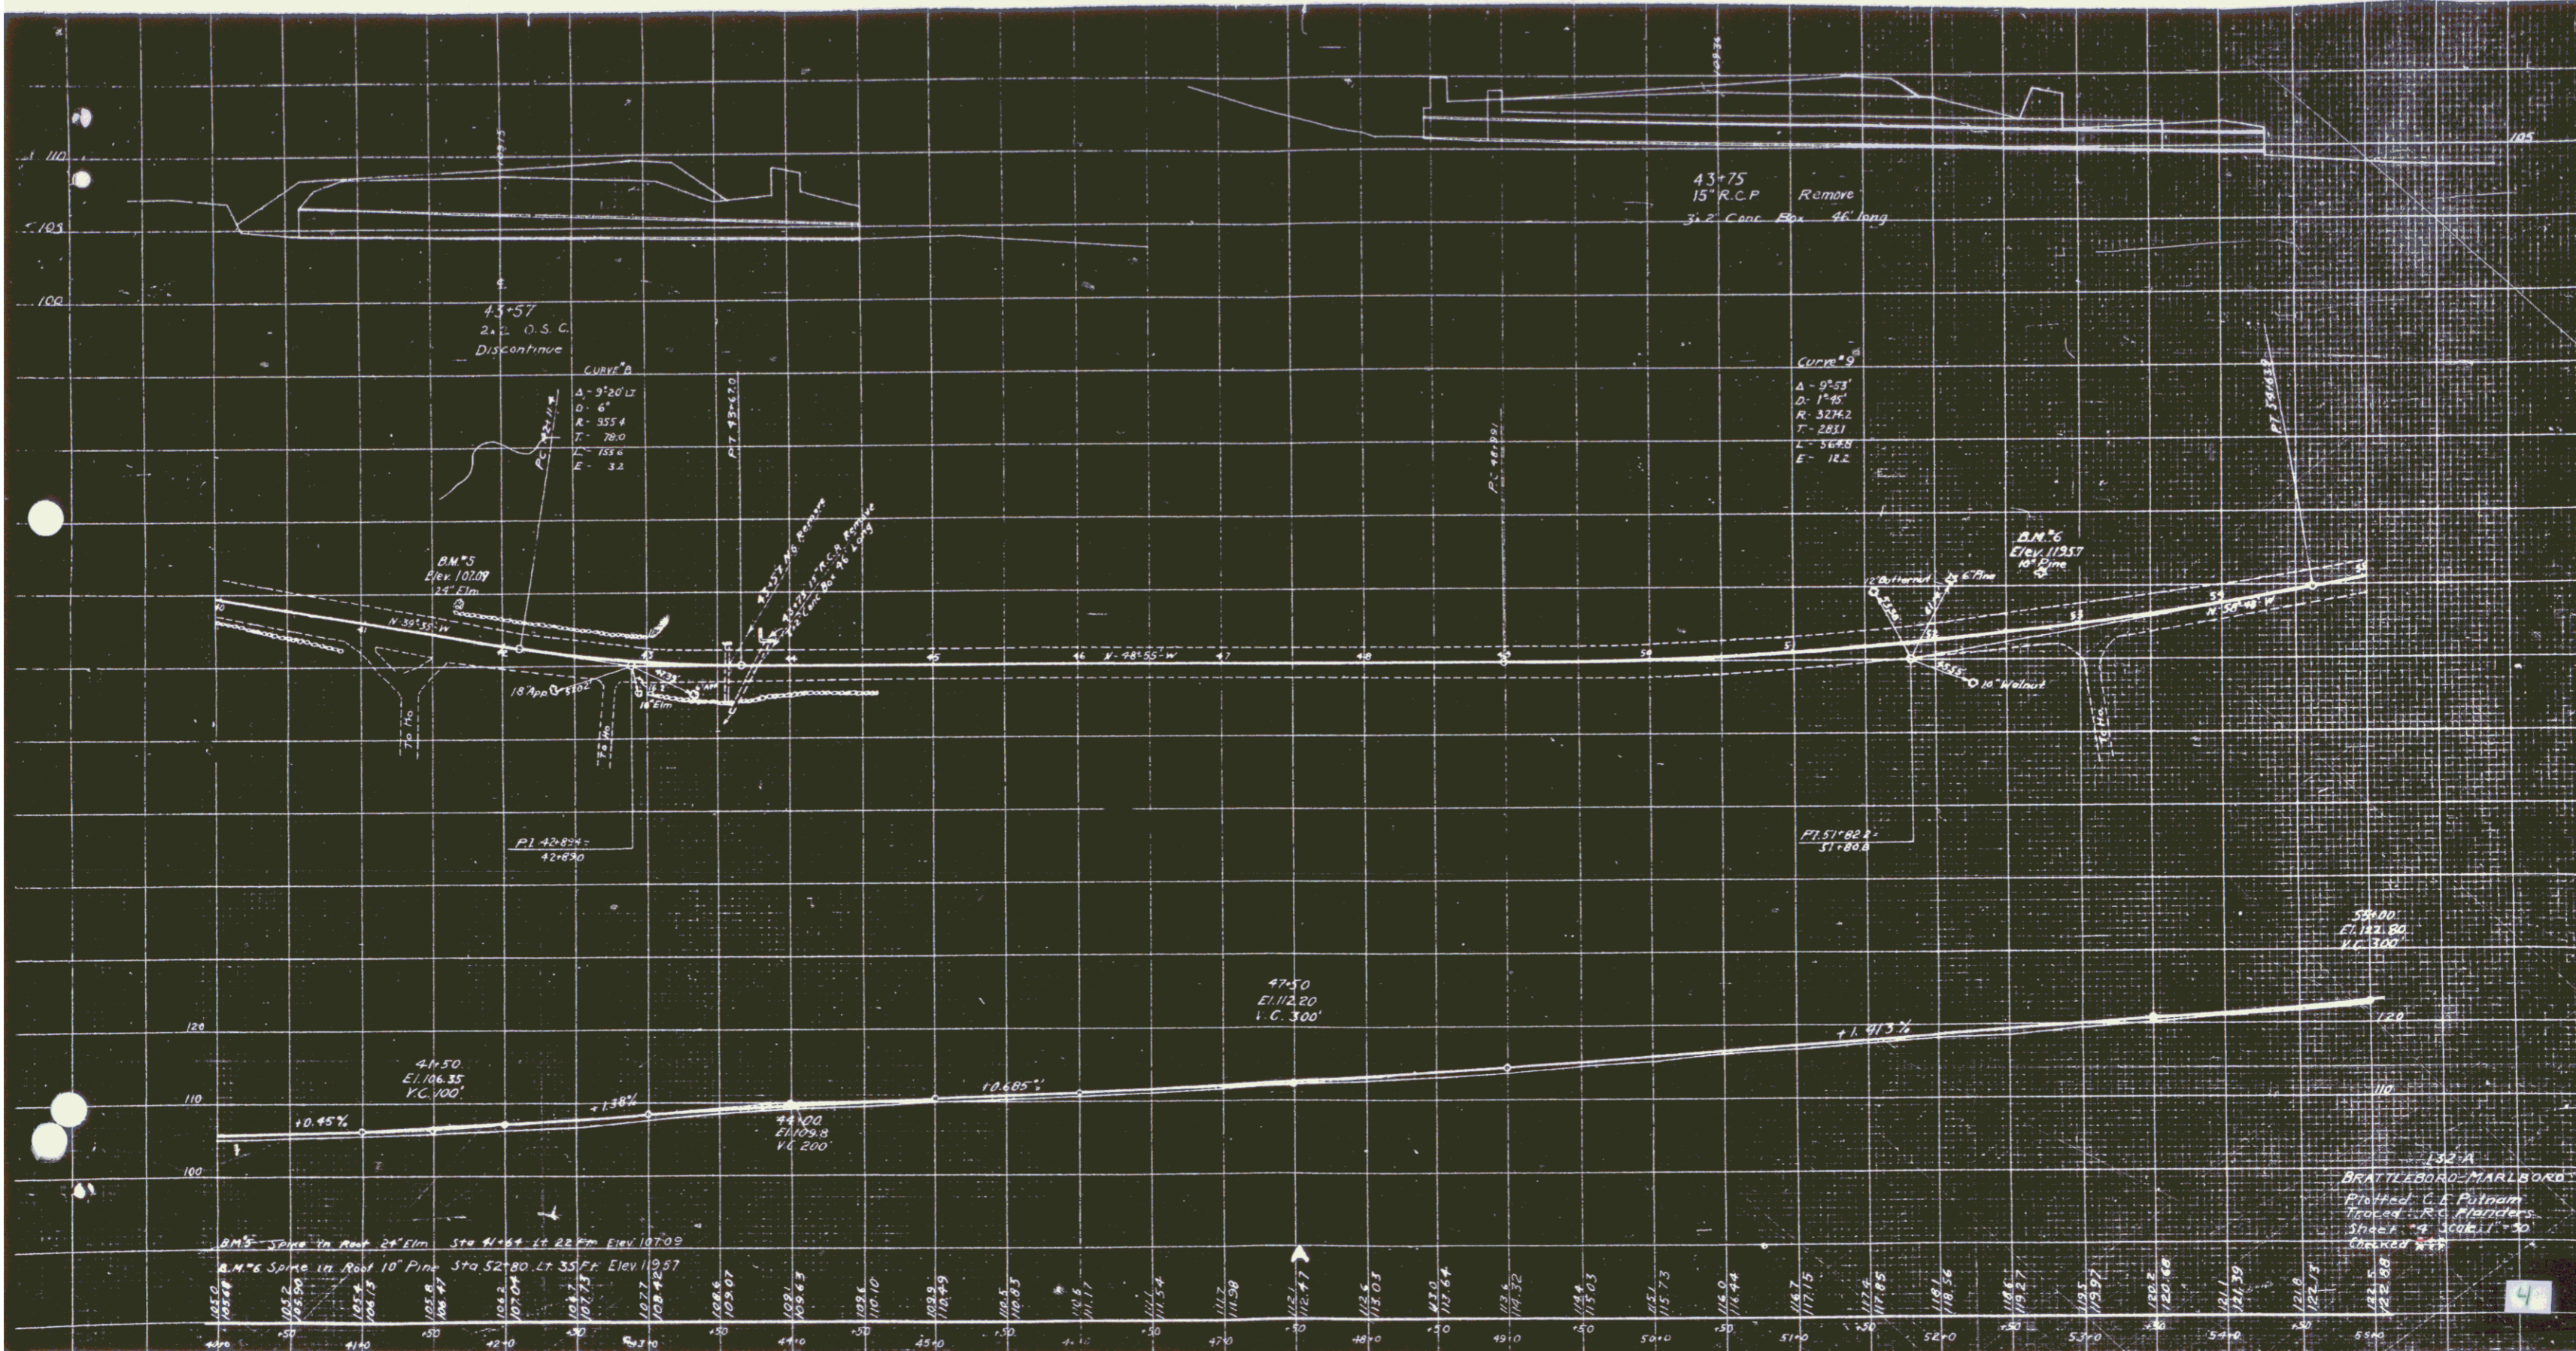

BRATTLEBORO/MARLBORO
 Plotted C. E. Putnam
 Traced R. C. Marders
 Sheet "A" Scale 1" = 30'
 Checked WEP

4