


F-132A
 STA

FF Boyle

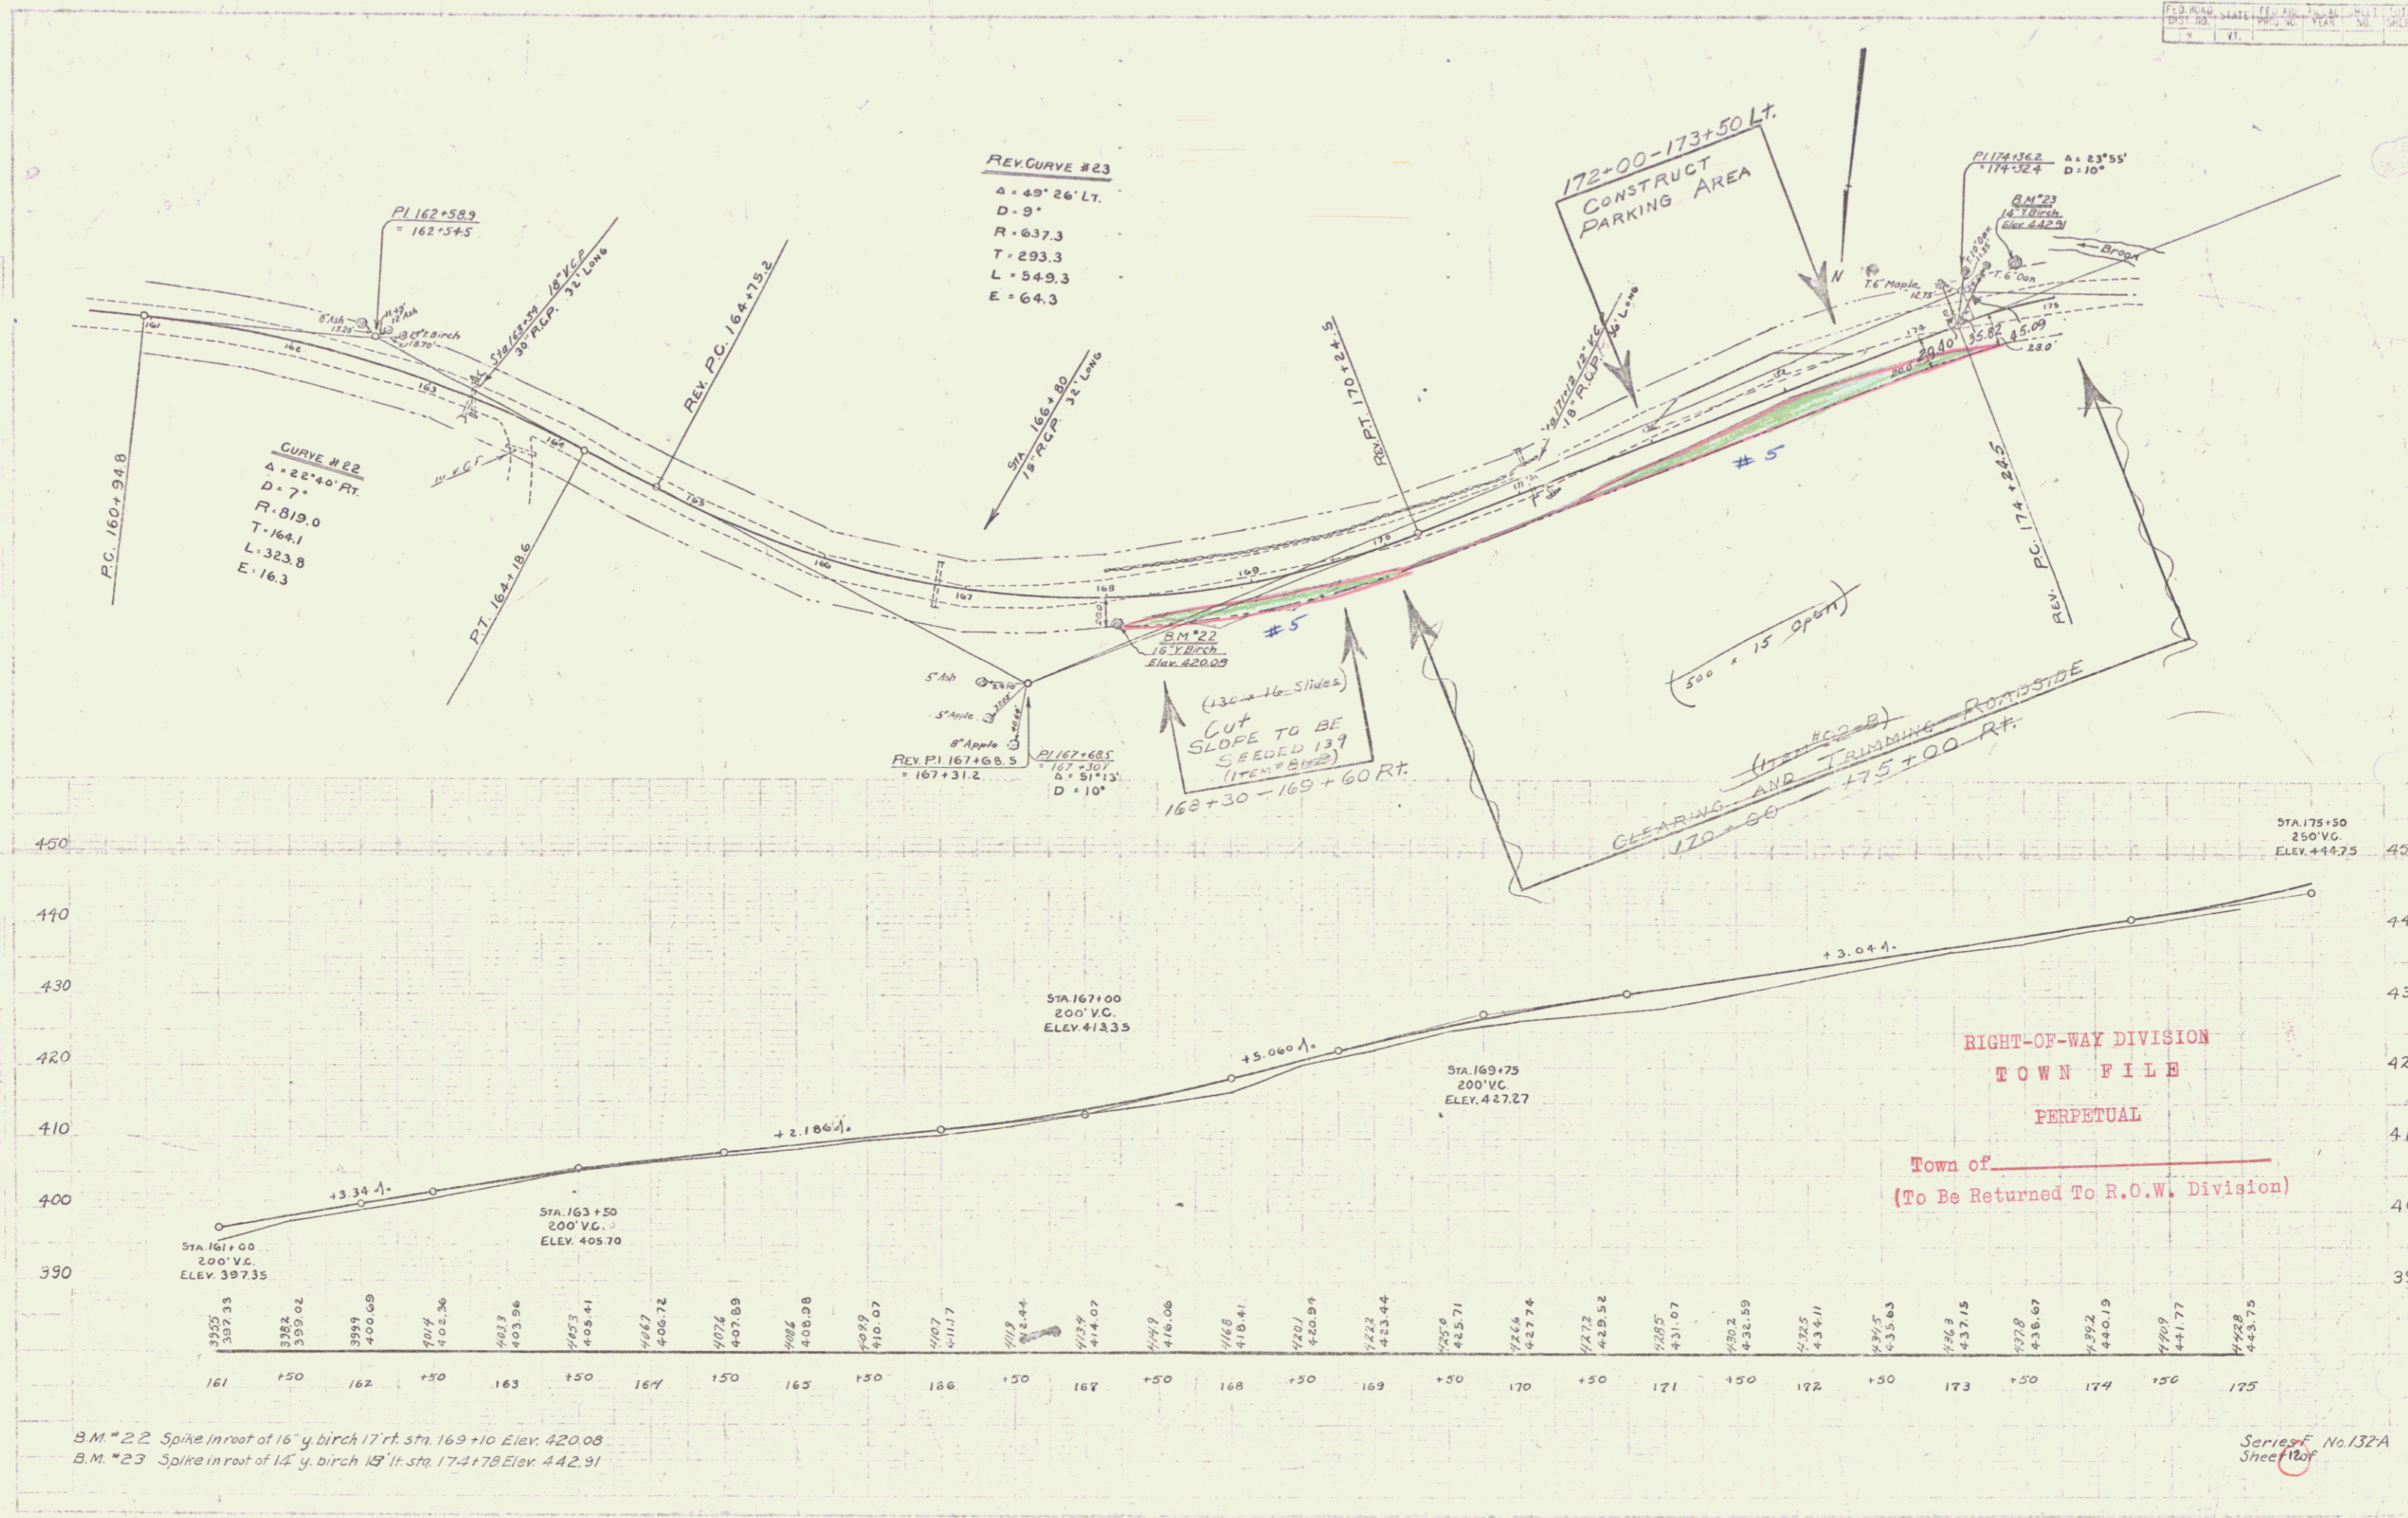

B.M. #22 Spike in root of 16' y. birch 17' ft. sta. 169+10 Elev. 420.08
 B.M. #23 Spike in root of 14' y. birch 19' ft. sta. 174+78 Elev. 442.91

Series F No. 132A
 Sheet 10 of 12