
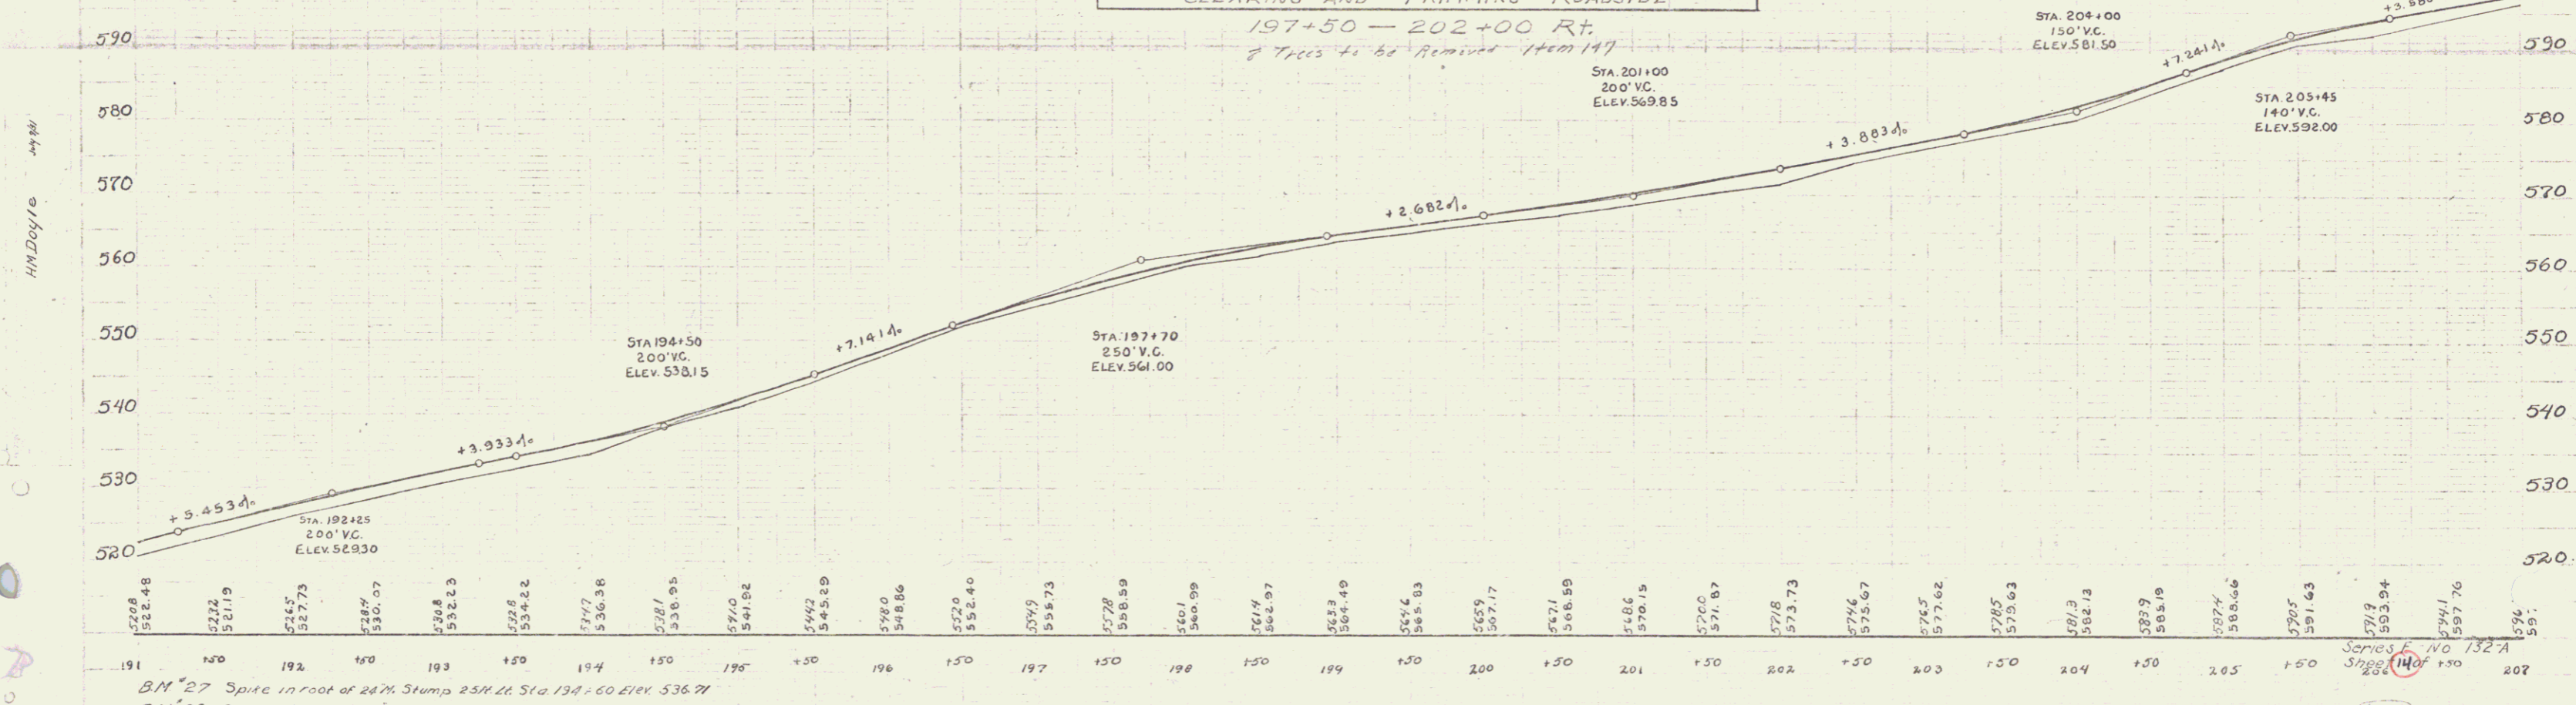


DIST. NO.	STATE	PROJ. NO.	YEAR	SHEET NO.	TOTAL SHEETS
	VT.			149	150

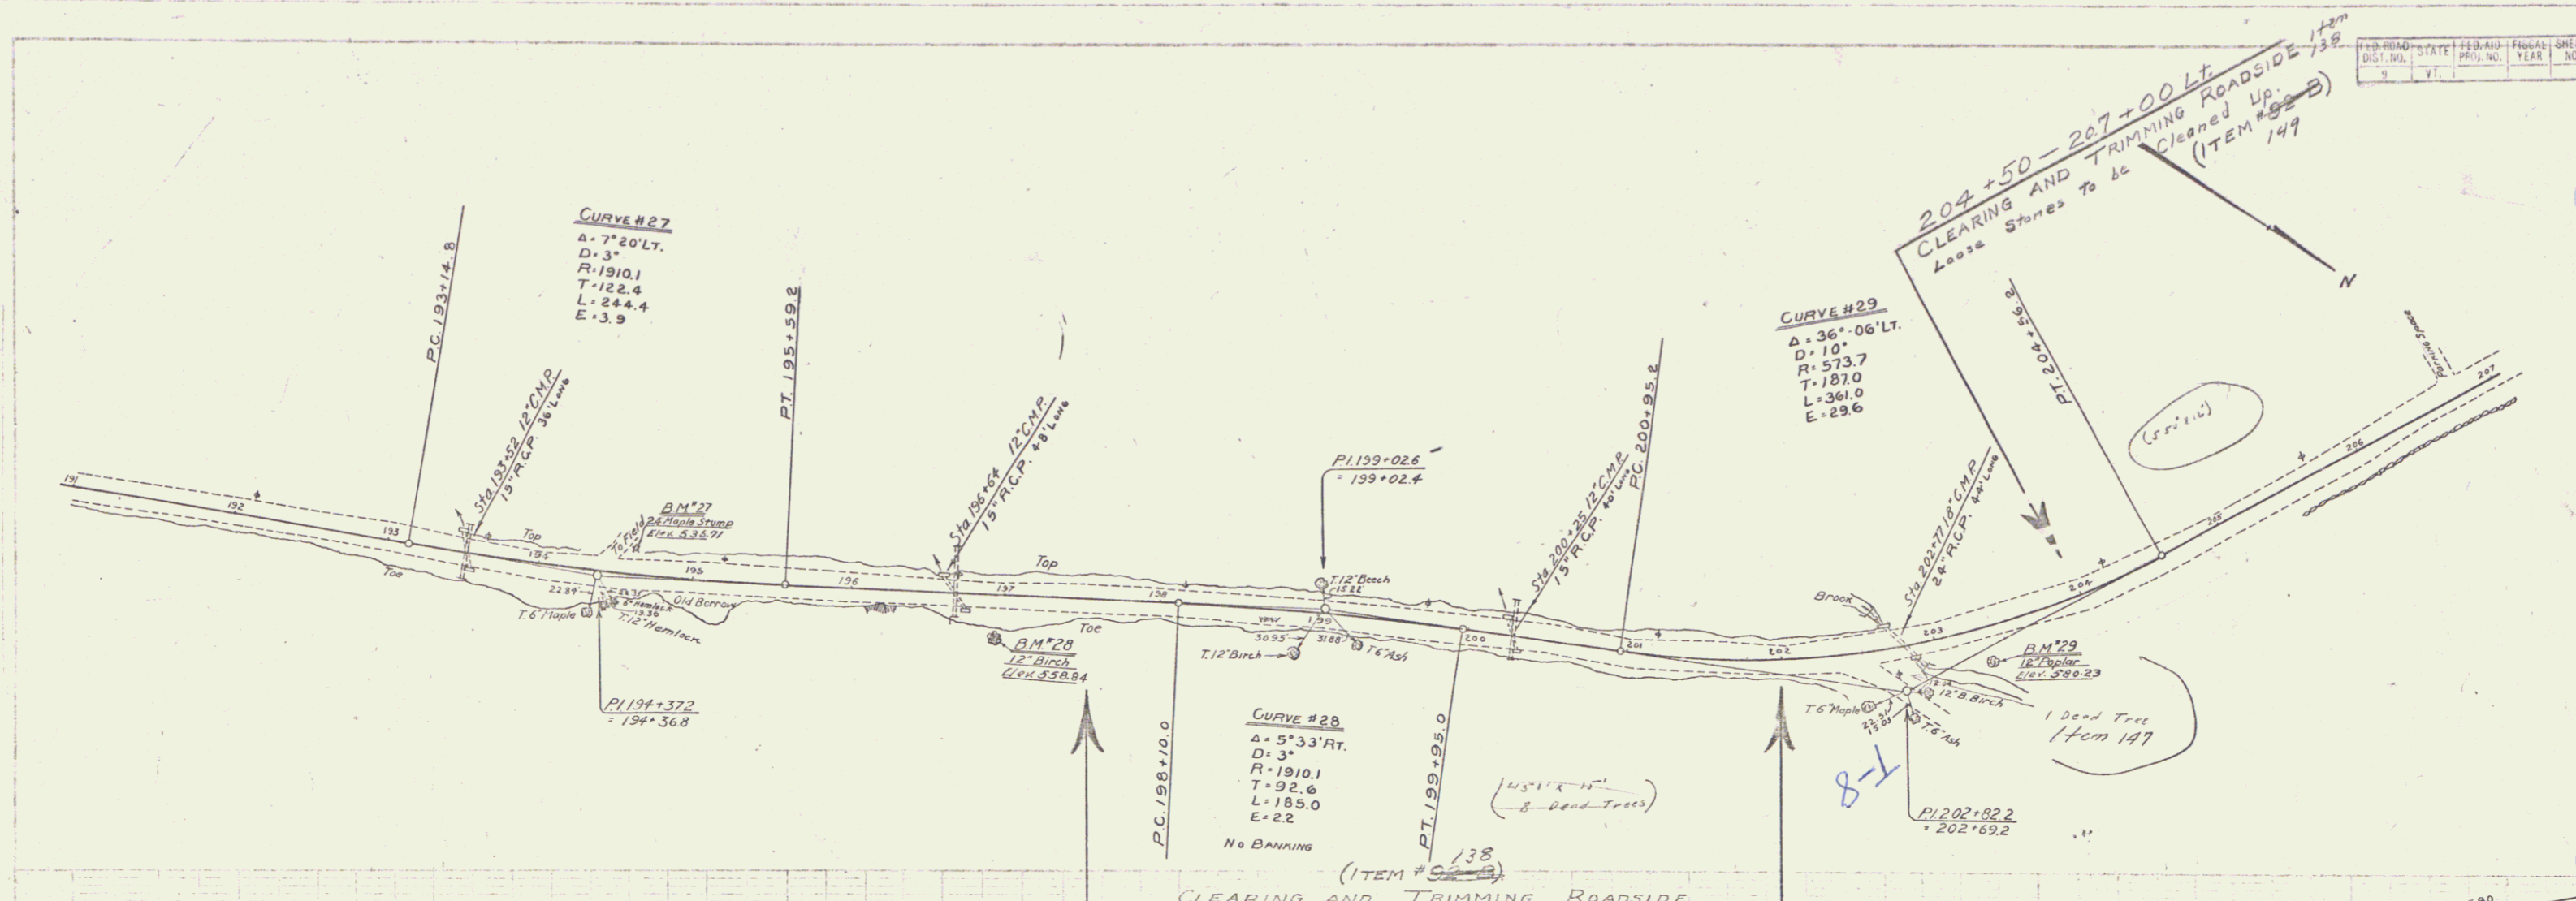

B.M. 27 Spike in root of 24" Stump 25M. Sta. 194+60 Elev. 536.71
 B.M. 28 Spike in root of 12" Birch 25M. Sta. 196+96 Elev. 550.84
 B.M. 29 Spike in root of 12" Pine 22M. Sta. 202+33 Elev. 560.23

Series E No. 132 A
Sheet 149 of 150

3
14