
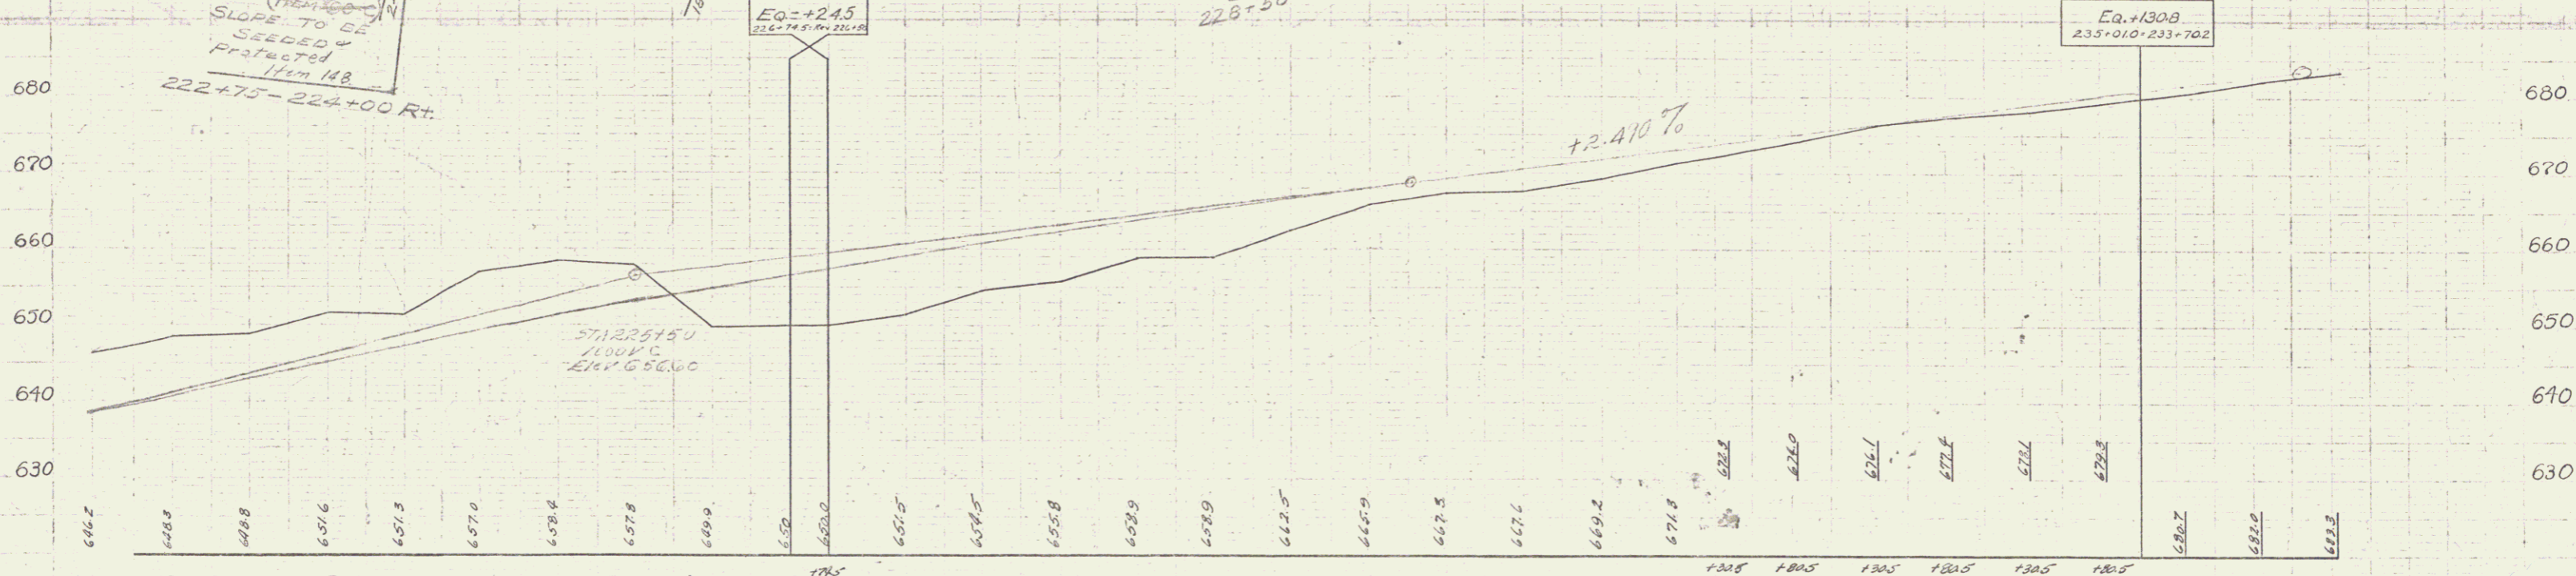


Parcel	Kind of Instrument	Date of Instrument	Grantor	Grantee	Recorded	Remarks
A 7	G.C.D.	10-21-31	J.W. Hamilton	Stef. H.	69 339	1-9-32

NO.	DATE	BY	REVISION
1			

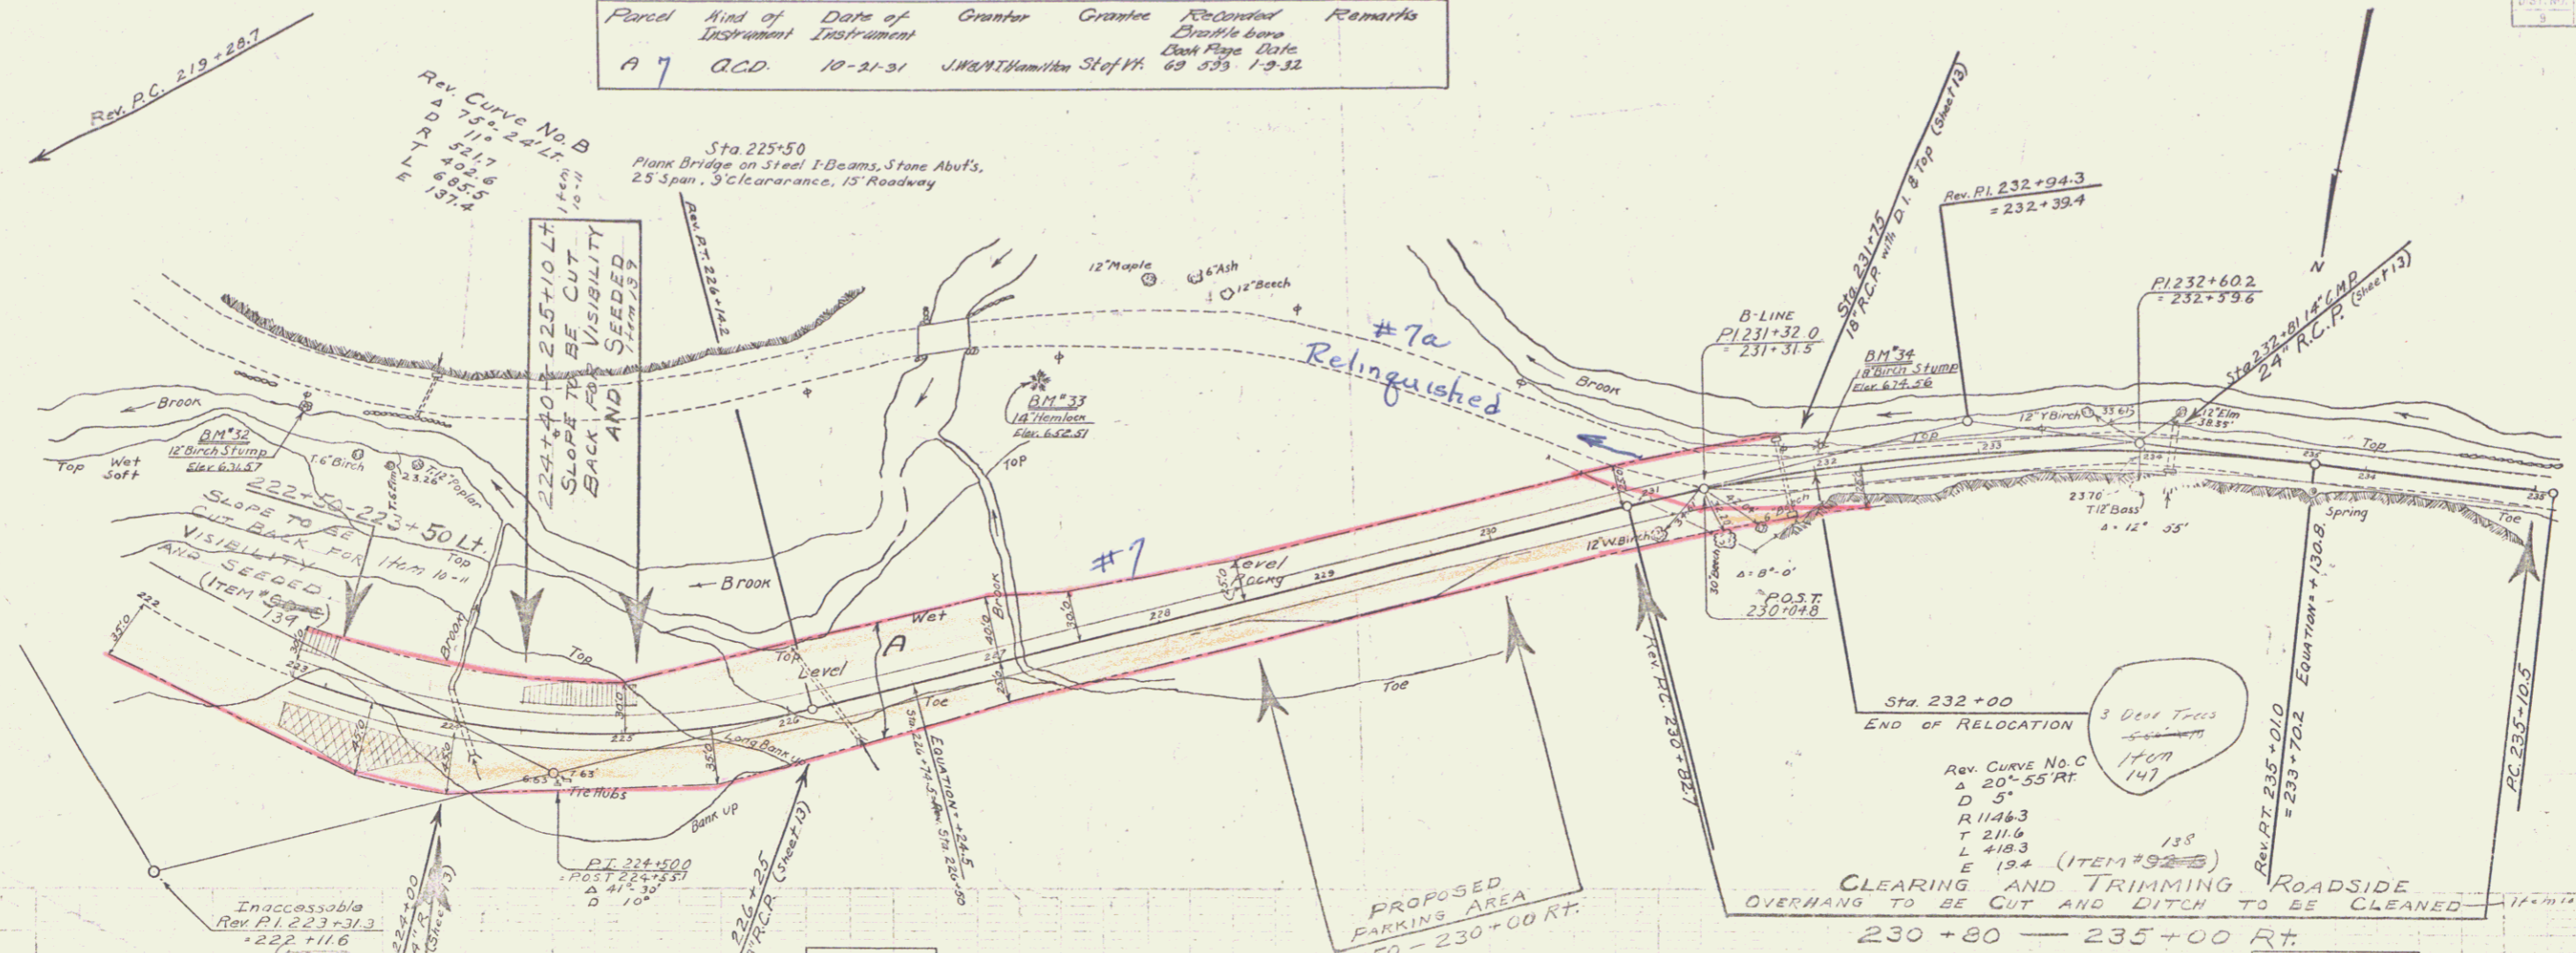

B.M. *32 spike in stump 15" y. birch 23'rt. sta 221+67 Elev. 631.57
 B.M. *33 spike in roof of 14" Hem. 29'rt. sta 225+92 Elev. 662.51
 B.M. *34 spike in 18" y. birch stump 13'rt. sta 230+75 Elev. 674.56

Series F No. 132-A
 Sheet 17

17