
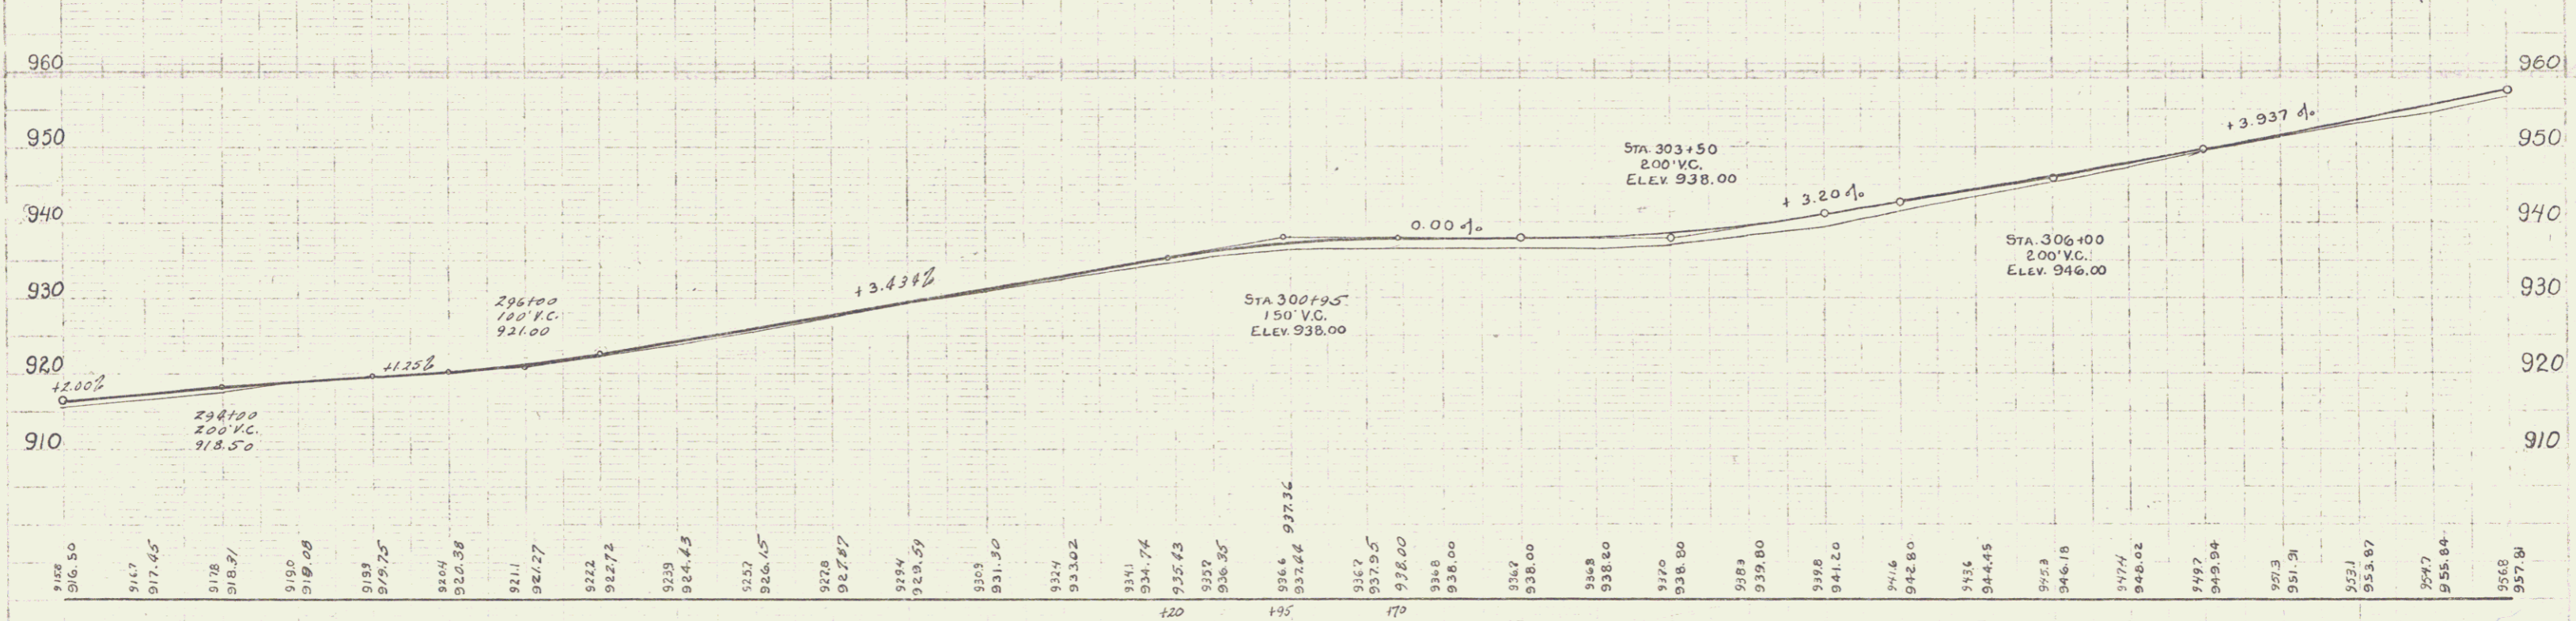


NEW REINFORCED CONG. BOX CULVERTS REQUIRED

STATION	SIZE	CONG. A'	STEEL
300+53	3'x3'	14.7 cu	1027*

DATE	BY	CHKD.	APP.	SCALE
9	VI			

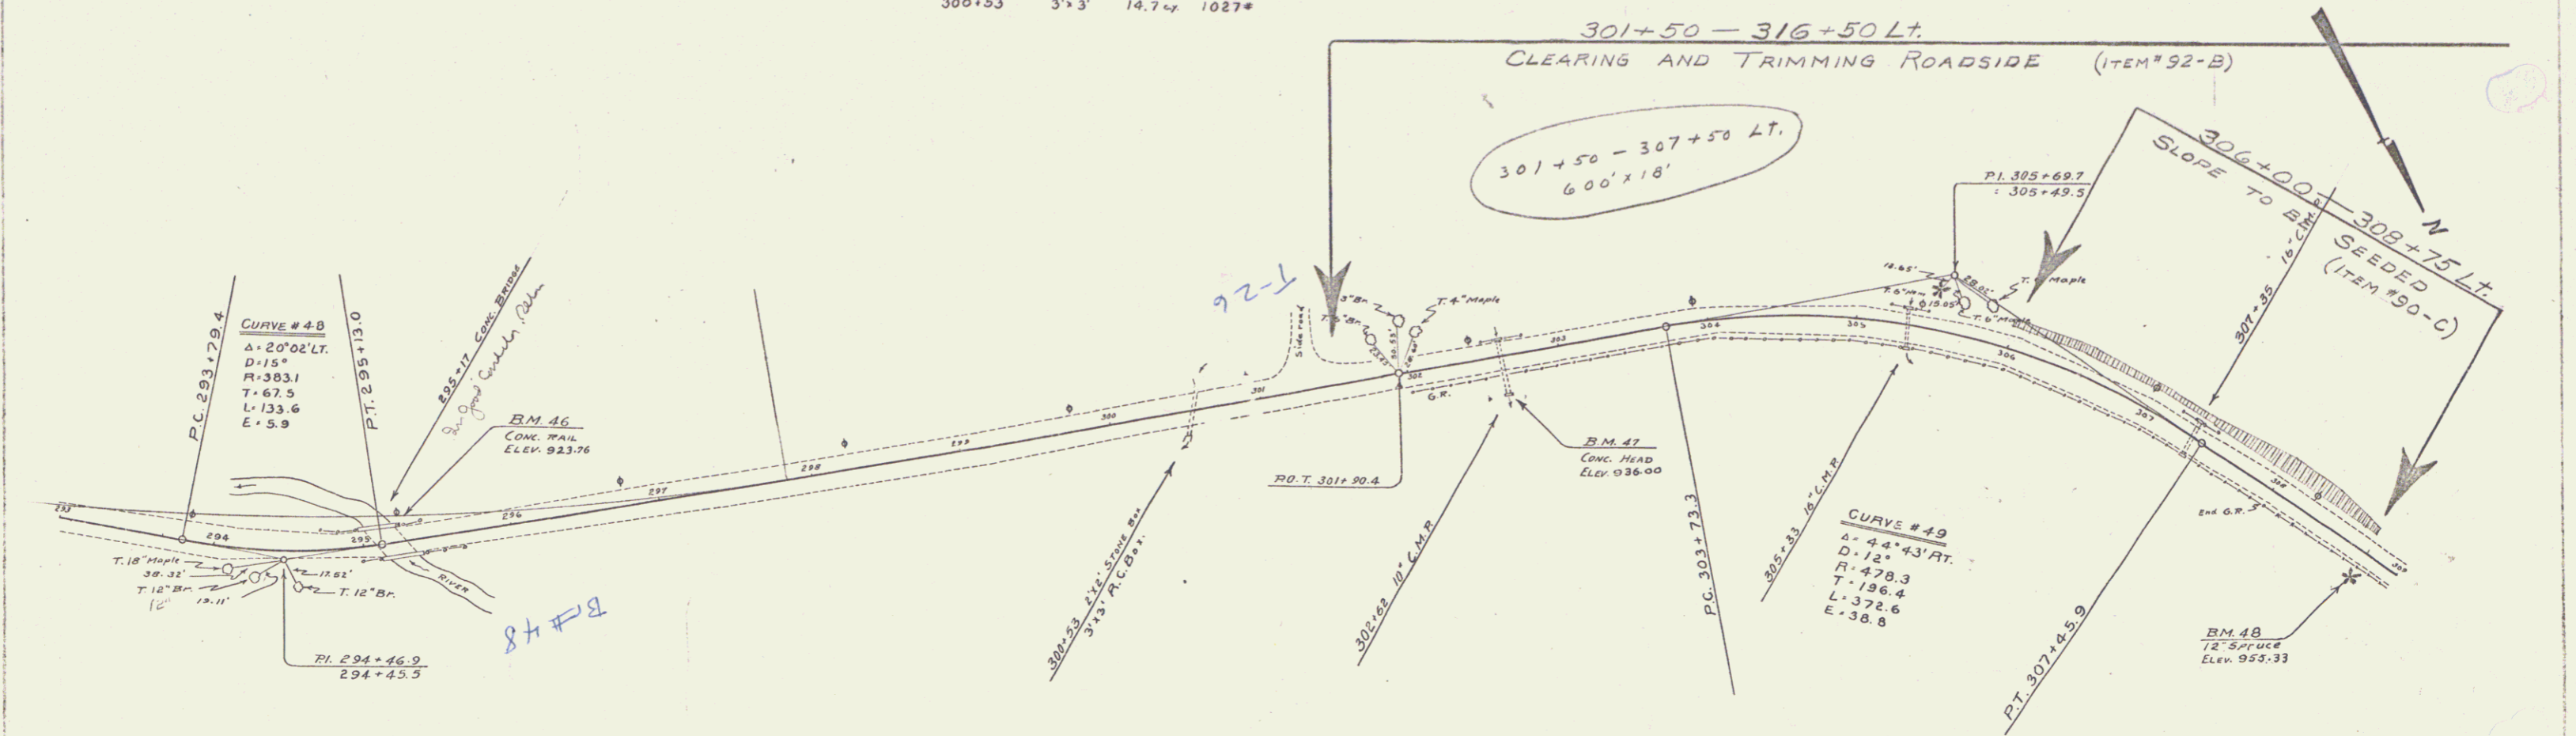

BM 46 Top of S.W. Cor. of Bridge Rail 10 ft. L. Sta 295+24 Elev. 923.76
 BM 47 S.W. Cor. Culv. H.W. 26 ft. H. Sta 302+64 Elev. 936.00
 BM 48 Spike in roof of 12" Spruce 14 ft. H. Sta 308+73 Elev. 955.33

SERIES E No. 132-A
SHEET 22 OF 22

10 22

C. E. PETERSON
 C. E. BENTON
 MAY 26, 1958

H.M. Doyle