
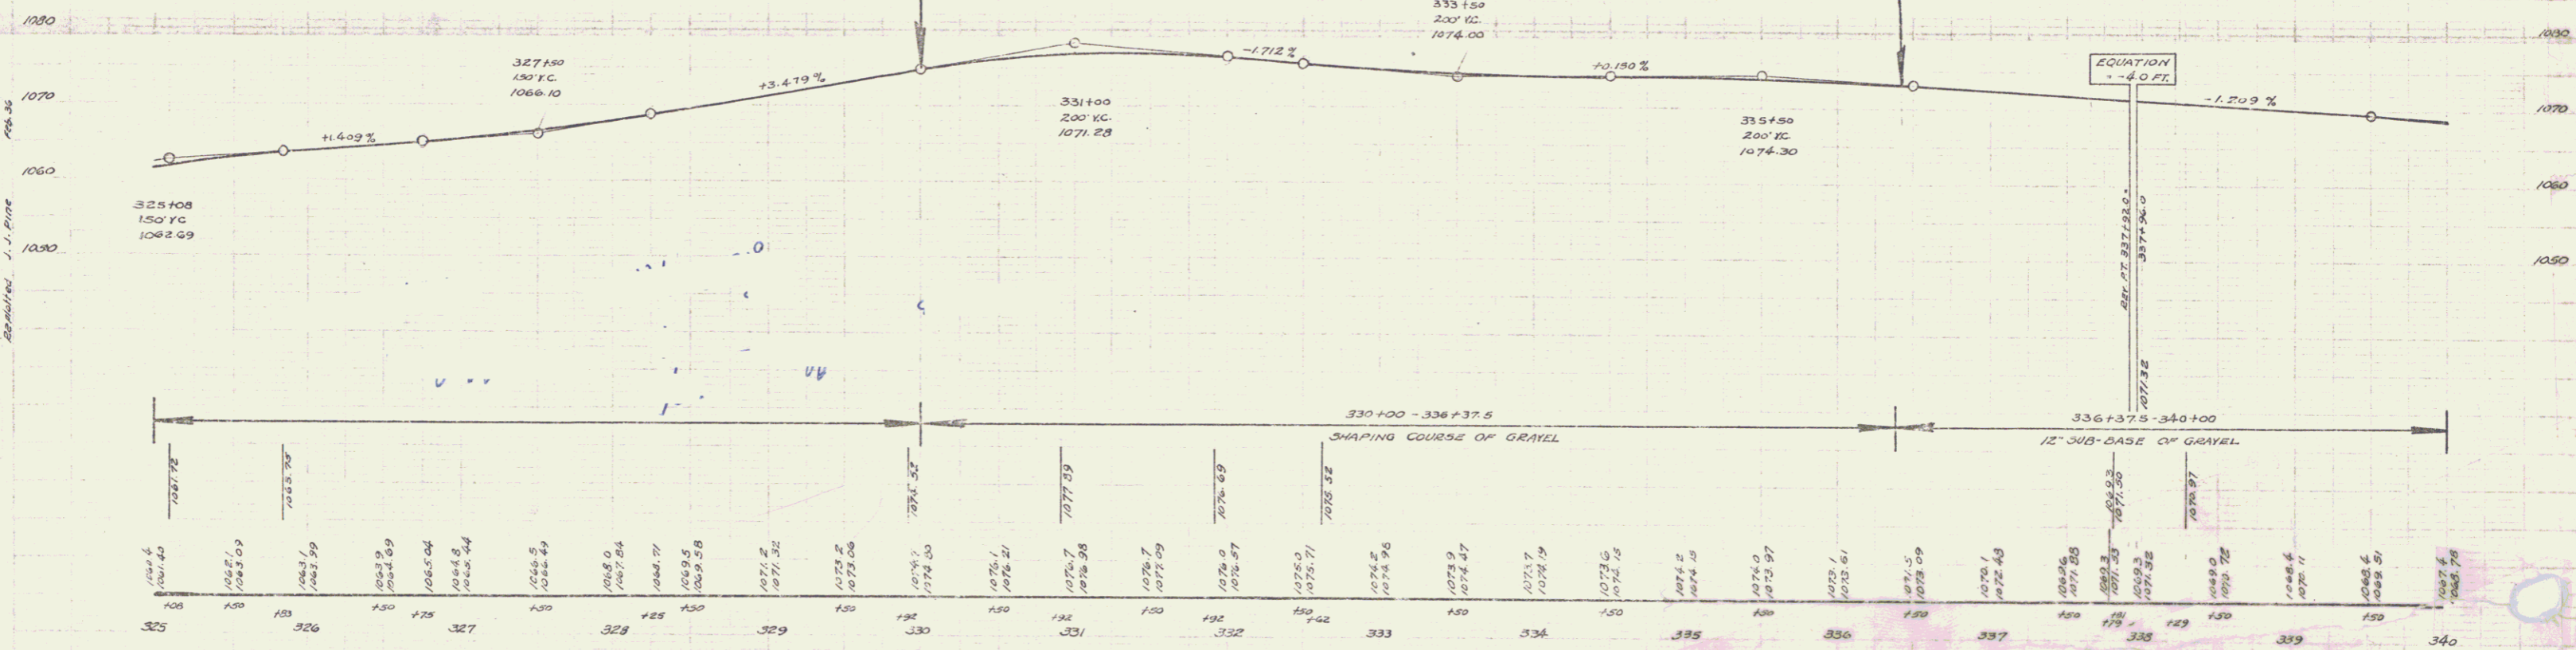


WOOD GUIDE POSTS REQUIRED
 CABLE GUARD RAIL REQUIRED
 NEW BEING CONC. FOR CULVERTS REQUIRED

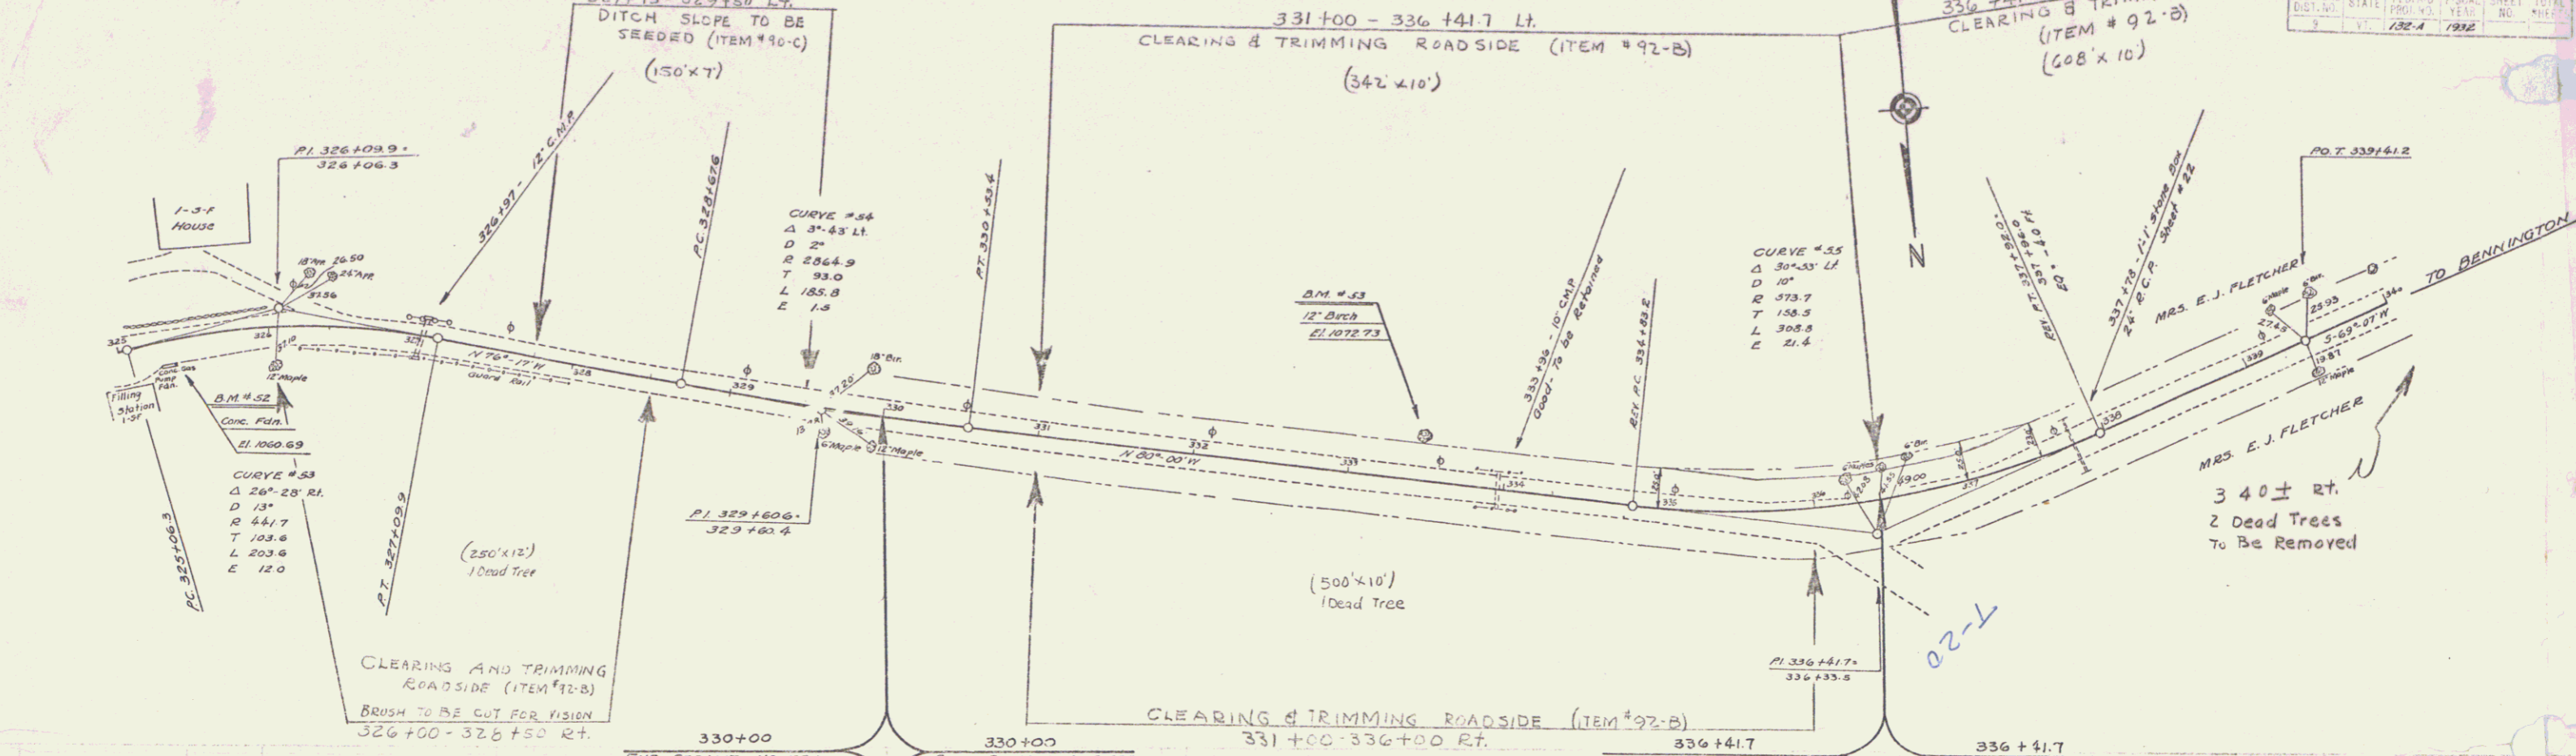

SERIES MAP NO. 132A
 SHEET 24 OF