

INDEX OF SHEETS

SHEET NO. 1-1A	TITLE PAGE
2-3	TYPICAL CROSS-SECTION OF IMPROVEMENT (BITUMINOUS PAVEMENT CONCRETE)
4	QUANTITY SHEET (ITEM)
5	QUANTITY SHEET (DRAINAGE)
6-10	EARTHWORK SHEETS
11-25	PLAN AND PROFILE SHEETS
26	PRELIMINARY INFORMATION SHEET
27	PLAN SCALE 1" = 20'
28	PROFILE AND BORING SHEET
29	SUPERSTRUCTURE SHEET
30	SUPERSTRUCTURE AND END POST DETAILS
31	DETAILS OF ABUTMENT NO. 1 AND NO. 2
32	DETAILS OF PIER NO. 1 AND NO. 2
33	REINFORCING STEEL SHEET
34-45	CHANNEL SECTIONS
46	DETAIL OF 16" METAL PIPE AT STA. 216+55
47-51	CHANNEL SECTIONS AT STA. 216+50
52	BANKING TABLES RS 56-1
53	STANDARD STRUCTURE SHEET RS 56-2 (REINFORCED CONCRETE DROP INLET)
54	STANDARD STRUCTURE SHEET RS 56-3 (BOUNDARY MARKERS)
55	STANDARD STRUCTURE SHEET RS 56-4
56	STANDARD STRUCTURE SHEET RS 56-5 (GRANITE CURB)
57	STANDARD STRUCTURE SHEET RS 56-6 (TYPICAL SLOPE GRADING)
58	STANDARD STRUCTURE SHEET RS 56-11 (THREE CABLE GUARD RAIL WITH STEEL POSTS)
59	STANDARD STRUCTURE SHEET RS 56-12 (BARRICADES, SIGNS AND LIGHTS)
60	STANDARD STRUCTURE SHEET RS 56-14 (PRECAST REINFORCED CONCRETE PIPE DROP INLET)
61	STANDARD STRUCTURE SHEET SB 20-56 (DETAILS FOR W BRIDGES)
62-136	CROSS-SECTIONS

STATE OF VERMONT
DEPARTMENT OF HIGHWAYS



PROPOSED IMPROVEMENT

FEDERAL AID PROJECT

PLAN AND PROFILE OF PROPOSED
STATE HIGHWAY


TOWN OF SPRINGFIELD
COUNTY OF WINDSOR
SPRINGFIELD — GASSETTS ROAD
VERMONT ROUTE 10

Pin# 992851

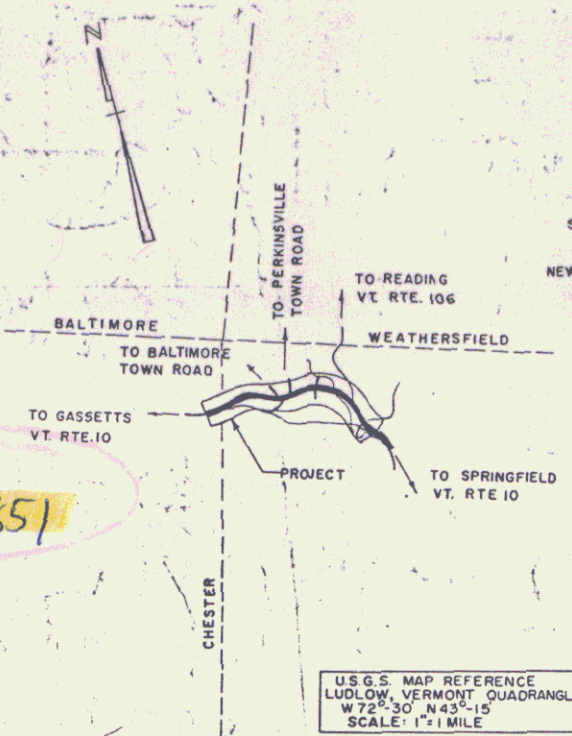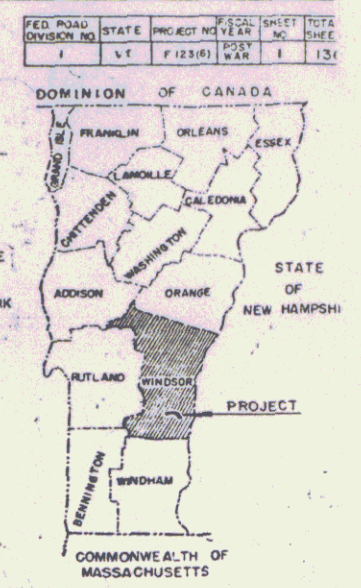

U.S.G.S. MAP REFERENCE
LUDLOW, VERMONT QUADRANGLE
W 72-30 W 43-15
SCALE: 1" = 1 MILE

BEGINNING AT A POINT 1,642 FEET SOUTHERLY OF THE INTERSECTION OF VERMONT ROUTE 10 AND VERMONT ROUTE 106 AND EXTENDING NORTHERLY 10,150.7 FEET
LENGTH OF ROADWAY 9,928.7 FT. = 1.881 MILES
LENGTH OF BRIDGE 222.0 FT. = 0.042 MILES
LENGTH OF PROJECT 10,150.7 FT. = 1.923 MILES

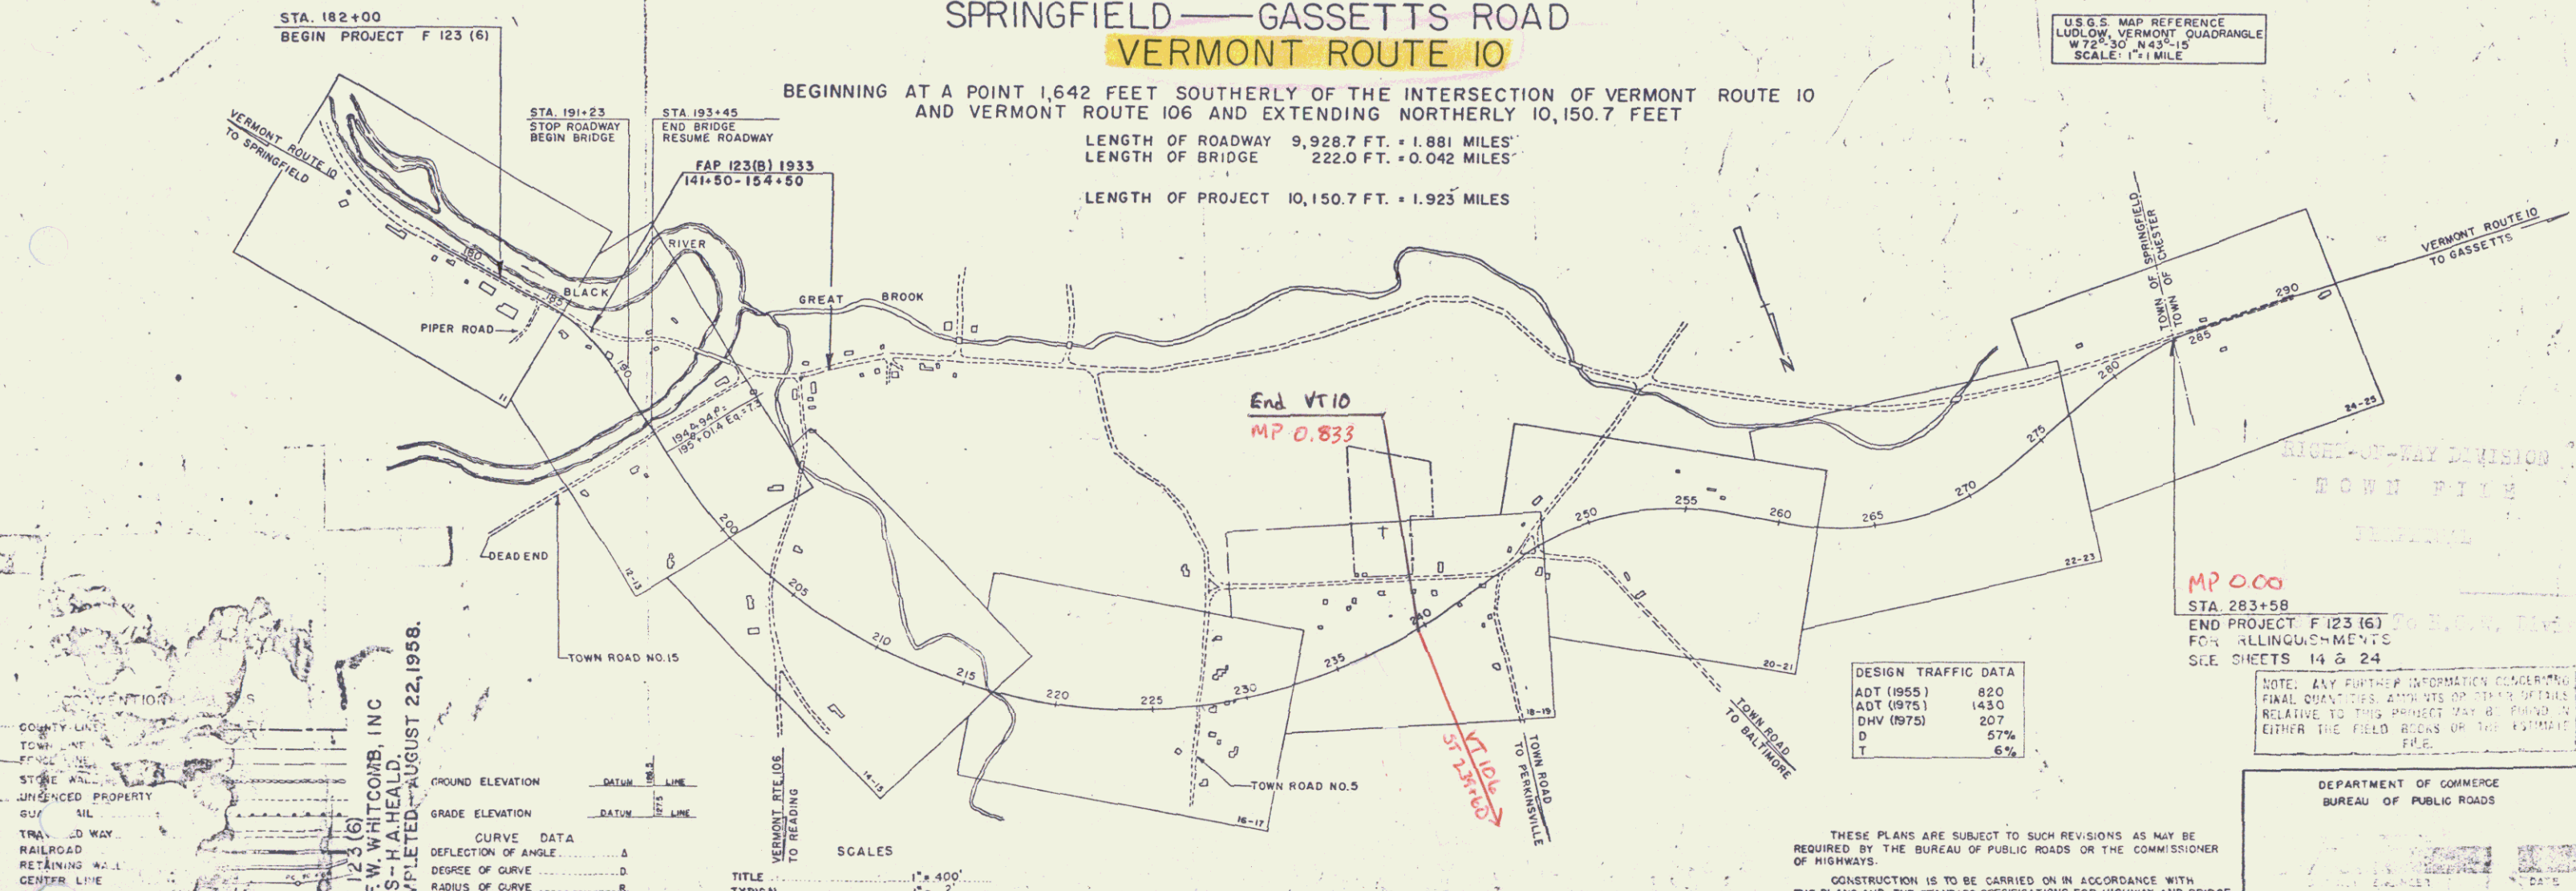

DESIGN TRAFFIC DATA

ADT (1955)	820
ADT (1975)	1430
DHV (1975)	207
D	57%
T	6%

CONTRACTOR: F.W. WHITCOMB, INC.
RECORD PLANS - H.A. HEALD.
CONTRACT COMPLETED - AUGUST 22, 1958.

THE CLARKESON ENGINEERING CO., INC.
CONSULTING ENGINEERS
BOSTON MASSACHUSETTS

APPROVED: *E.C. Carter* DISTRICT ENGINEER DATE FEB. 4, 1957
APPROVED: *A.S. Bishop* BRIDGE ENGINEER DATE FEB. 4, 1957
APPROVED: *J.D. Chase* DISTRICT ENGINEER DATE FEB. 1, 1957
APPROVED: *H.E. August* HIGHWAY ENGINEER DATE FEB. 5, 1957

DEPARTMENT OF COMMERCE
BUREAU OF PUBLIC ROADS

APPROVED: _____ DATE _____
DIVISION ENGINEER

PROJECT: F 123 (6) NO. 123 (6)
SHEET 1 OF 136 SHEETS