


Construct Drive Conn.
2+30 Lt.

Three Cable Guard Rail
w/ Steel Posts, from 5+1
2+00 - 3+50 Rt.
Vt. 10A - 42+65 Lt. - 3+50 Lt.

Removal & Disposal of
Present Guard Rail
2+00 - 3+50 Rt.

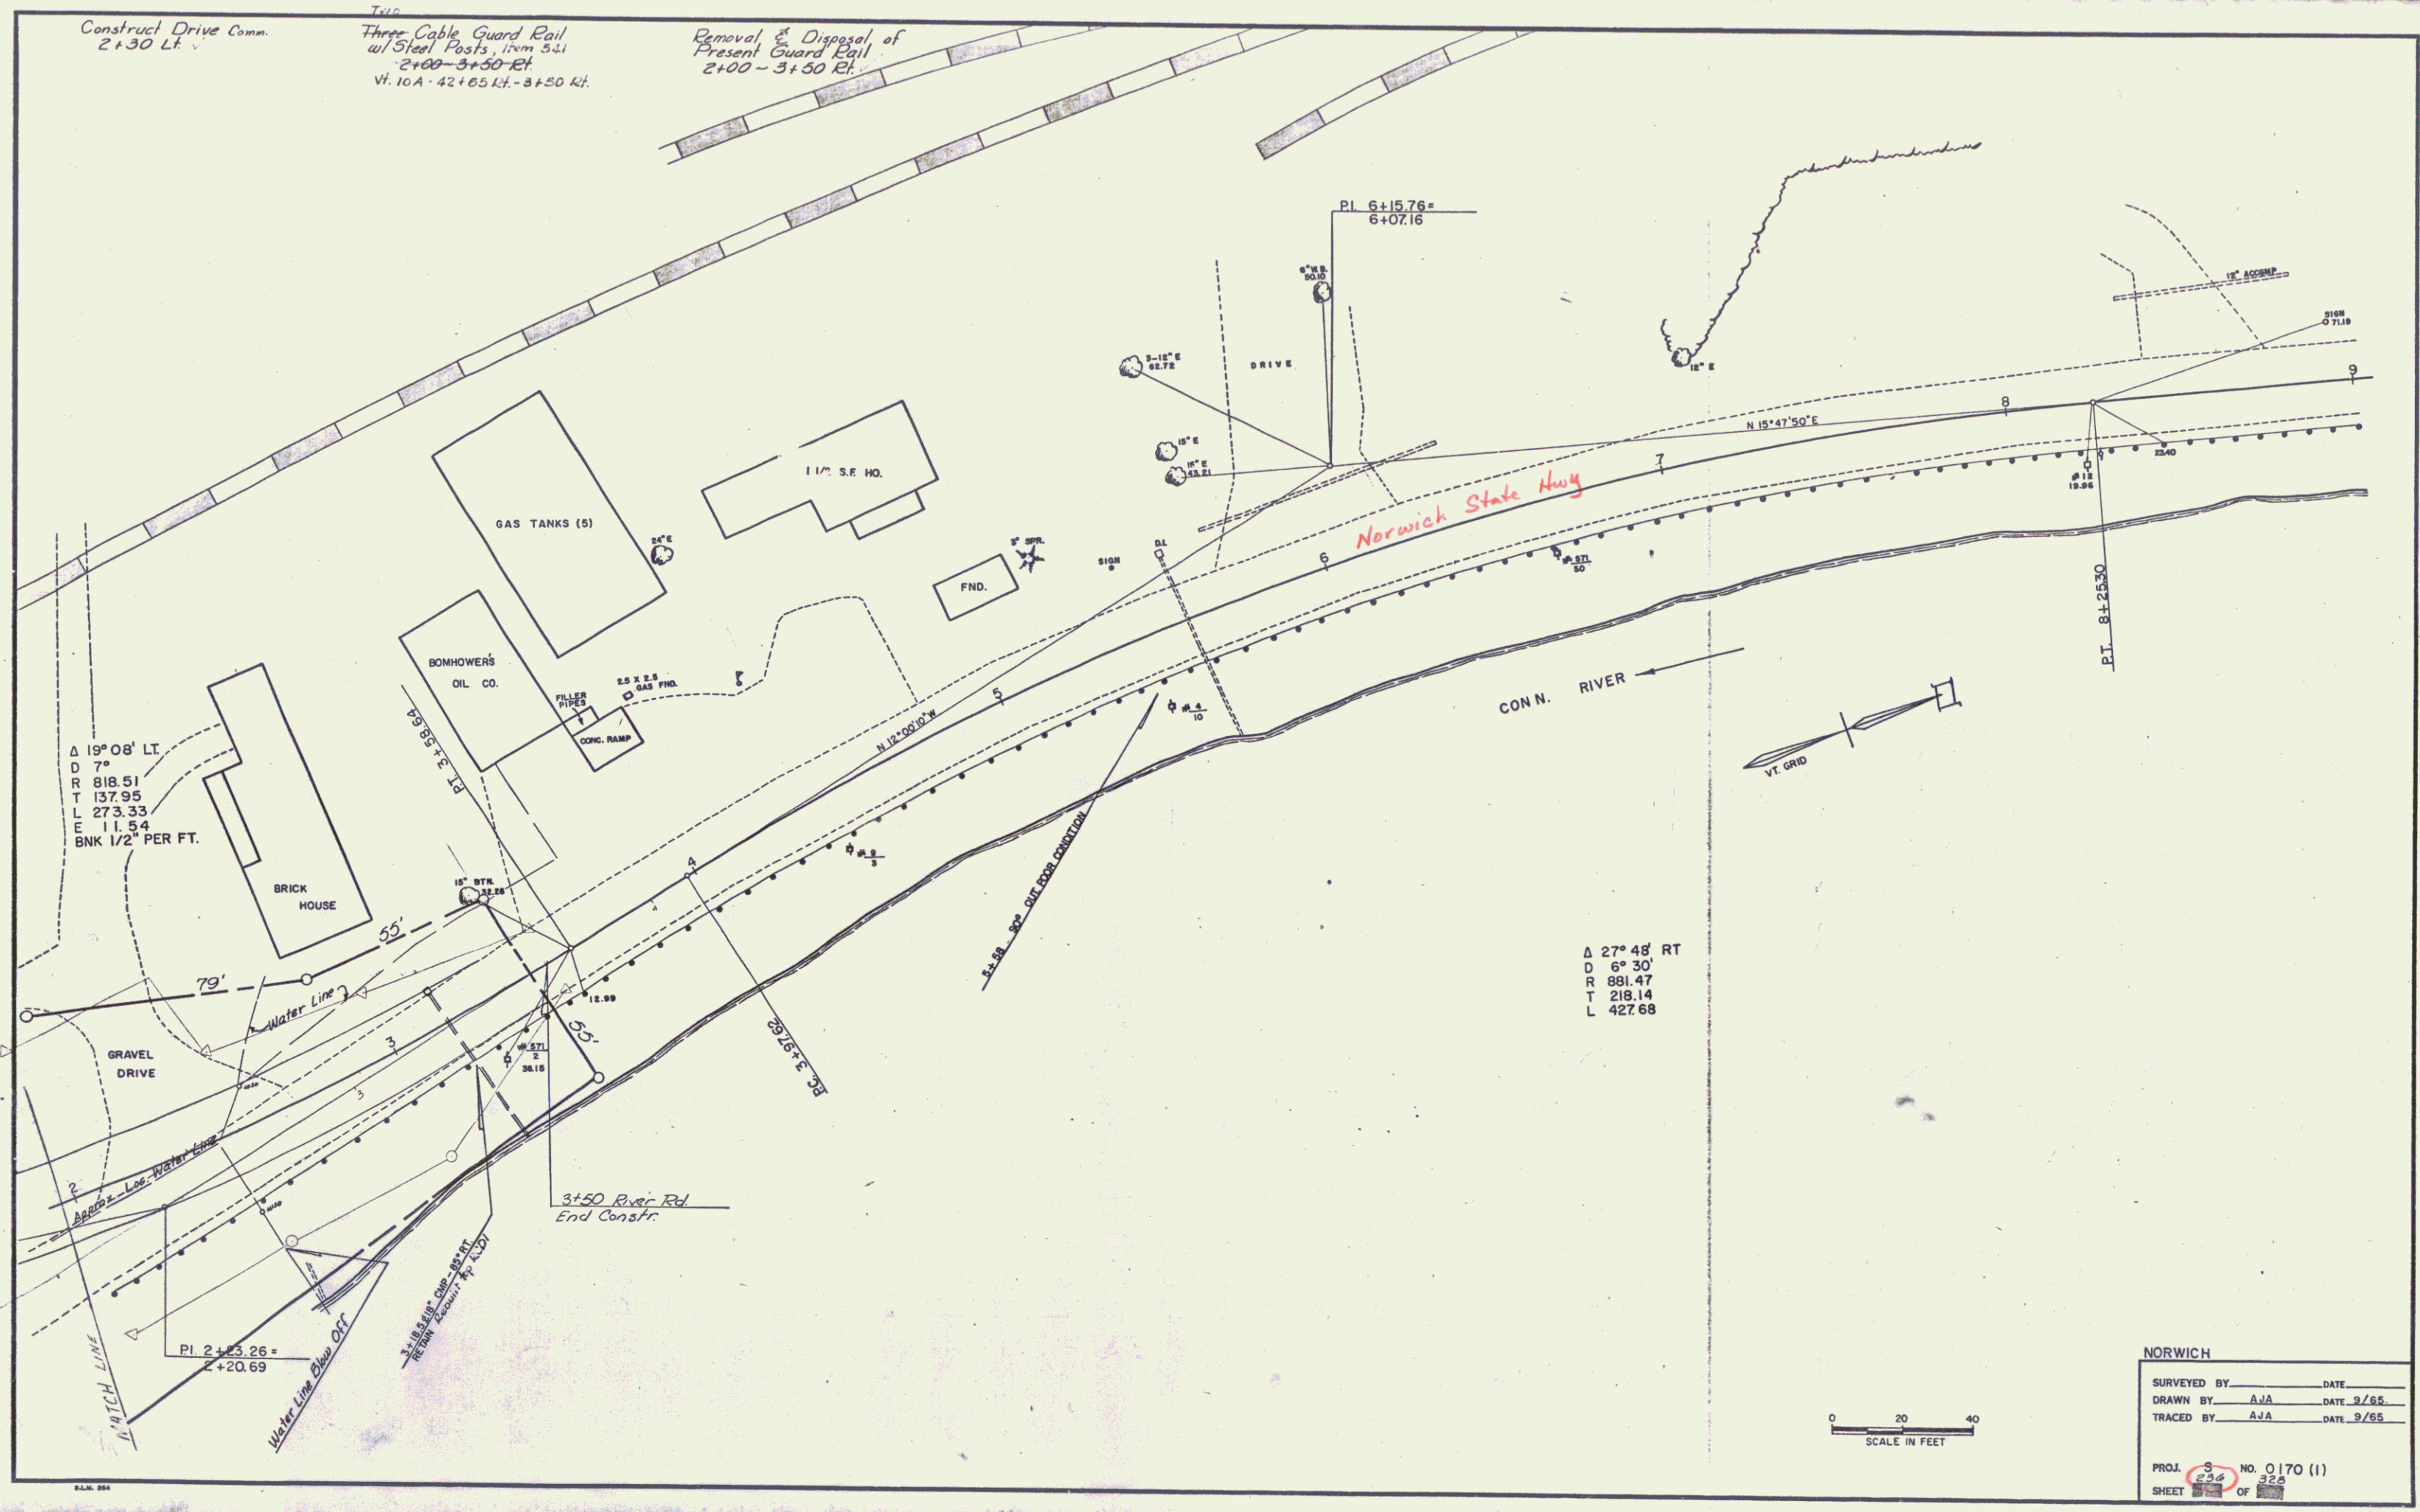

0 20 40
SCALE IN FEET

NORWICH

SURVEYED BY	DATE
DRAWN BY AJA	DATE 3/85
TRACED BY AJA	DATE 9/85

PROJ. 3 NO. 0170 (1)
SHEET 236 OF 320