



Reference only

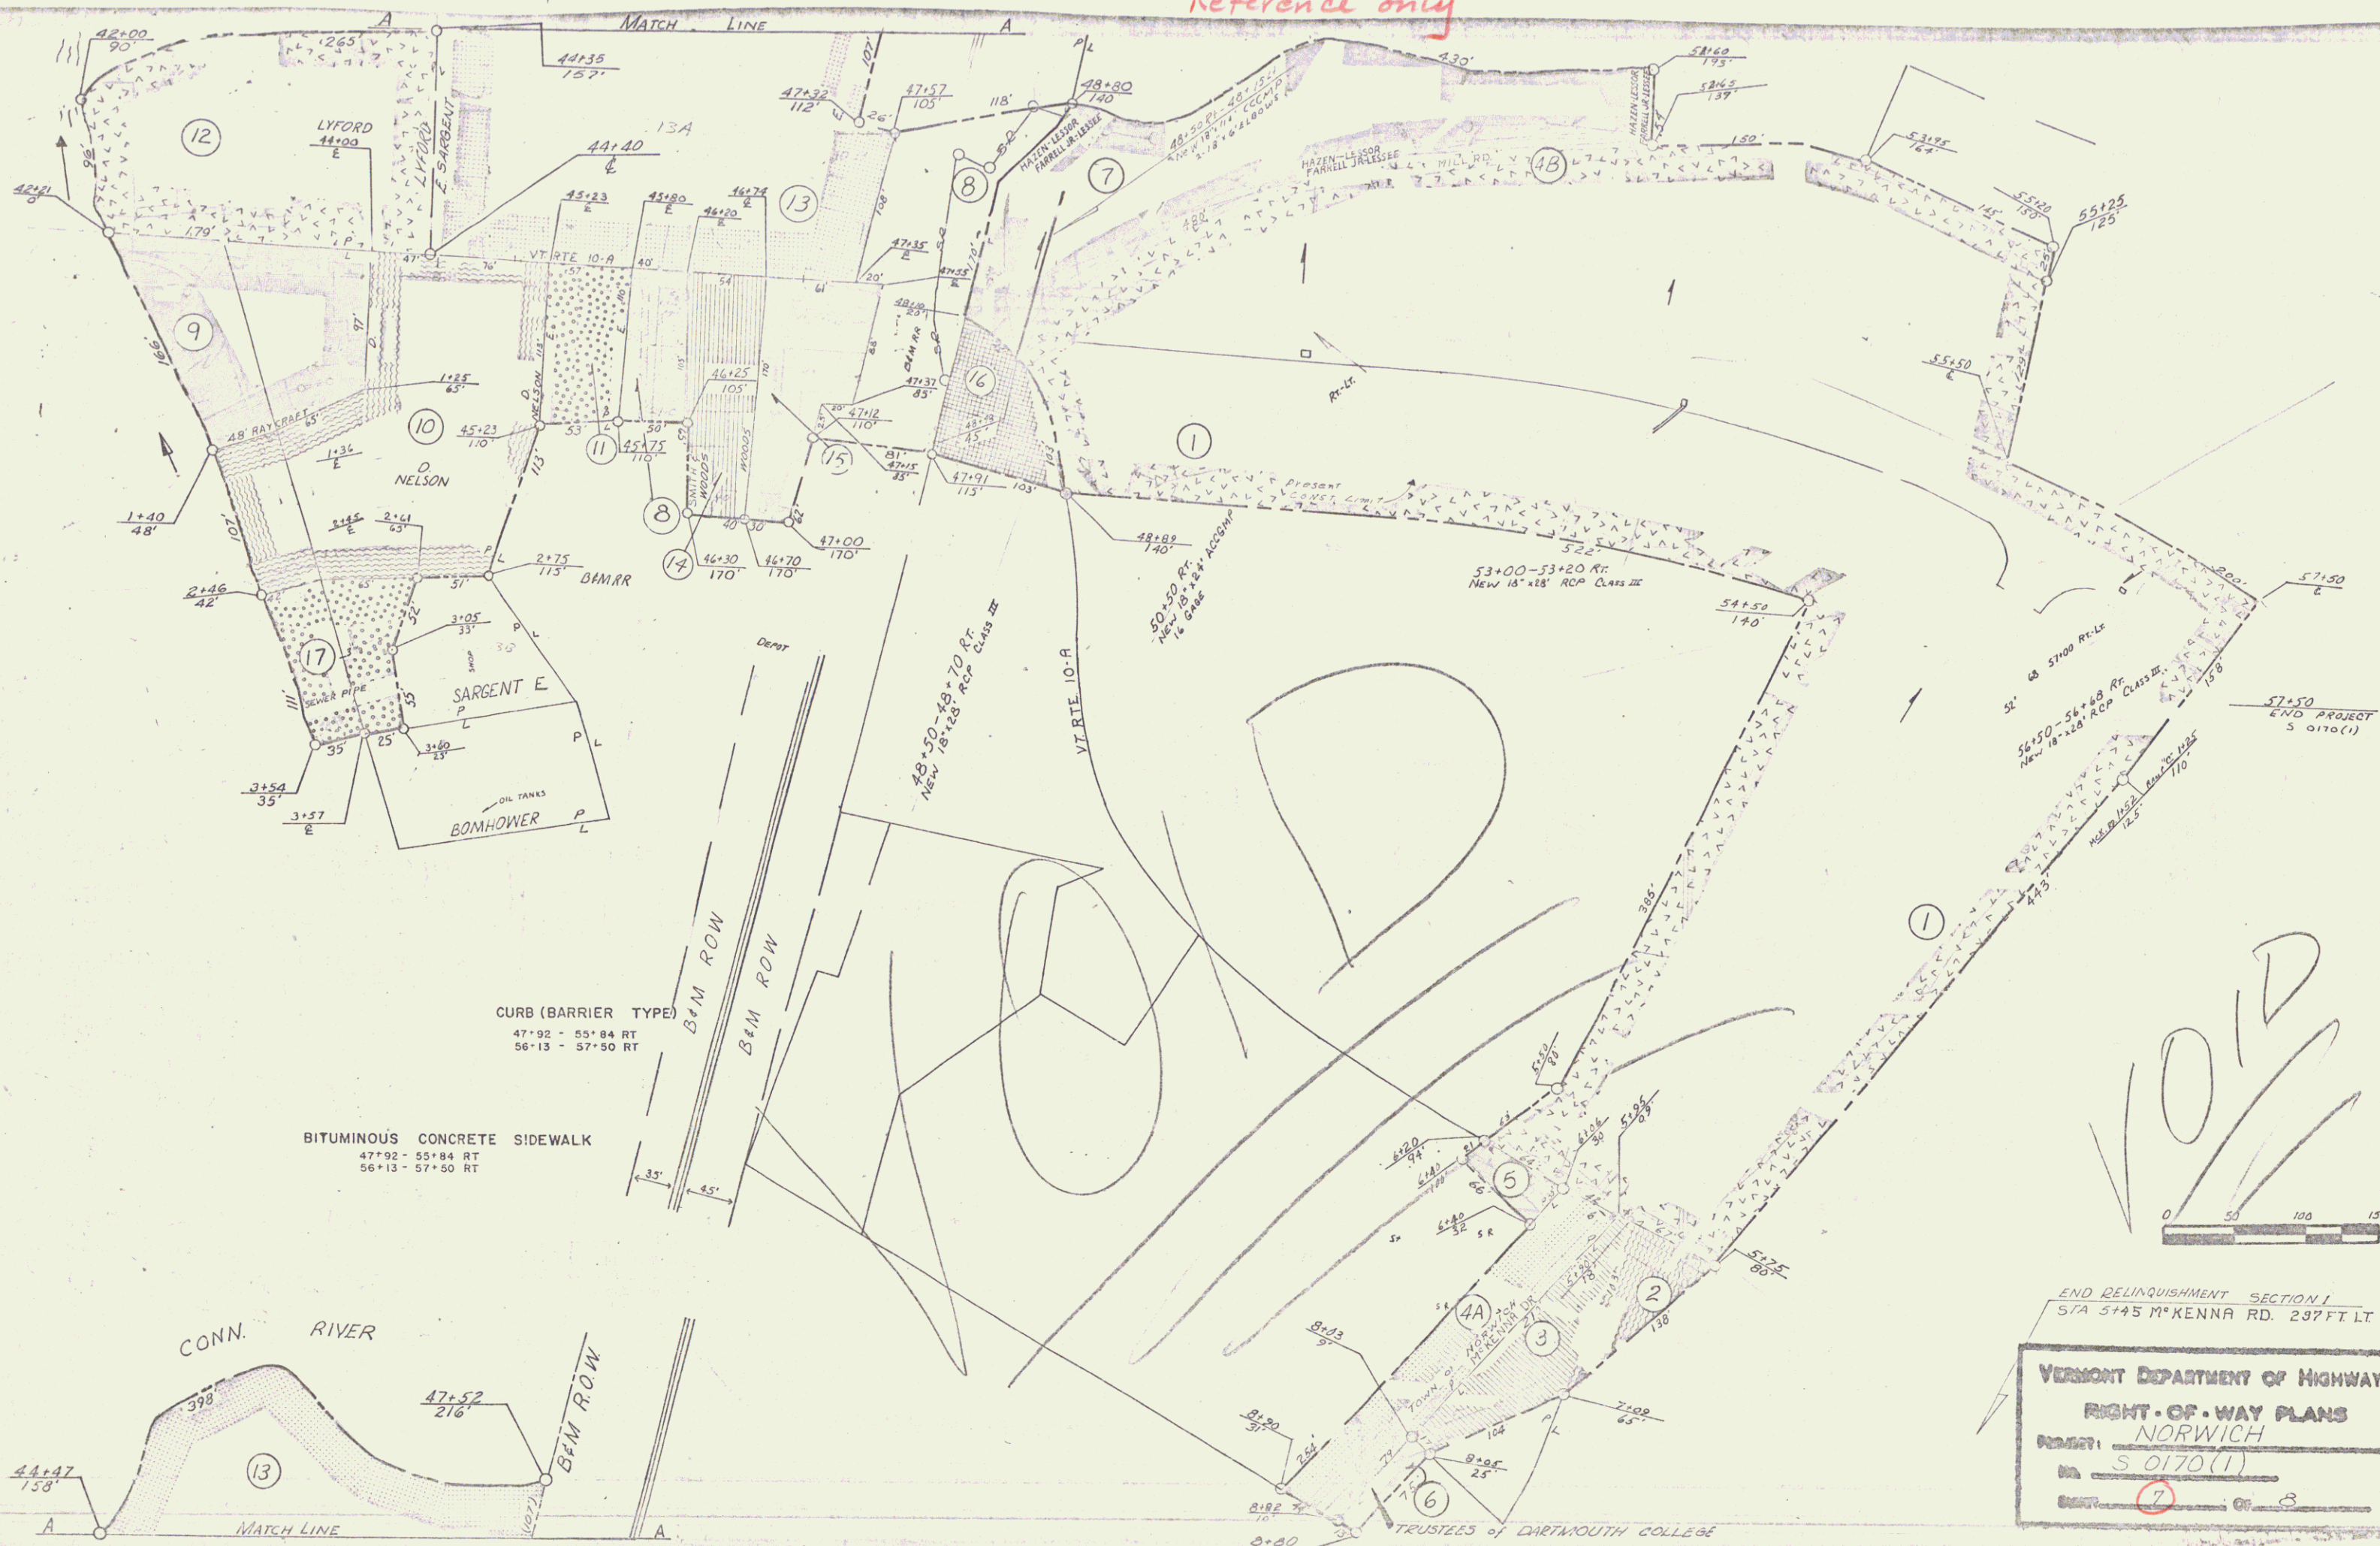

CURB (BARRIER TYPE)
 47+92 - 55+84 RT
 56+13 - 57+50 RT

BITUMINOUS CONCRETE SIDEWALK
 47+92 - 55+84 RT
 56+13 - 57+50 RT

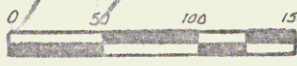

END RELINQUISHMENT SECTION 1
 STA 51+45 M'KENNA RD. 297 FT LT

VERMONT DEPARTMENT OF HIGHWAYS
 RIGHT-OF-WAY PLANS
 NUMBER: NORWICH
 NO. S 0170(1)
 SHEET 7 OF 3