

1. TITLE PAGE
2. TYPICAL SECTION OF IMPROVEMENT
3. DRAINAGE AND ITEM QUANTITY SHEET
4. EARTHWORK SHEET
5. PAVEMENT TRANSITION SHEET
6. LAYOUT & PROFILE SHEETS
7. A-6-1 SOLID ROCK EXCAVATION
8. B-1 BANKING TABLES
9. B-5 TYPICAL SLOPE GRADING
10. D-2 HEADWALLS
11. D-3 JUTE MATTING
12. D-4 ELBOWS & FLUSHING BASINS
13. D-8 DROP INLETS
14. D-13 CONCRETE CATCH BASIN
15. E-1 BARRICADES SIGNS AND LIGHTS
16. E-3 CONSTRUCTION IDENTIFICATION SIGNS
17. G-4 PLANK GUARD RAIL
18. J-1 PROJECT & BOUNDARY MARKERS
19. BLANK
- 20-32 CROSS SECTIONS

STATE OF VERMONT
DEPARTMENT OF HIGHWAYS

PROPOSED IMPROVEMENT

POOR ORIGINAL COPY

TOWN OF SPRINGFIELD
COUNTY OF WINDSOR
VT. ROUTE II
CHARLESTOWN, N.H. - SPRINGFIELD, VT ROAD

PROJECT NAME & NUMBER TYPE PA.V. AREA
SPRINGFIELD F 016-2(3) BIT. CONC. PAVT. 2.311 S.Y.
RECORD PLANS
MATERIALS

BEGINNING AT A POINT 0.805 MILE WESTERLY OF THE N.H.-VT. BOUNDARY AND EXTENDING NORTHWESTERLY 0.076 MILE.
LENGTH OF PROJECT 400 FEET = 0.076 MILE


ADT 1958	3770
ADT 1975 (EST)	7570
DIV 1975	1100
D	60%
T	6%

Pin# 99R855

SUBBASE OF GRAVEL - VEIRZICKI PIT - CHARLESTOWN, N.H.
SUBBASE OF CRUSHED ROCK & CRUSHED STONE SHOULDERS -
- PADDOCK QUARRY - SPRINGFIELD, VT.
PLANT MIXED GRAVEL BASE COURSE - L.A. HIK (PLANT) - WEST LEBANON, N.H.
GRAVEL BACKFILL - FISK PIT - CHARLESTOWN, N.H.
PEA STONE & STONE GRITS - BASSO QUARRY (PERINI CRUSHER) - SPRINGFIELD, VT.
REFINED TAR - WITCO CHEMICAL CO. - CAMBRIDGE, MASS.
ASPHALT - HUMBLE OIL & REFINING CO. - EVERETT, MASS.
BITUMINOUS CONCRETE PAVT. - L.A. HIK (PLANT) - W. LEBANON, N.H. & COLD RIVER SAND AND GRAVEL CORR. - NO. VALPOLE, N.H.
CONCRETE CLASS B - CHARLESTOWN READY MIX INC. - CHARLESTOWN, N.H.
REINFORCING STEEL - BETHLEHEM STEEL CO. - ALBANY, N.Y.
REINFORCED CONCRETE PIPE - HUME PIPE CO. OF NEW ENGLAND INC. - WINDSOR, VT.
METAL PIPE CULVERTS - WORTHESTER CULVERT CORP. - WESTMINSTER, VT.
PLANK GUARD RAIL & STEEL MARKER POSTS - S.T. GRISWOLD & CO. INC. - WILLISTON, VT.

CONTRACTOR - PERINI CORPORATION
FRAMINGHAM, MASS.
CHIEF RES. ENG. - FERNARD C. FOSTER.
RES. ENGINEER - SAMUEL T. MORRIS.
INSPECTORS - R. TOWNS, F. WIMBLE, B. F. NYE.
RECORD PLANS - A. S. SPIDLE.

CONTRACT DATED - DECEMBER 20, 1963.
STARTED - DECEMBER 20, 1963.
COMPLETED - AUGUST 3, 1965.
ACCEPTED - AUGUST 3, 1965.

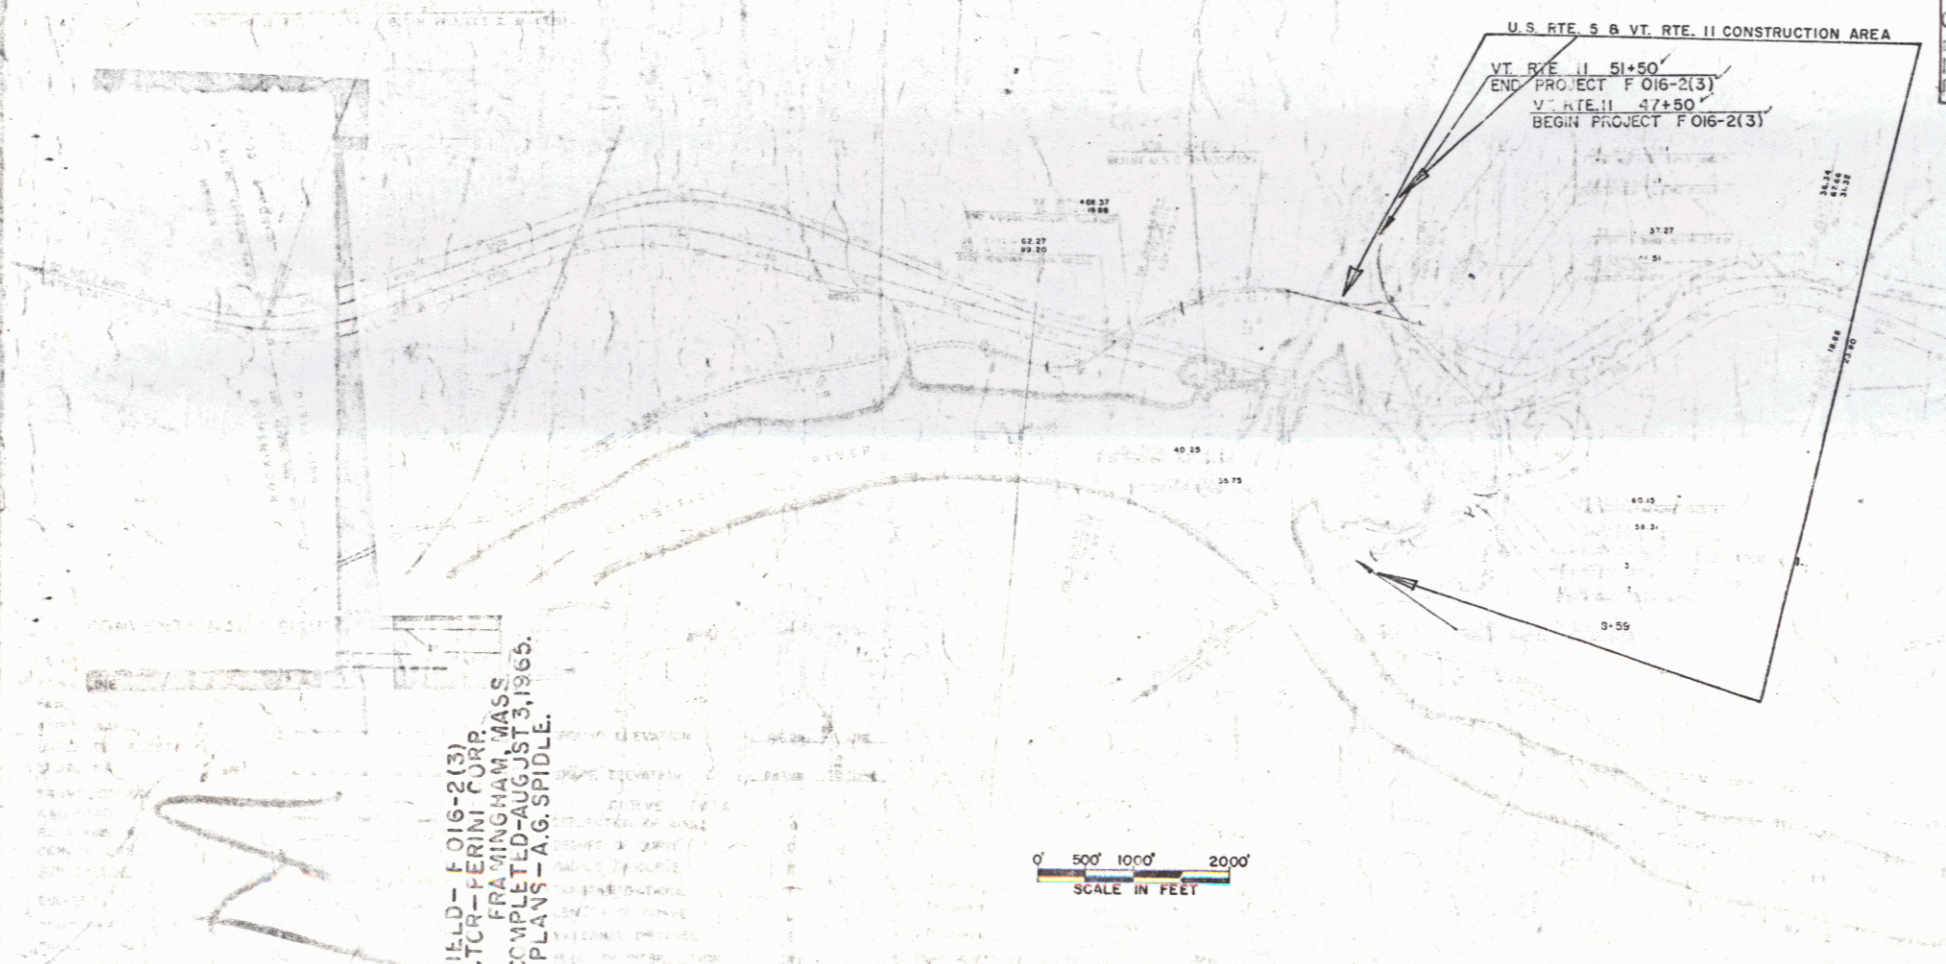

RIGHT-OF-WAY DIVISION
TOWN FILE
PERPETUAL
Town of VT II
(To Be Returned To R.O.W. Division)

SPRINGFIELD - F 016-2(3)
CONTRACTOR - PERINI CORP.
FRAMINGHAM, MASS.
CONSTR. COMPLETED - AUGUST 3, 1965.
RECORD PLANS - A. S. SPIDLE.

0 500' 1000' 2000'
SCALE IN FEET

E. B. Buckley 1/14/62
L. D. B. out 3/14/62
J. S. Chase 3-30-62
L. M. Lane 3/14/62
A. S. Spidle 3/14/62

F 016-2(3)
STAGE 1 CONSTRUCTION
32