

POOR ORIGINAL COPY

Conk Spring, Ditch, New, No. 13
01-20-2000


DEMOLITION AND REMOVAL OF BUILDINGS
ITEM 586
STA. 48+20 RT. NO. 1

EXCAVATION AND REMOVAL OF ROAD SURFACE
ON ROADWAYS, ITEM 18-2
47+50 - 51+80 LT.

PANEL	1 3 4 5	STA. 47+50 - 51+80	RT. NO. 1
DATE	12-20-00		
BY	J. S. J.		
CHECKED			
TITLE TAKEN			
RECORDED			

BENCHING OF SLOPE, ITEM 101-A
STA 47+50 TO STA 52+50 RT.

DATE	12-20-00
BY	J. S. J.
CHECKED	
TITLE TAKEN	
RECORDED	

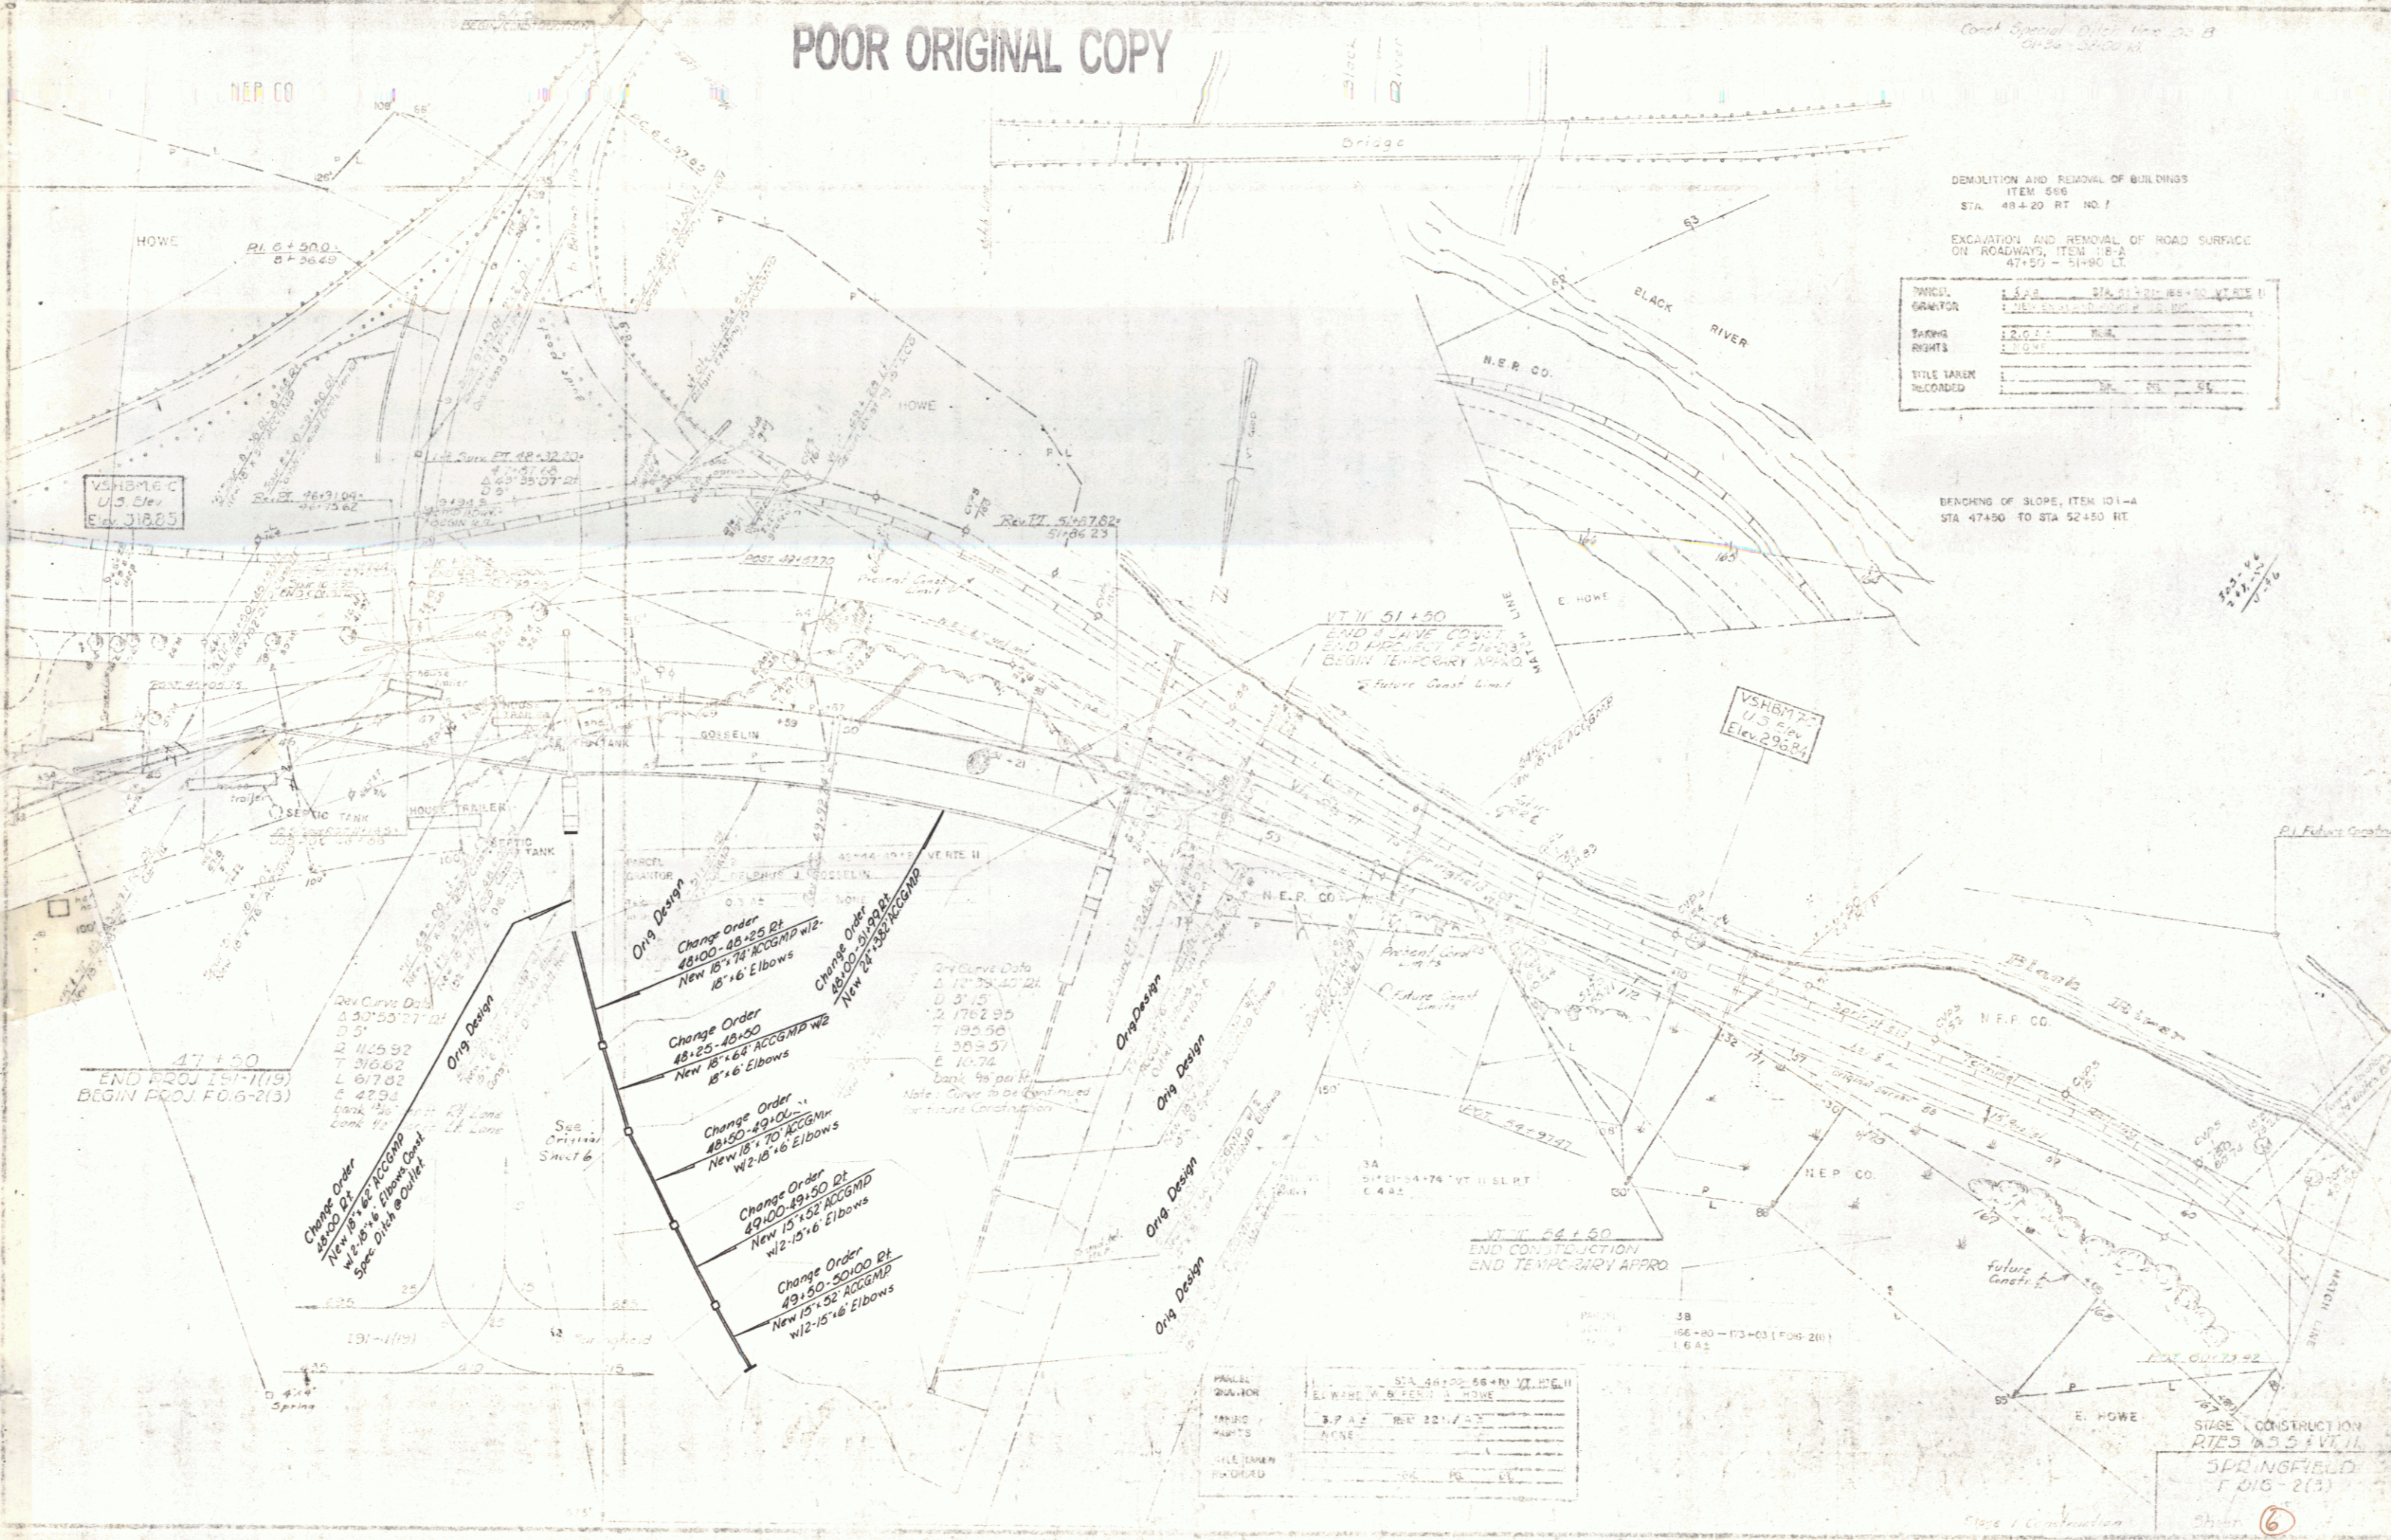

47+50
END PROJ 151-1(19)
BEGIN PROJ FD.6-2(13)

Change Order
48+00-48+25 Pt
New 15'-16" ACCGMB
New 15'-16" Elbows

Change Order
48+25-48+50
New 15'-16" ACCGMB
New 15'-16" Elbows

Change Order
48+50-49+00 Pt
New 15'-16" ACCGMB
New 15'-16" Elbows

Change Order
49+00-49+50 Pt
New 15'-16" ACCGMB
New 15'-16" Elbows

Change Order
49+50-50+00 Pt
New 15'-16" ACCGMB
New 15'-16" Elbows

CUT DATA

1	17.75	10.21
2	17.62	9.5
3	19.0	9.5
4	16.74	9.5

Note: Curve to be kept used for future construction

PANEL	1 3 4 5	STA. 47+50 - 51+80	RT. NO. 1
DATE	12-20-00		
BY	J. S. J.		
CHECKED			
TITLE TAKEN			
RECORDED			

STAGE CONSTRUCTION
RTES 103 & 51 VT. 11
SPRINGFIELD
12-20-00

Sheet 6