


PLAN  
 DATE 10/15/58  
 DRAWN BY H.Y.  
 CHECKED BY H.Y.  
 REVISIONS  
 1. 10/15/58  
 2. 10/15/58

PROFILE  
 DATE 10/15/58  
 DRAWN BY H.Y.  
 CHECKED BY H.Y.  
 REVISIONS  
 1. 10/15/58  
 2. 10/15/58

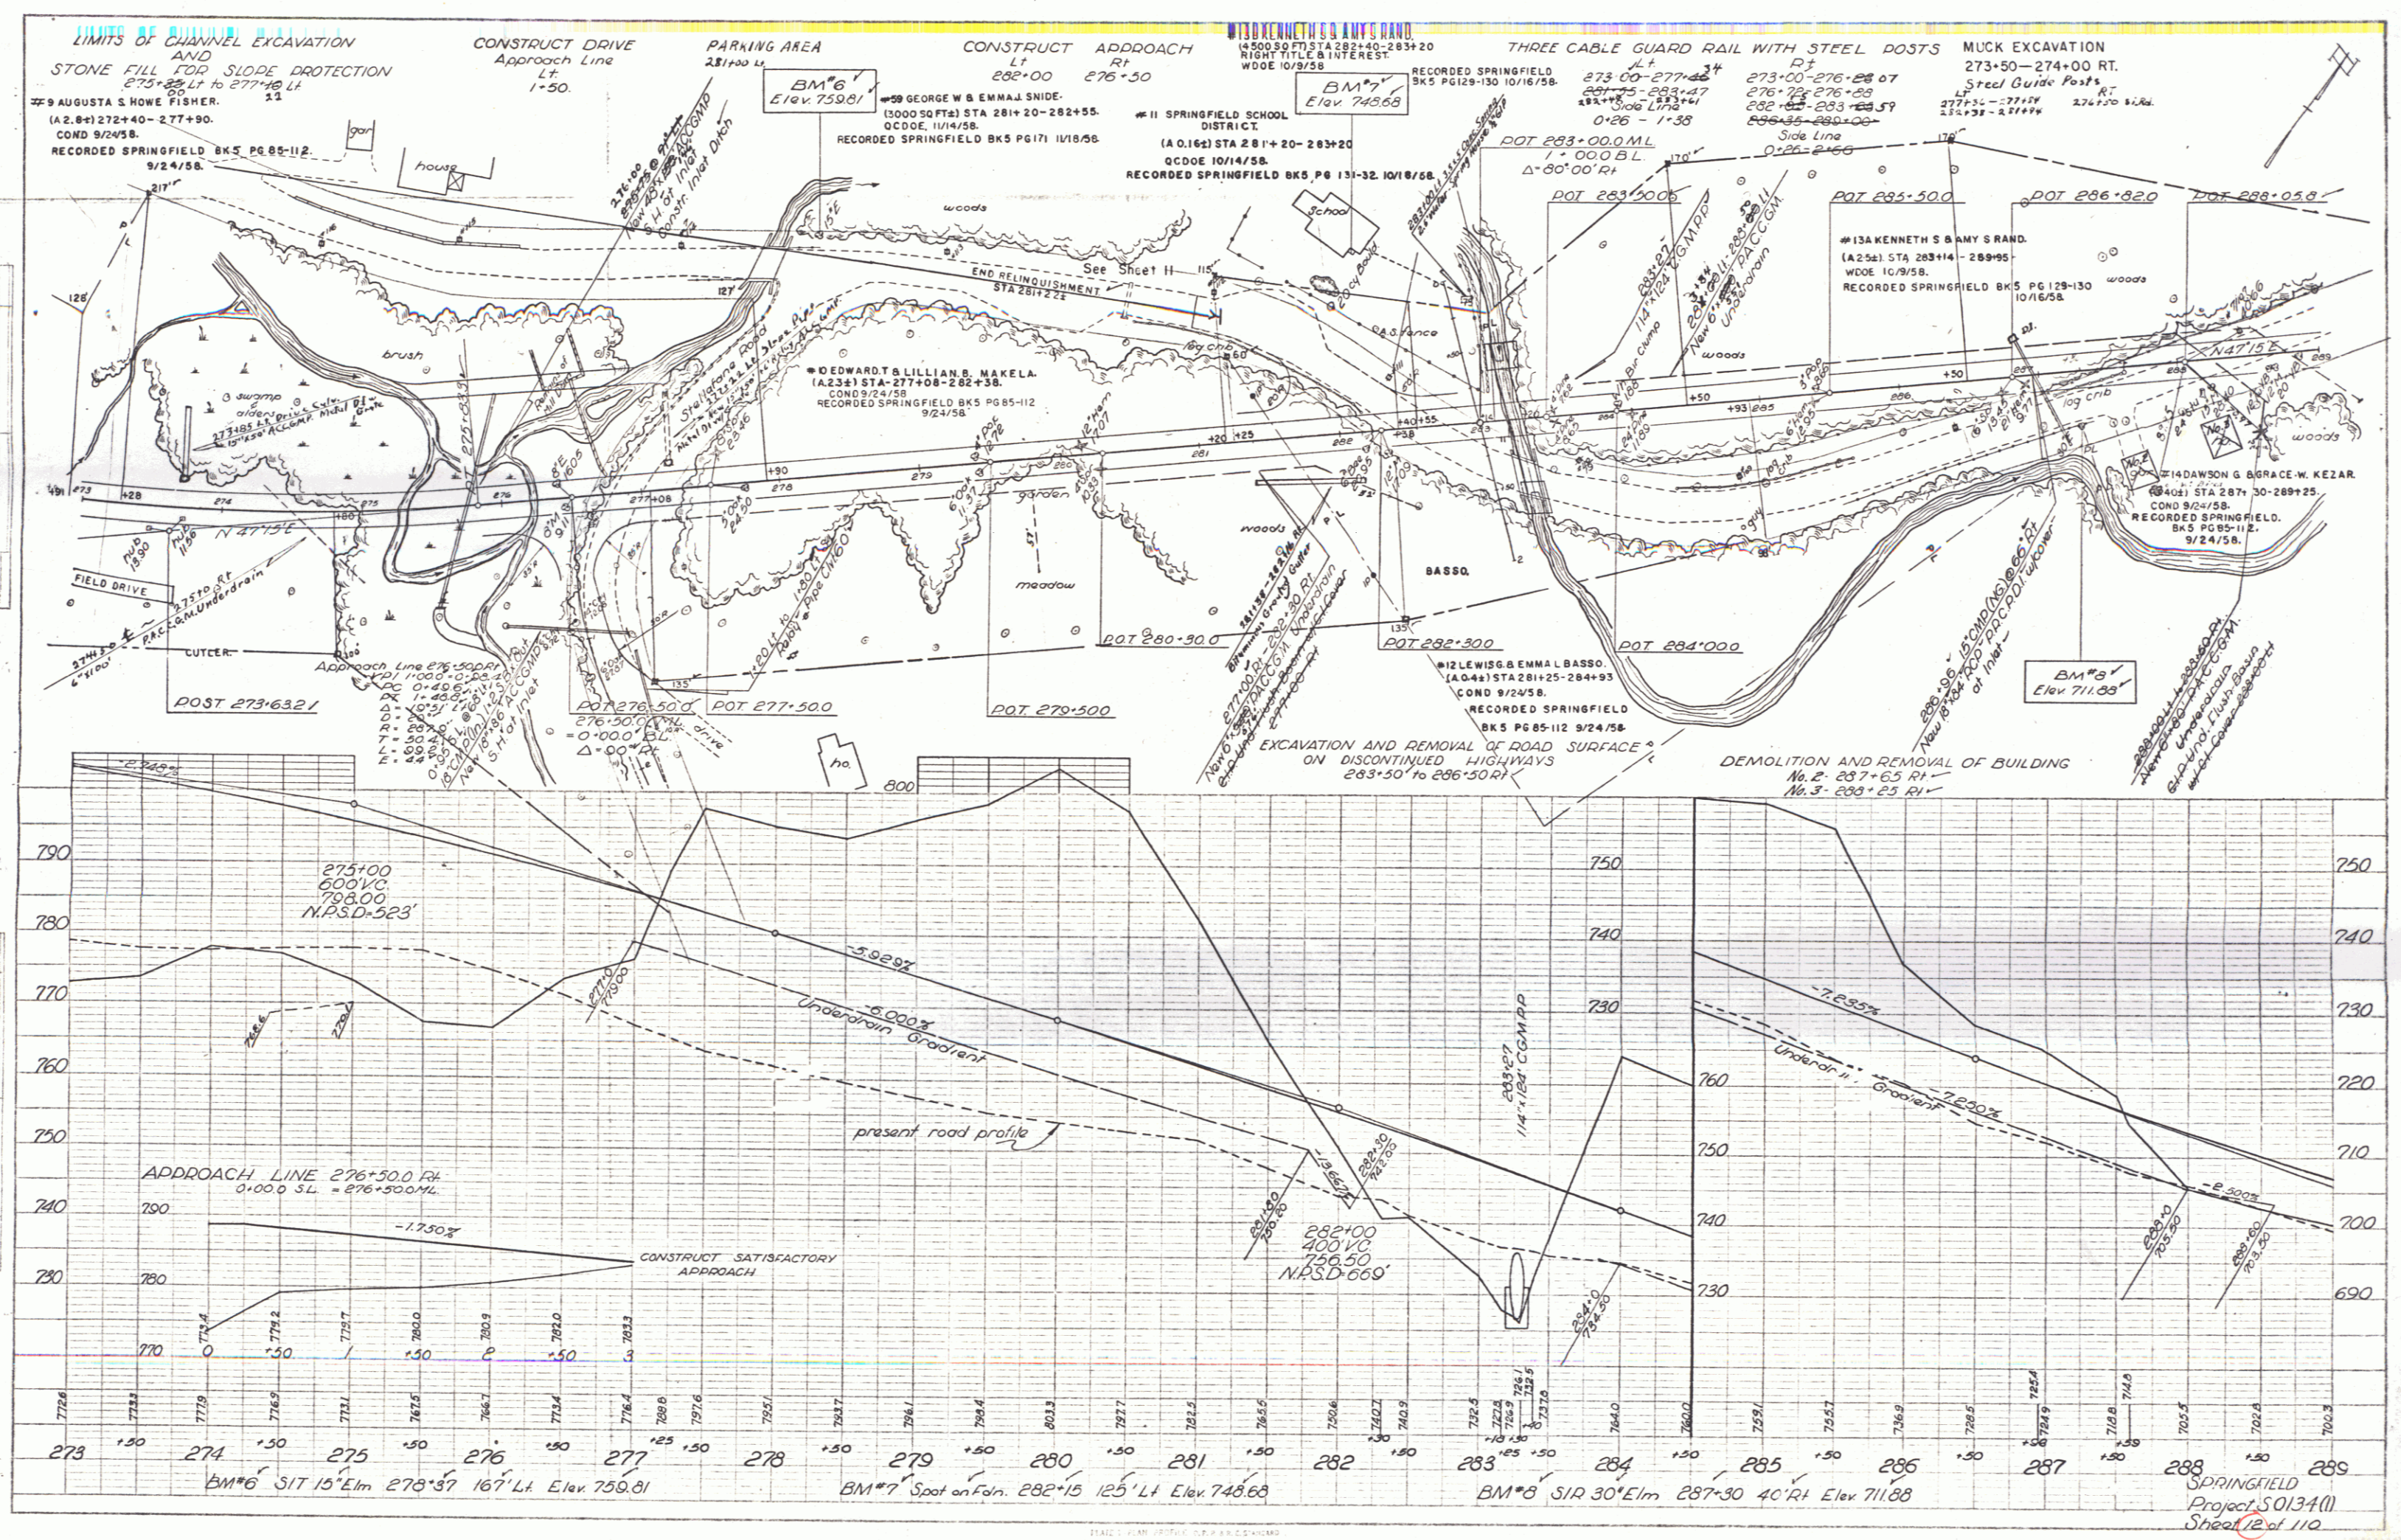

DATE: 10/15/58  
 DRAWN BY: H.Y.  
 CHECKED BY: H.Y.

SPRINGFIELD  
 Project S0134(M)  
 Sheet 12 of 110