

PLAN

DATE: 9/57

BY: [Signature]

SCALE: 1" = 40'

NOTE: SEE SHEET 0134 (I) FOR DETAILS.


PROFILE

DATE: 9/57

BY: [Signature]

SCALE: 1" = 40'

NOTE: SEE SHEET 0134 (I) FOR DETAILS.

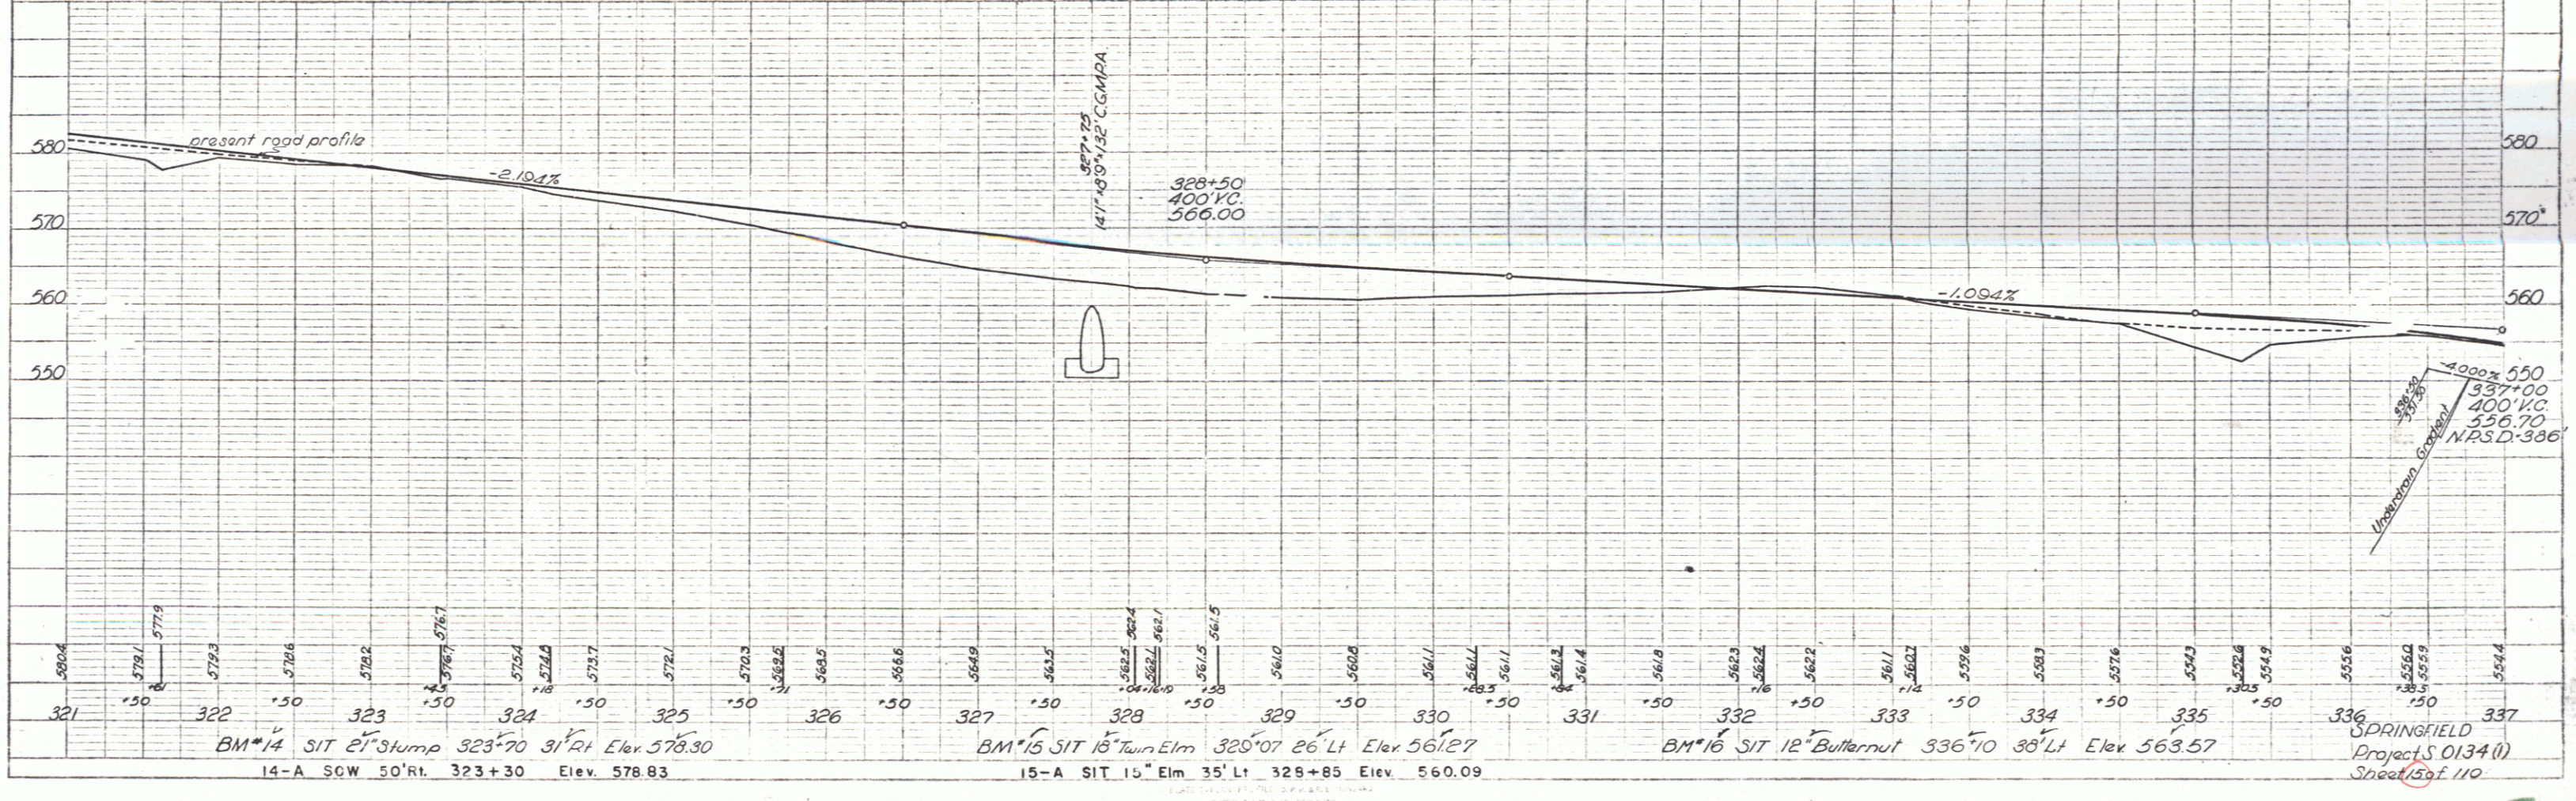

14-A SOW 50' RT. 323+30 Elev. 578.83

15-A SIT 15' Turn Elm 328+85 Elev. 560.09

16 SIT 12' Butternut 336+10 88' LT Elev. 563.57

SPRINGFIELD Project S 0134 (I) Sheet 0134 (I)