

Stone Fill for Stone Protection (Heavy) 500' 10491' - 514' 95+00-95+25.01 99+75-111+00.01  
 Gravel Excavation for Stone Stabilization 74m 222+4.00 99+75-103+00.01  
 Bituminous Concrete Gutter 17m 552 103+50-107+00.01


Three Concrete and Post with 2x4s 400' Item 542 95+00-111+00.01  
 Channel Excavation Items 105.44, 105.5 101+25-103+51

Removal and Disposal of Preset Guardrail Item 549 104+05-111+00.01  
 Demolition and Disposal of Building Item 536 102+00.01 104+00.01 42'

Aluminum Alloy Chain Link Fencing 116m 518 103+50-109+00.01

Galvanized Chain Link Fence 100m 501.8 Aluminum Alloy Chain Link Fence 17m 536.18 101+25-103+25.01 (East bank of river)

POOR ORIGINAL COPY

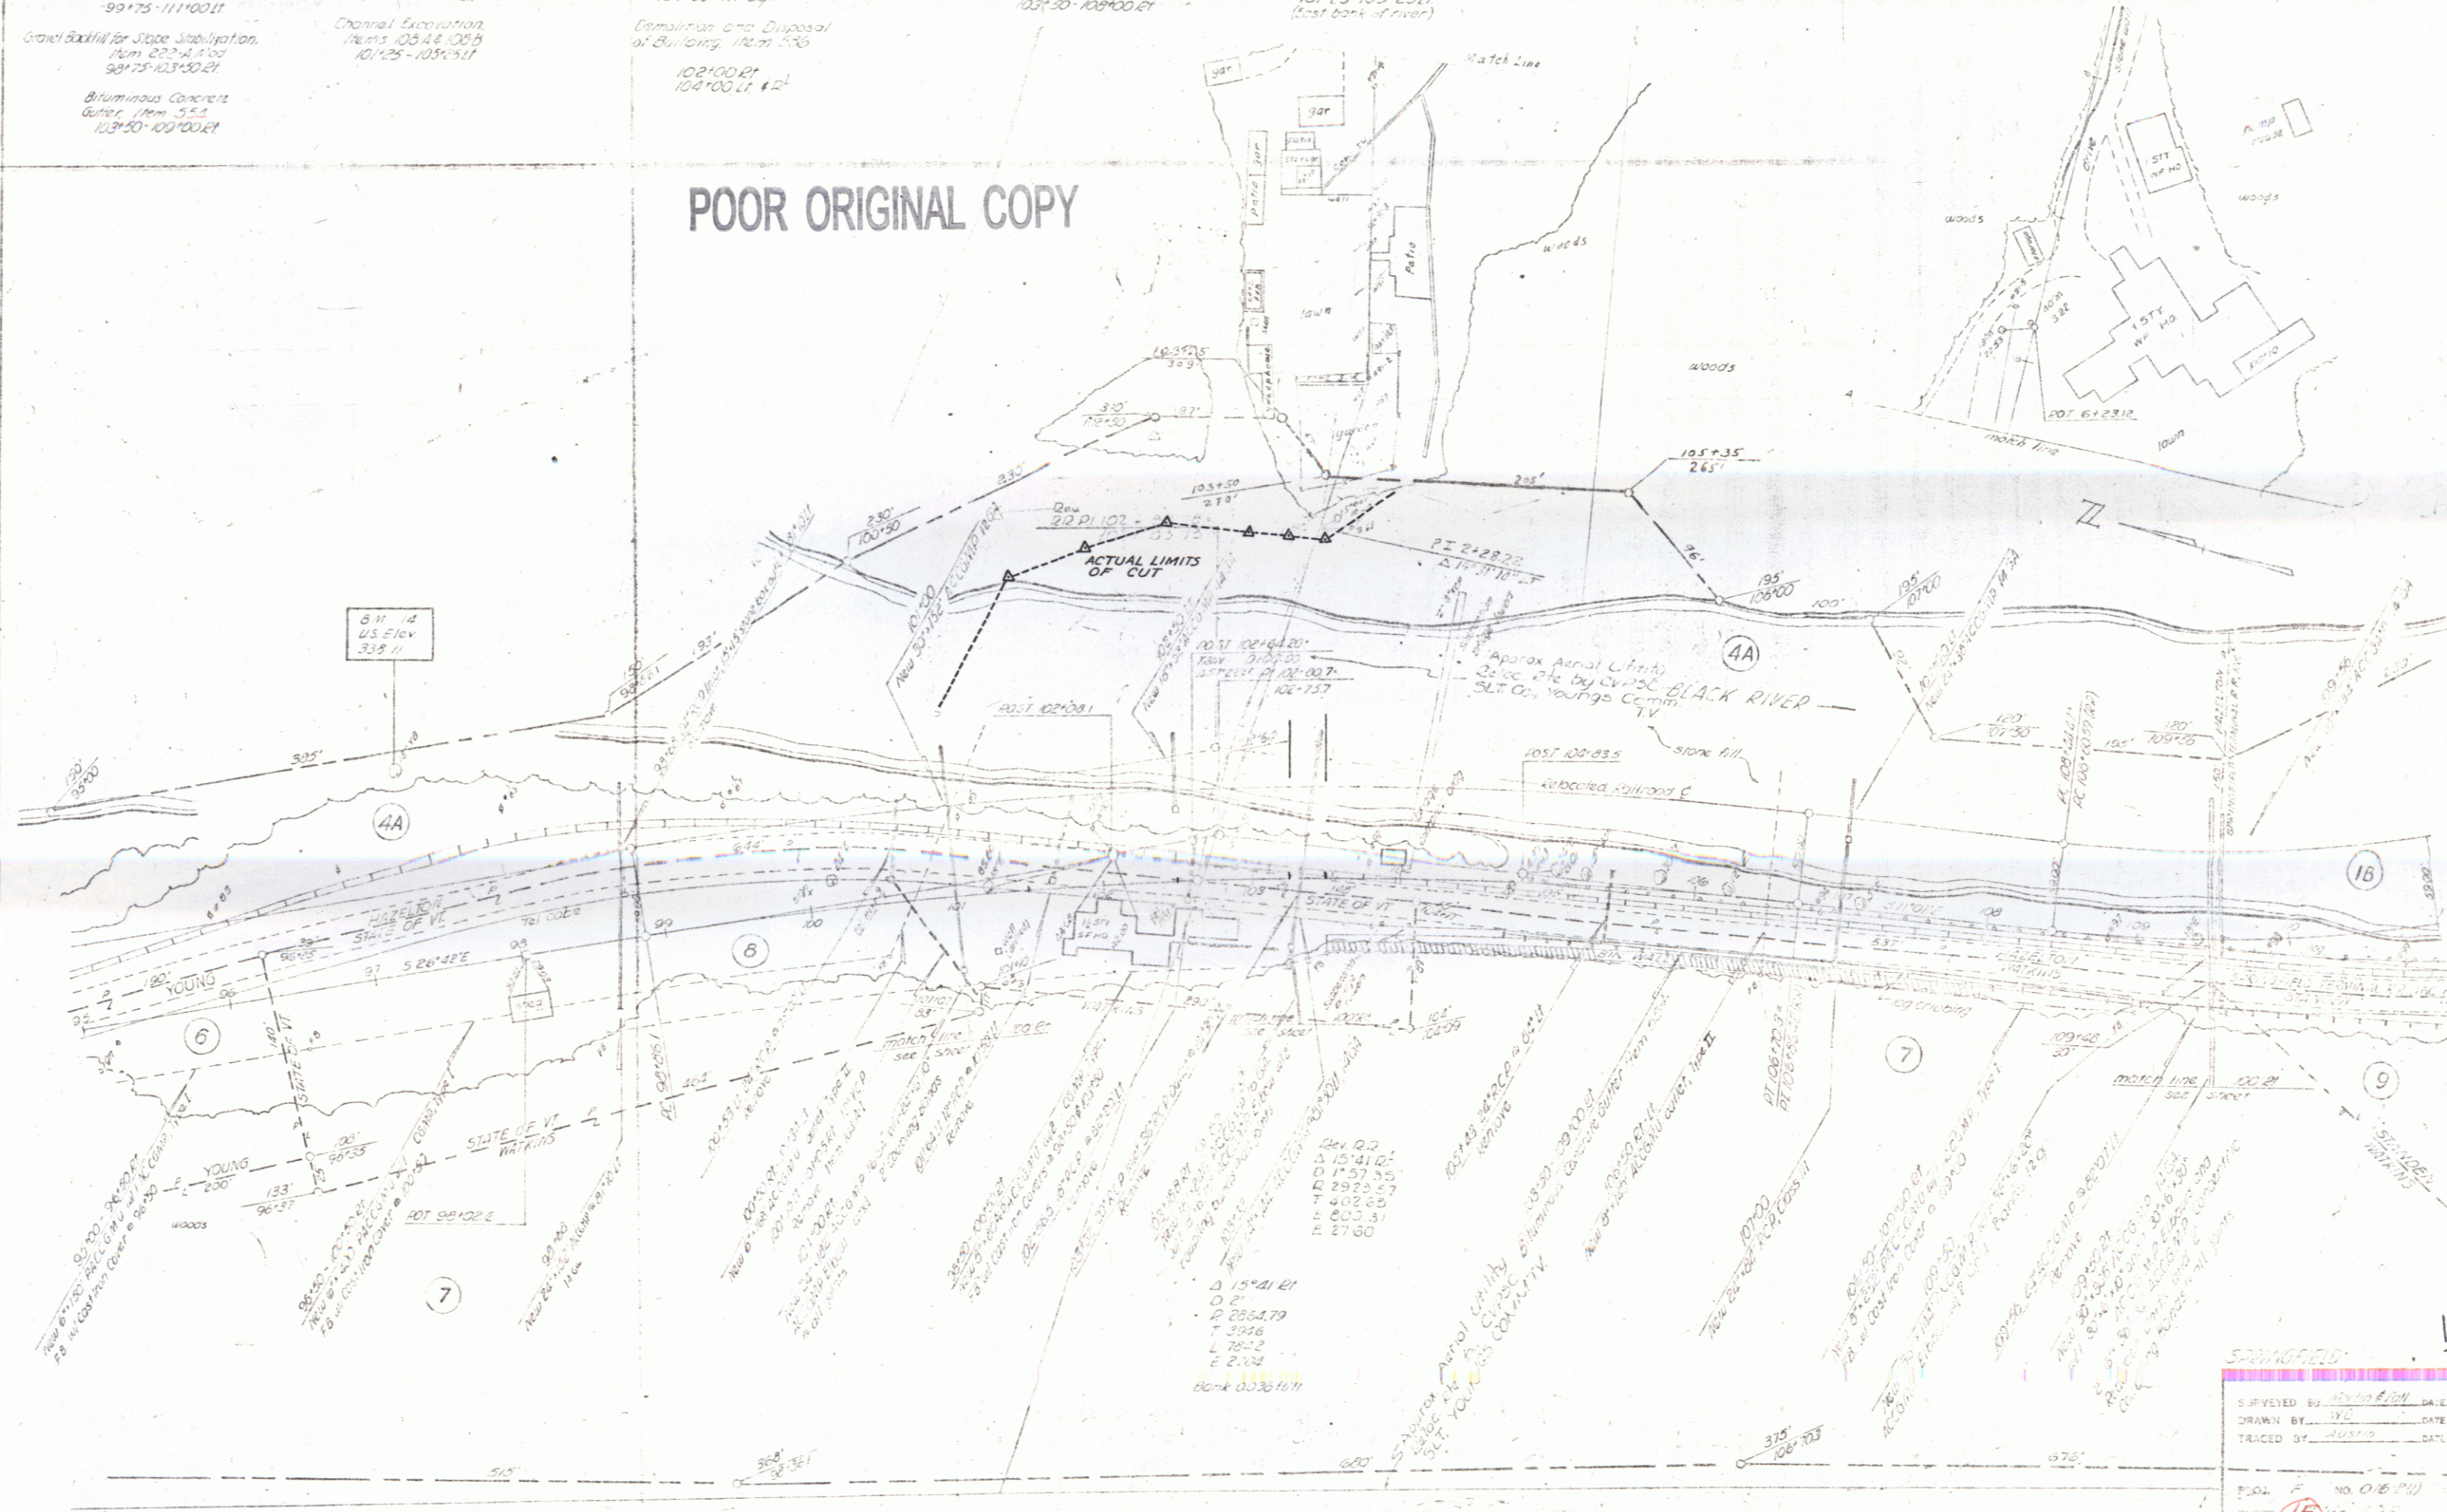

SPRINGFIELD

SURVEYED BY	DATE
DRAWN BY	DATE
TRACED BY	DATE

NO. 016 (11)  
 SHEET 15 OF 132