



POOR ORIGINAL COPY

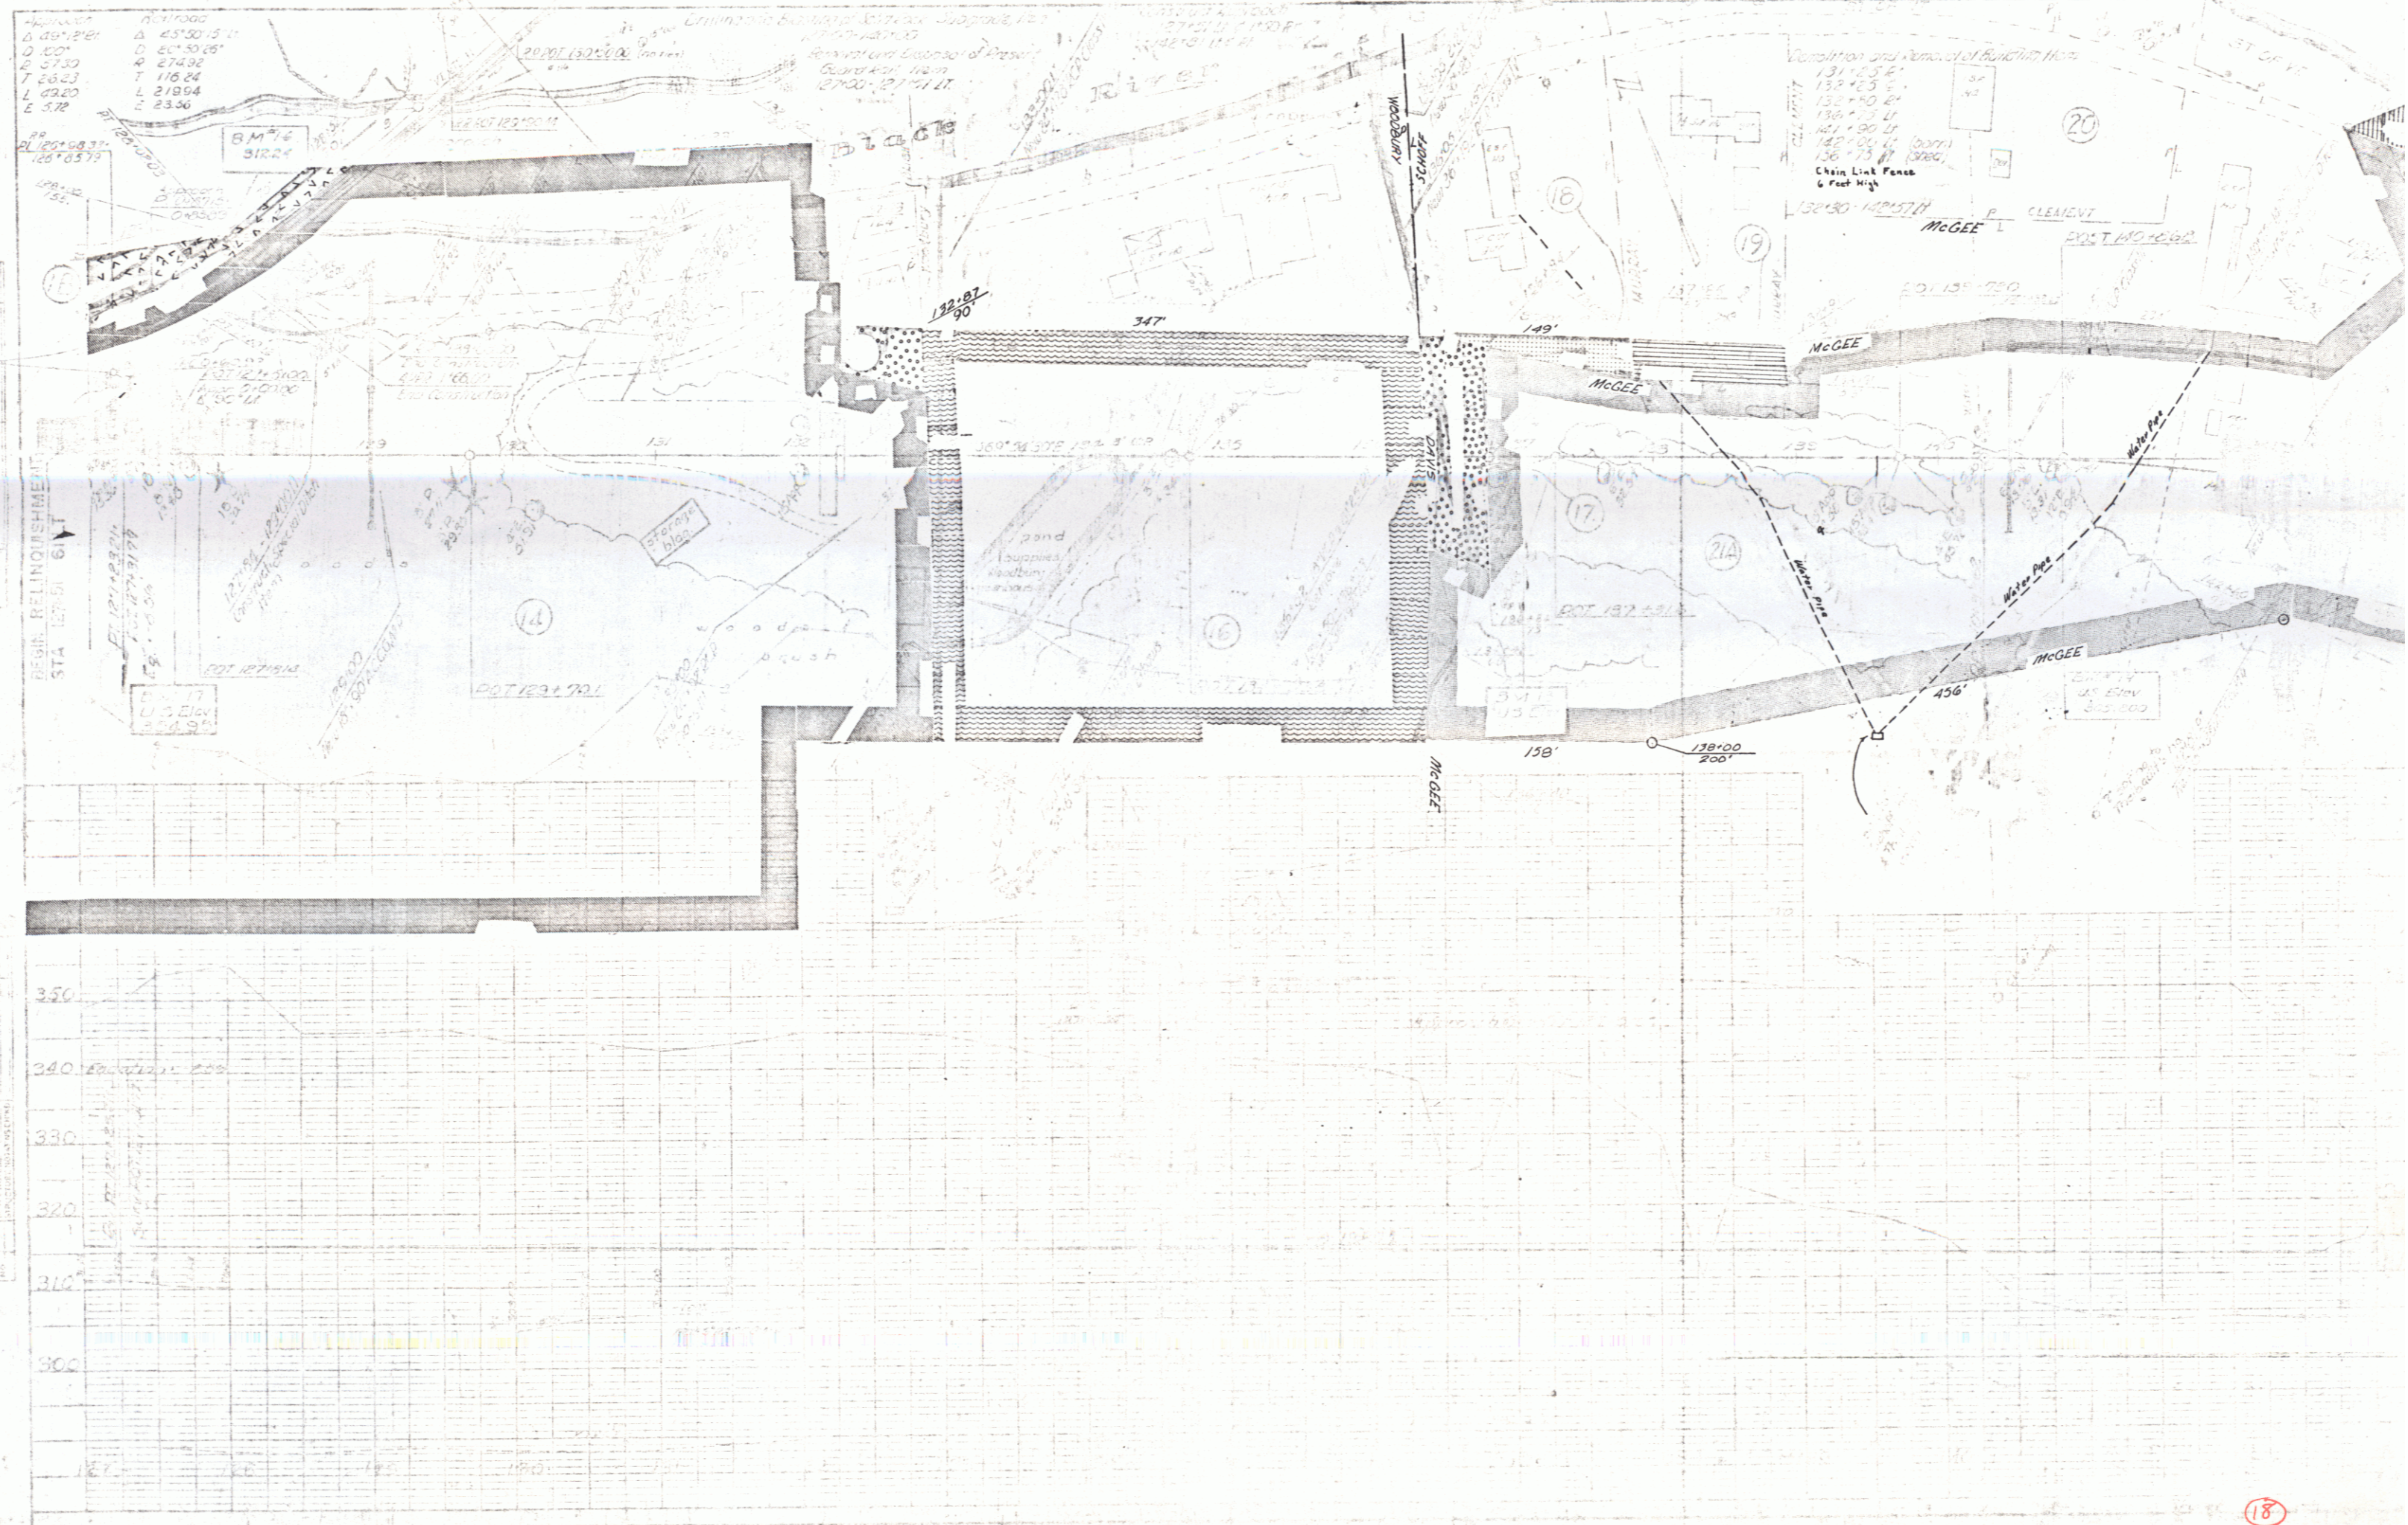

1	117000
2	45°50'15"
3	0°00'
4	27°30'
5	27°30'
6	116.84
7	116.84
8	23.36
9	23.36

RESURFACING
STA 127+51 61'

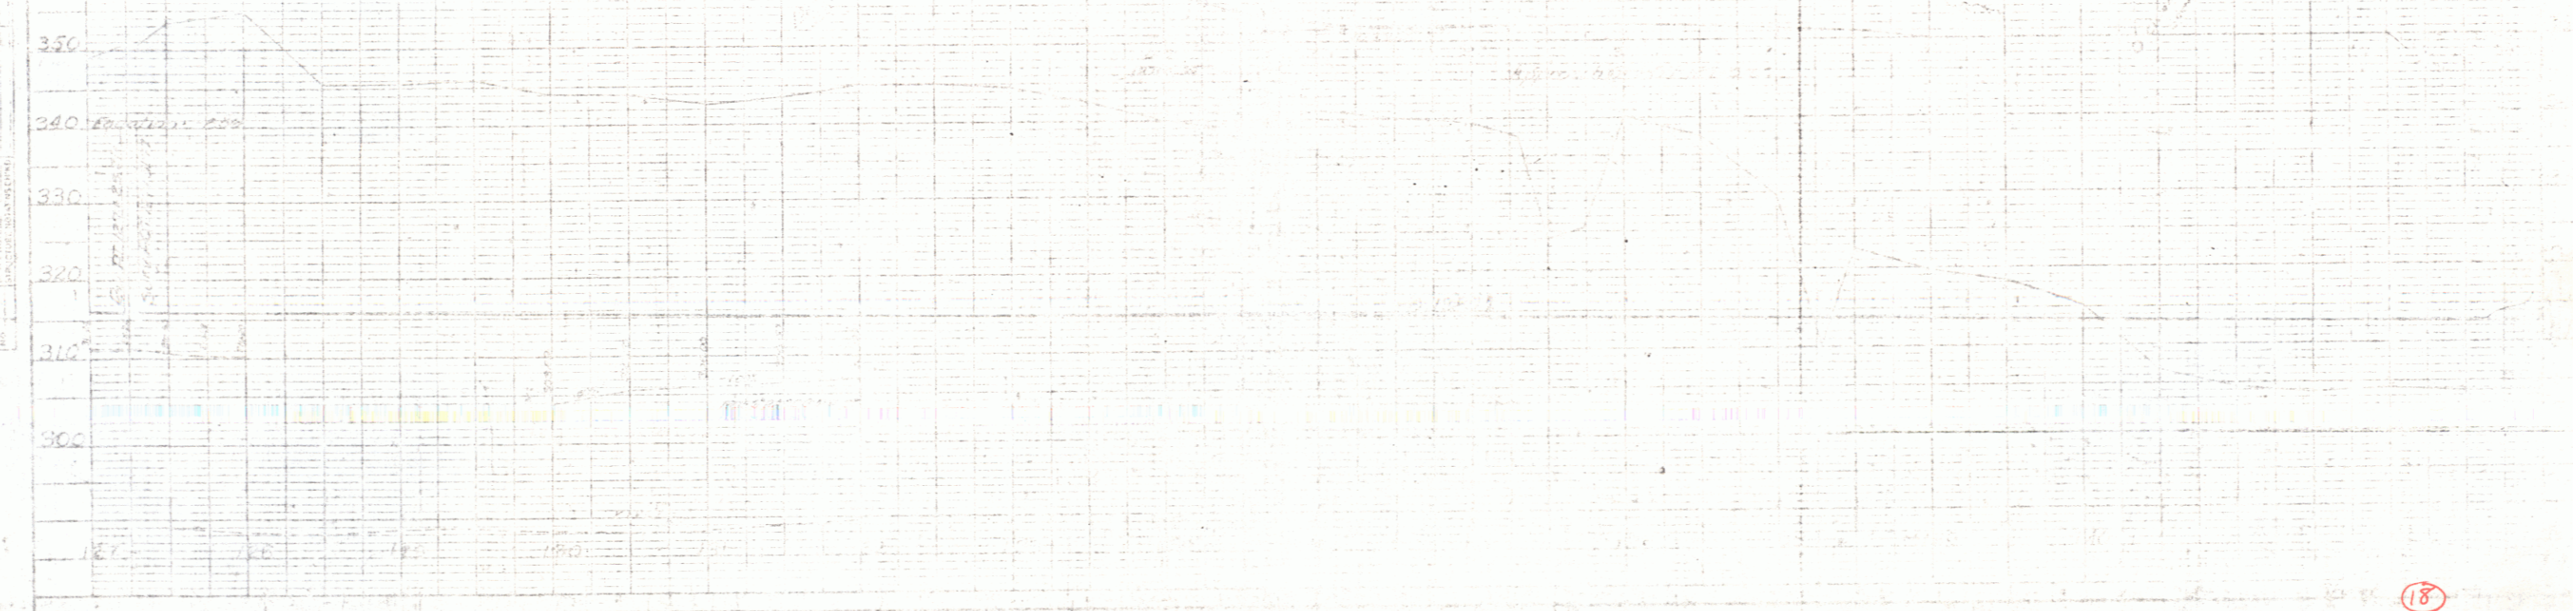

18

BRUGHT UP TO DATE ENR 64
AND